

RECEIVED

MAY 23 1994

WATER RIGHTS
SALE AND AGREEMENT

SE COR
Wm. SUTHERLAND
DLC No 44

69212

H 02153 R- 74462

SECTION NO

200
121.36 Ac.

100
120.00 Ac.

23.96

LOT 1

37.35

ELDER

4

210 S - 80 W - 25

CENTER
OF
SECTION


5

HARRY

501
29.82 Ac.

502
10.08 Ac.

500
38.70 Ac.

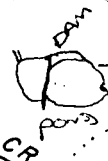

C.R.

600
30.89 Ac.

C. O. P. CO.

EASE PER V. 30/1974



C.S. 158-79

604
17.75 Ac.

C.S. 210-65

N 0° 20' E


CAMP

603
15.96 Ac.


605
12.89 Ac.

4

ROAD

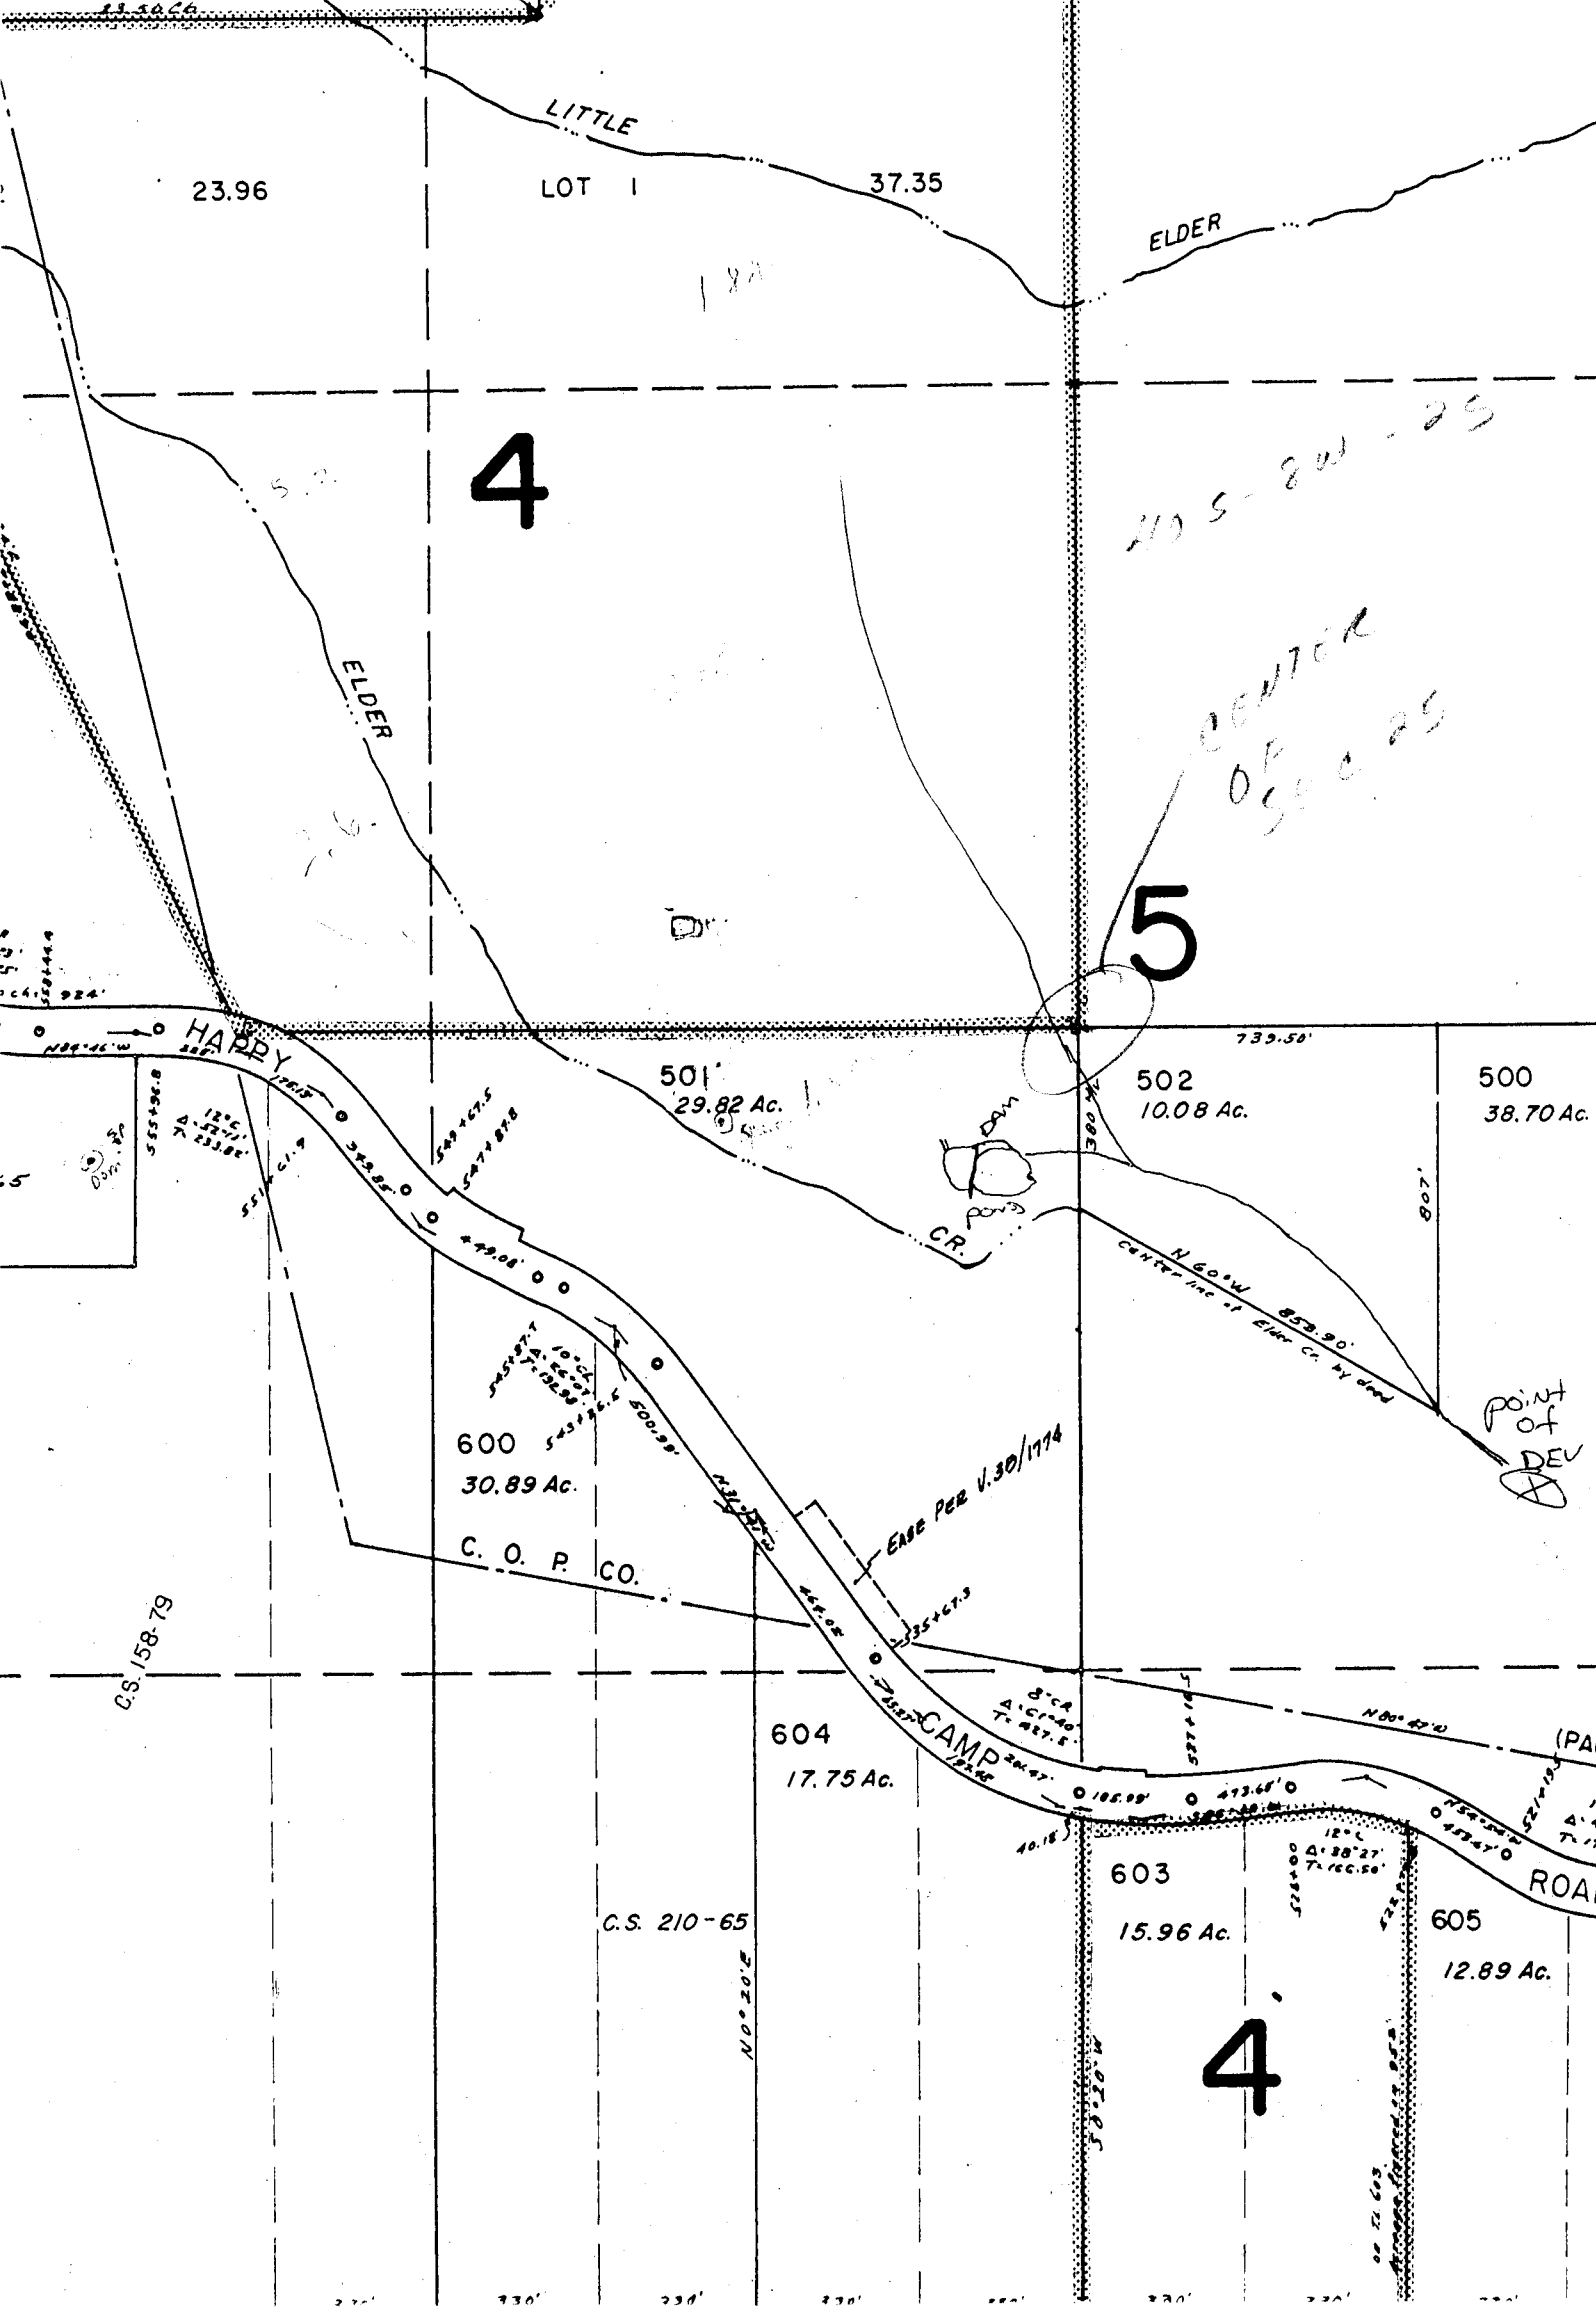

R74462

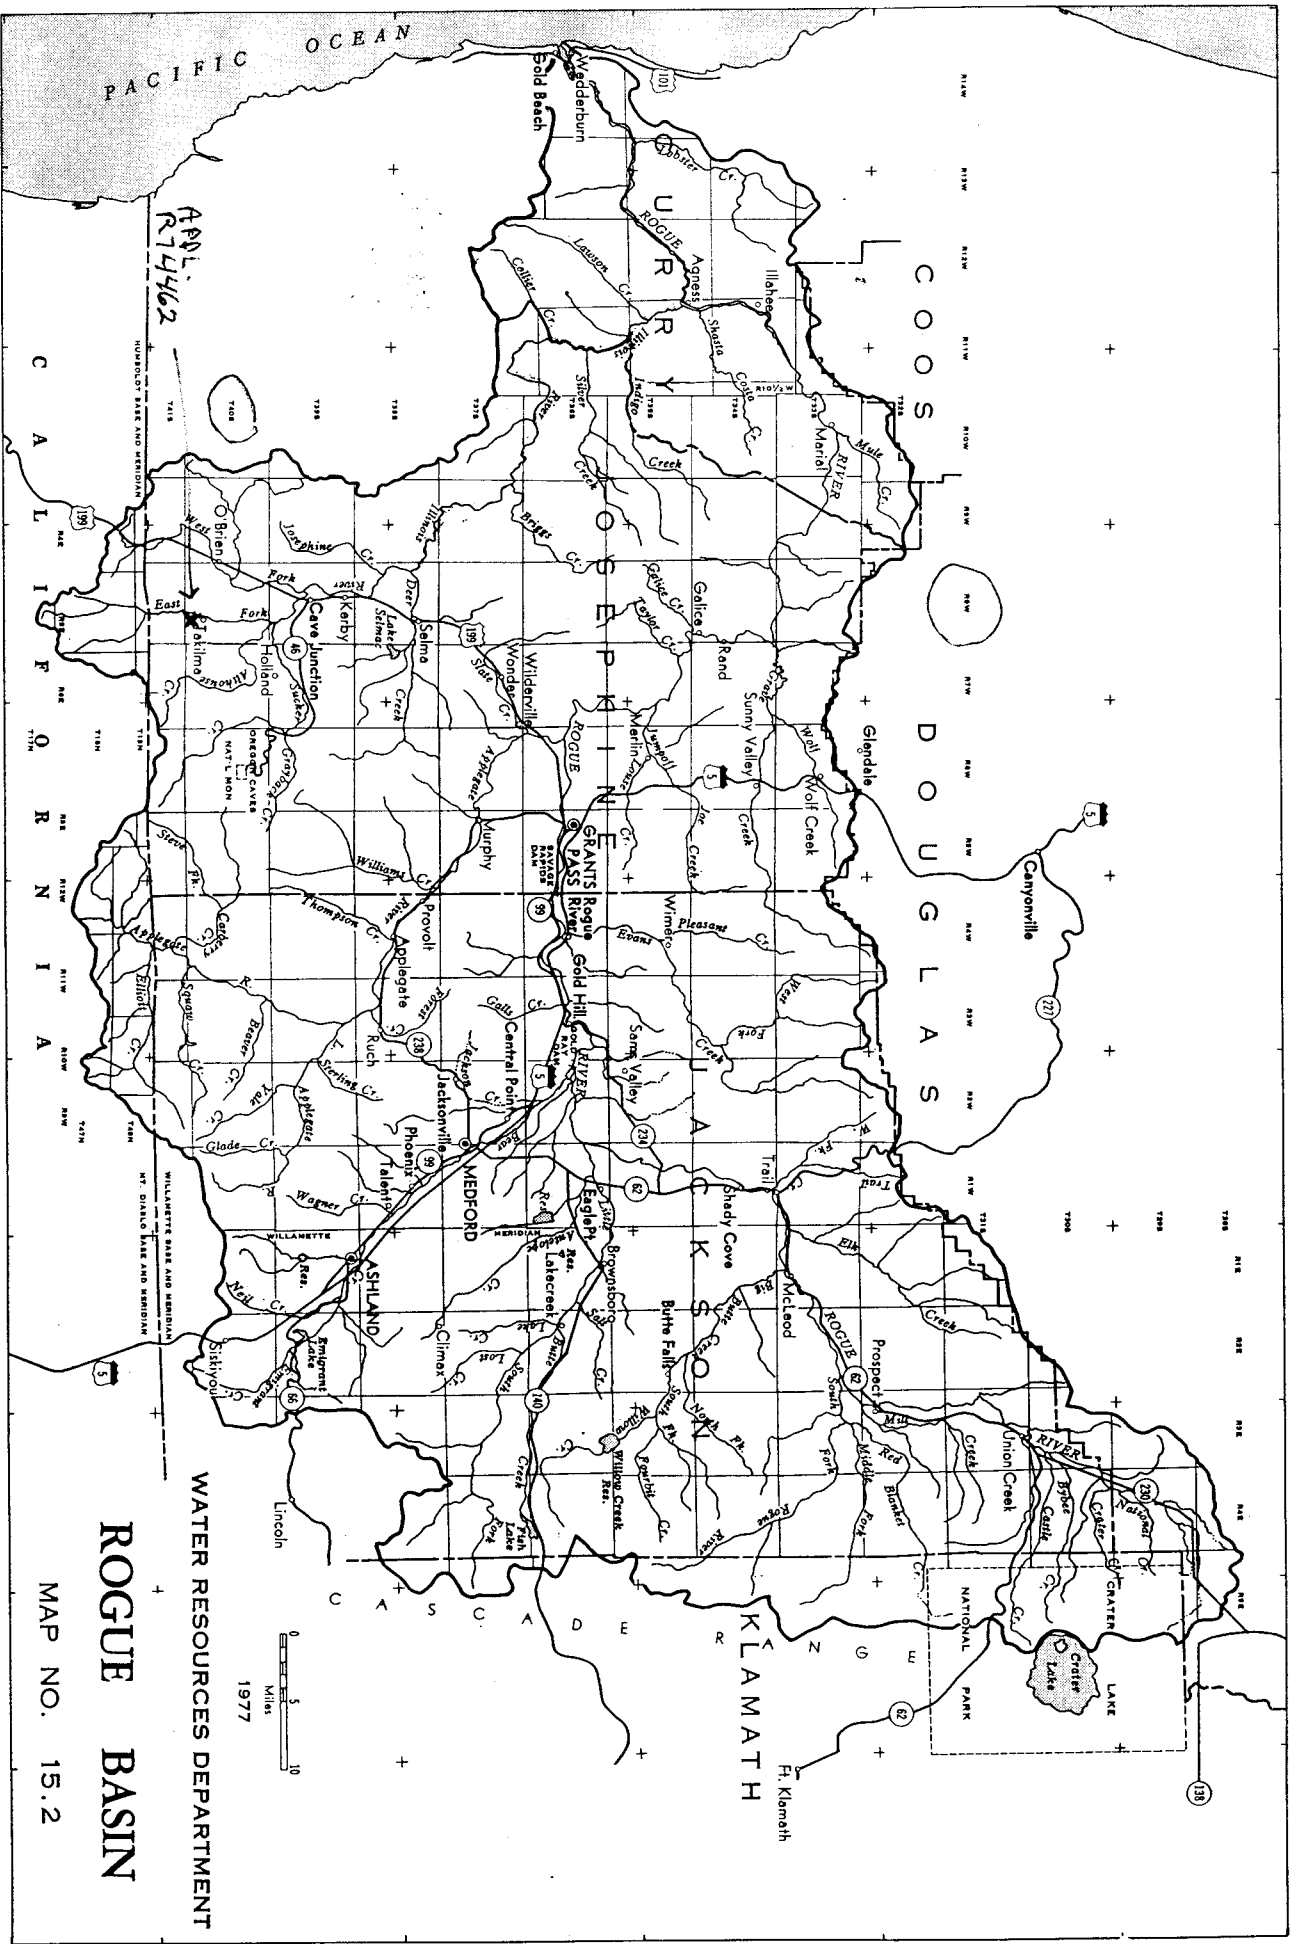

CERTIFICATE NO.

69212

Application No. R74462
Permit No.