


GLD 889 W


26

23

Courtesy of
 COMMERCIAL TILE CO.
 LOT 14 40.72
 This section is furnished for
 illustration and to assist in
 property located in the company
 Assure no liability for any
 variation in dimensions or loca-
 tion ascertainable by actual
 survey.
 Approximate Scale
 1 inch = 200 feet
 Sec 23 T 50 S R 4 W 11 M

N



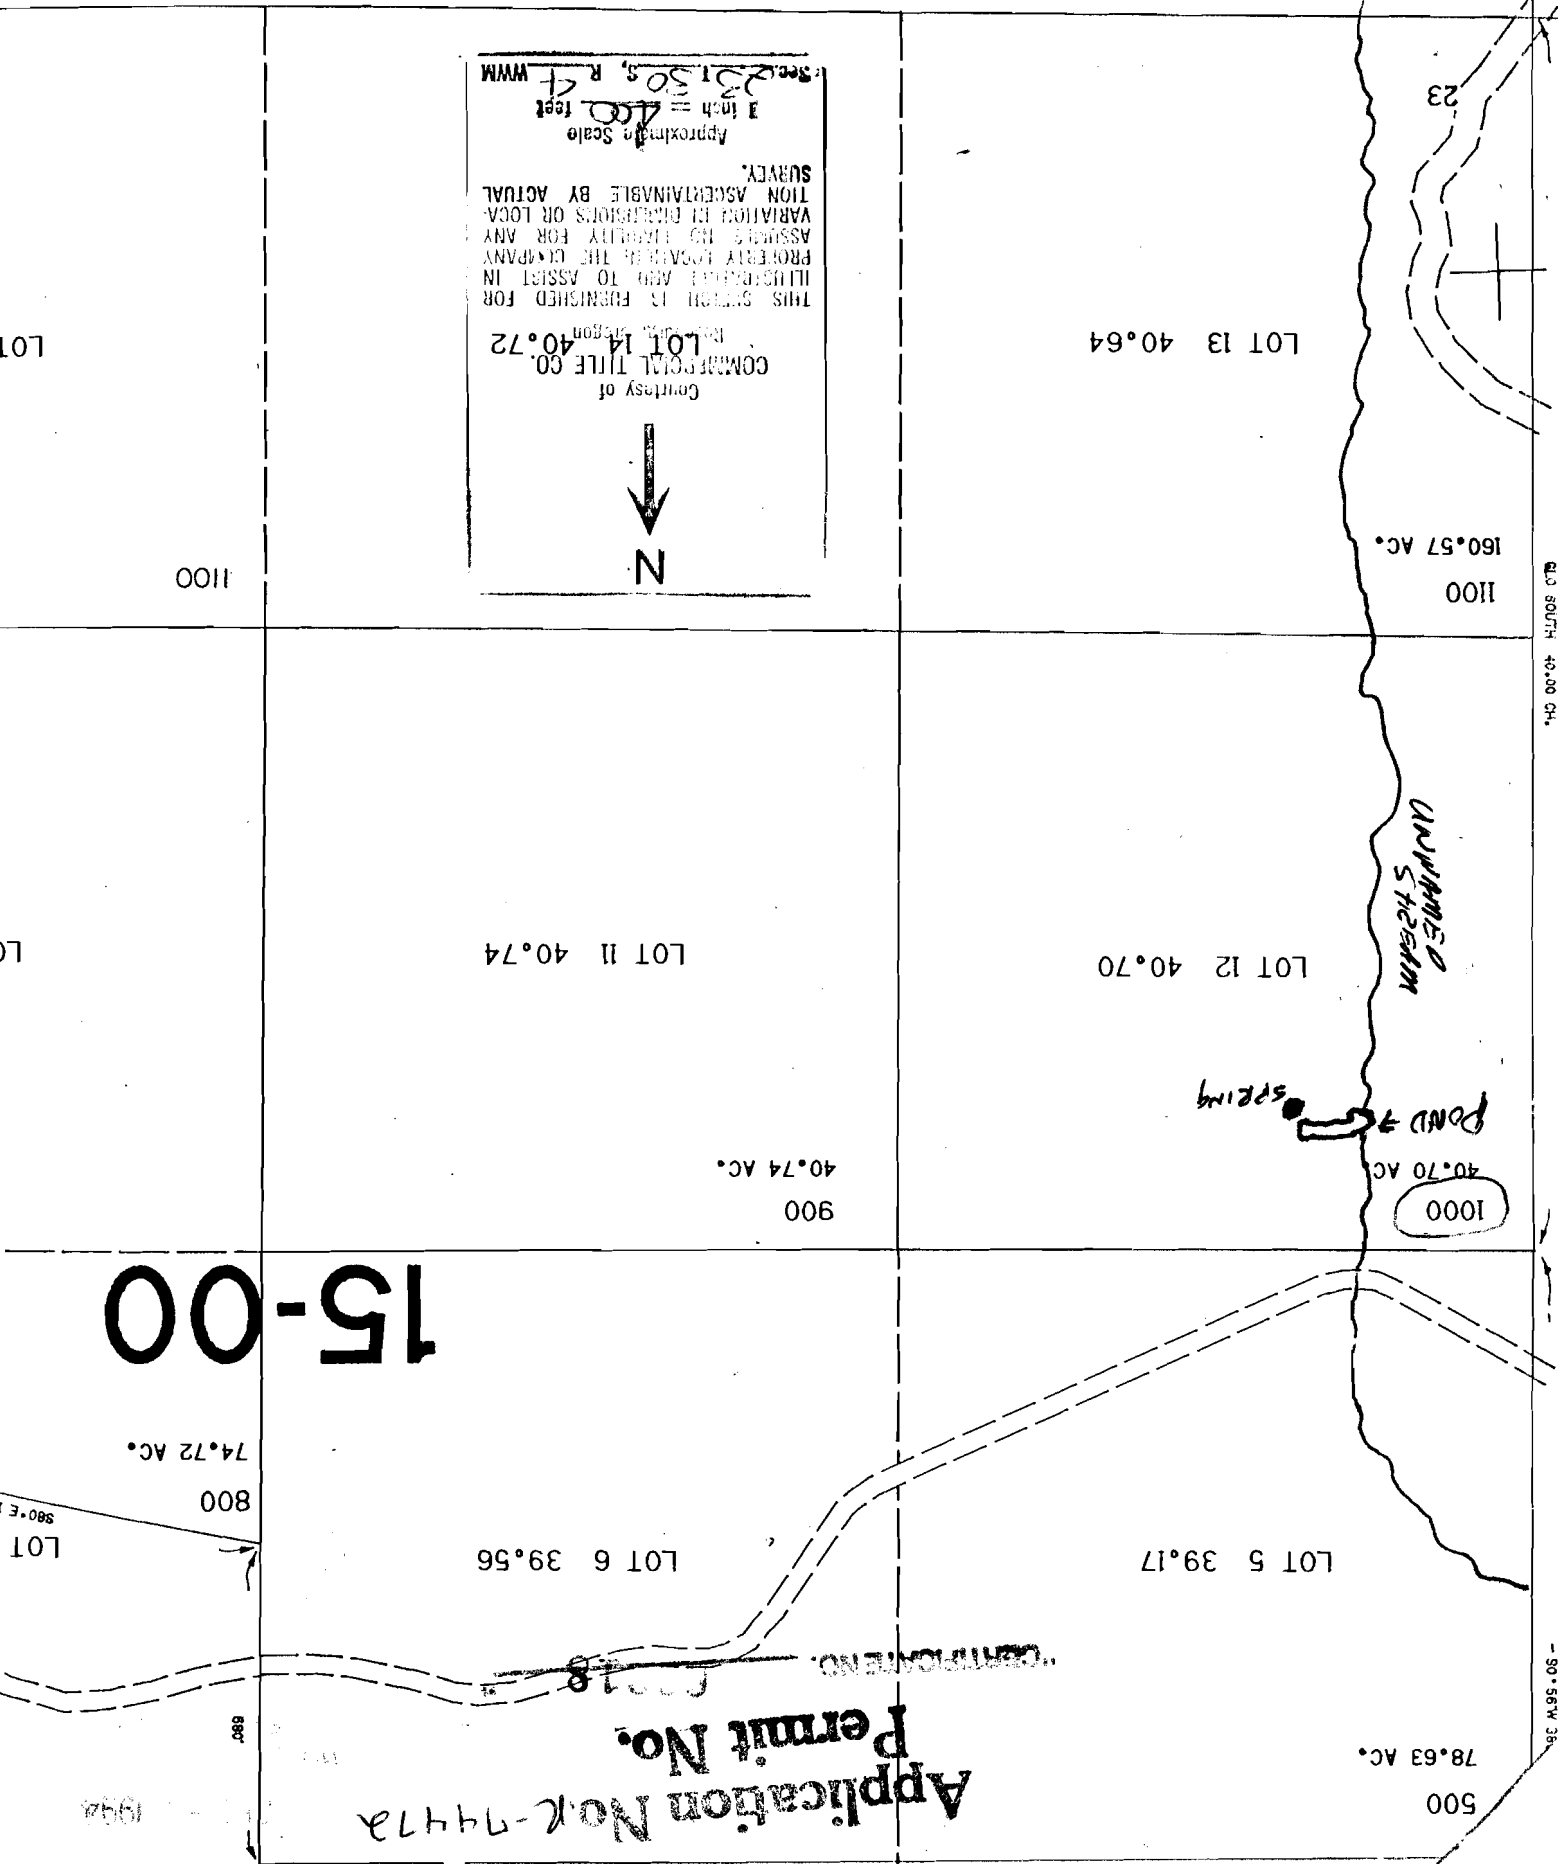

Application No. K-74472
 Permit No.

GLD SOUTH 40.00 CH.

501.567W 38

No Final Proof Map available

No Permit Map available