


34 2W 22

THIS MAP FOR ASSESSMENT
& TAXATION PURPOSES
ONLY

SEP 16 1994
WATER RESOURCES DEPT.
SALEM, OREGON

Application No. R-74506
Permit No. "CERTIFIC

"CERTIFICATE NO. 69228

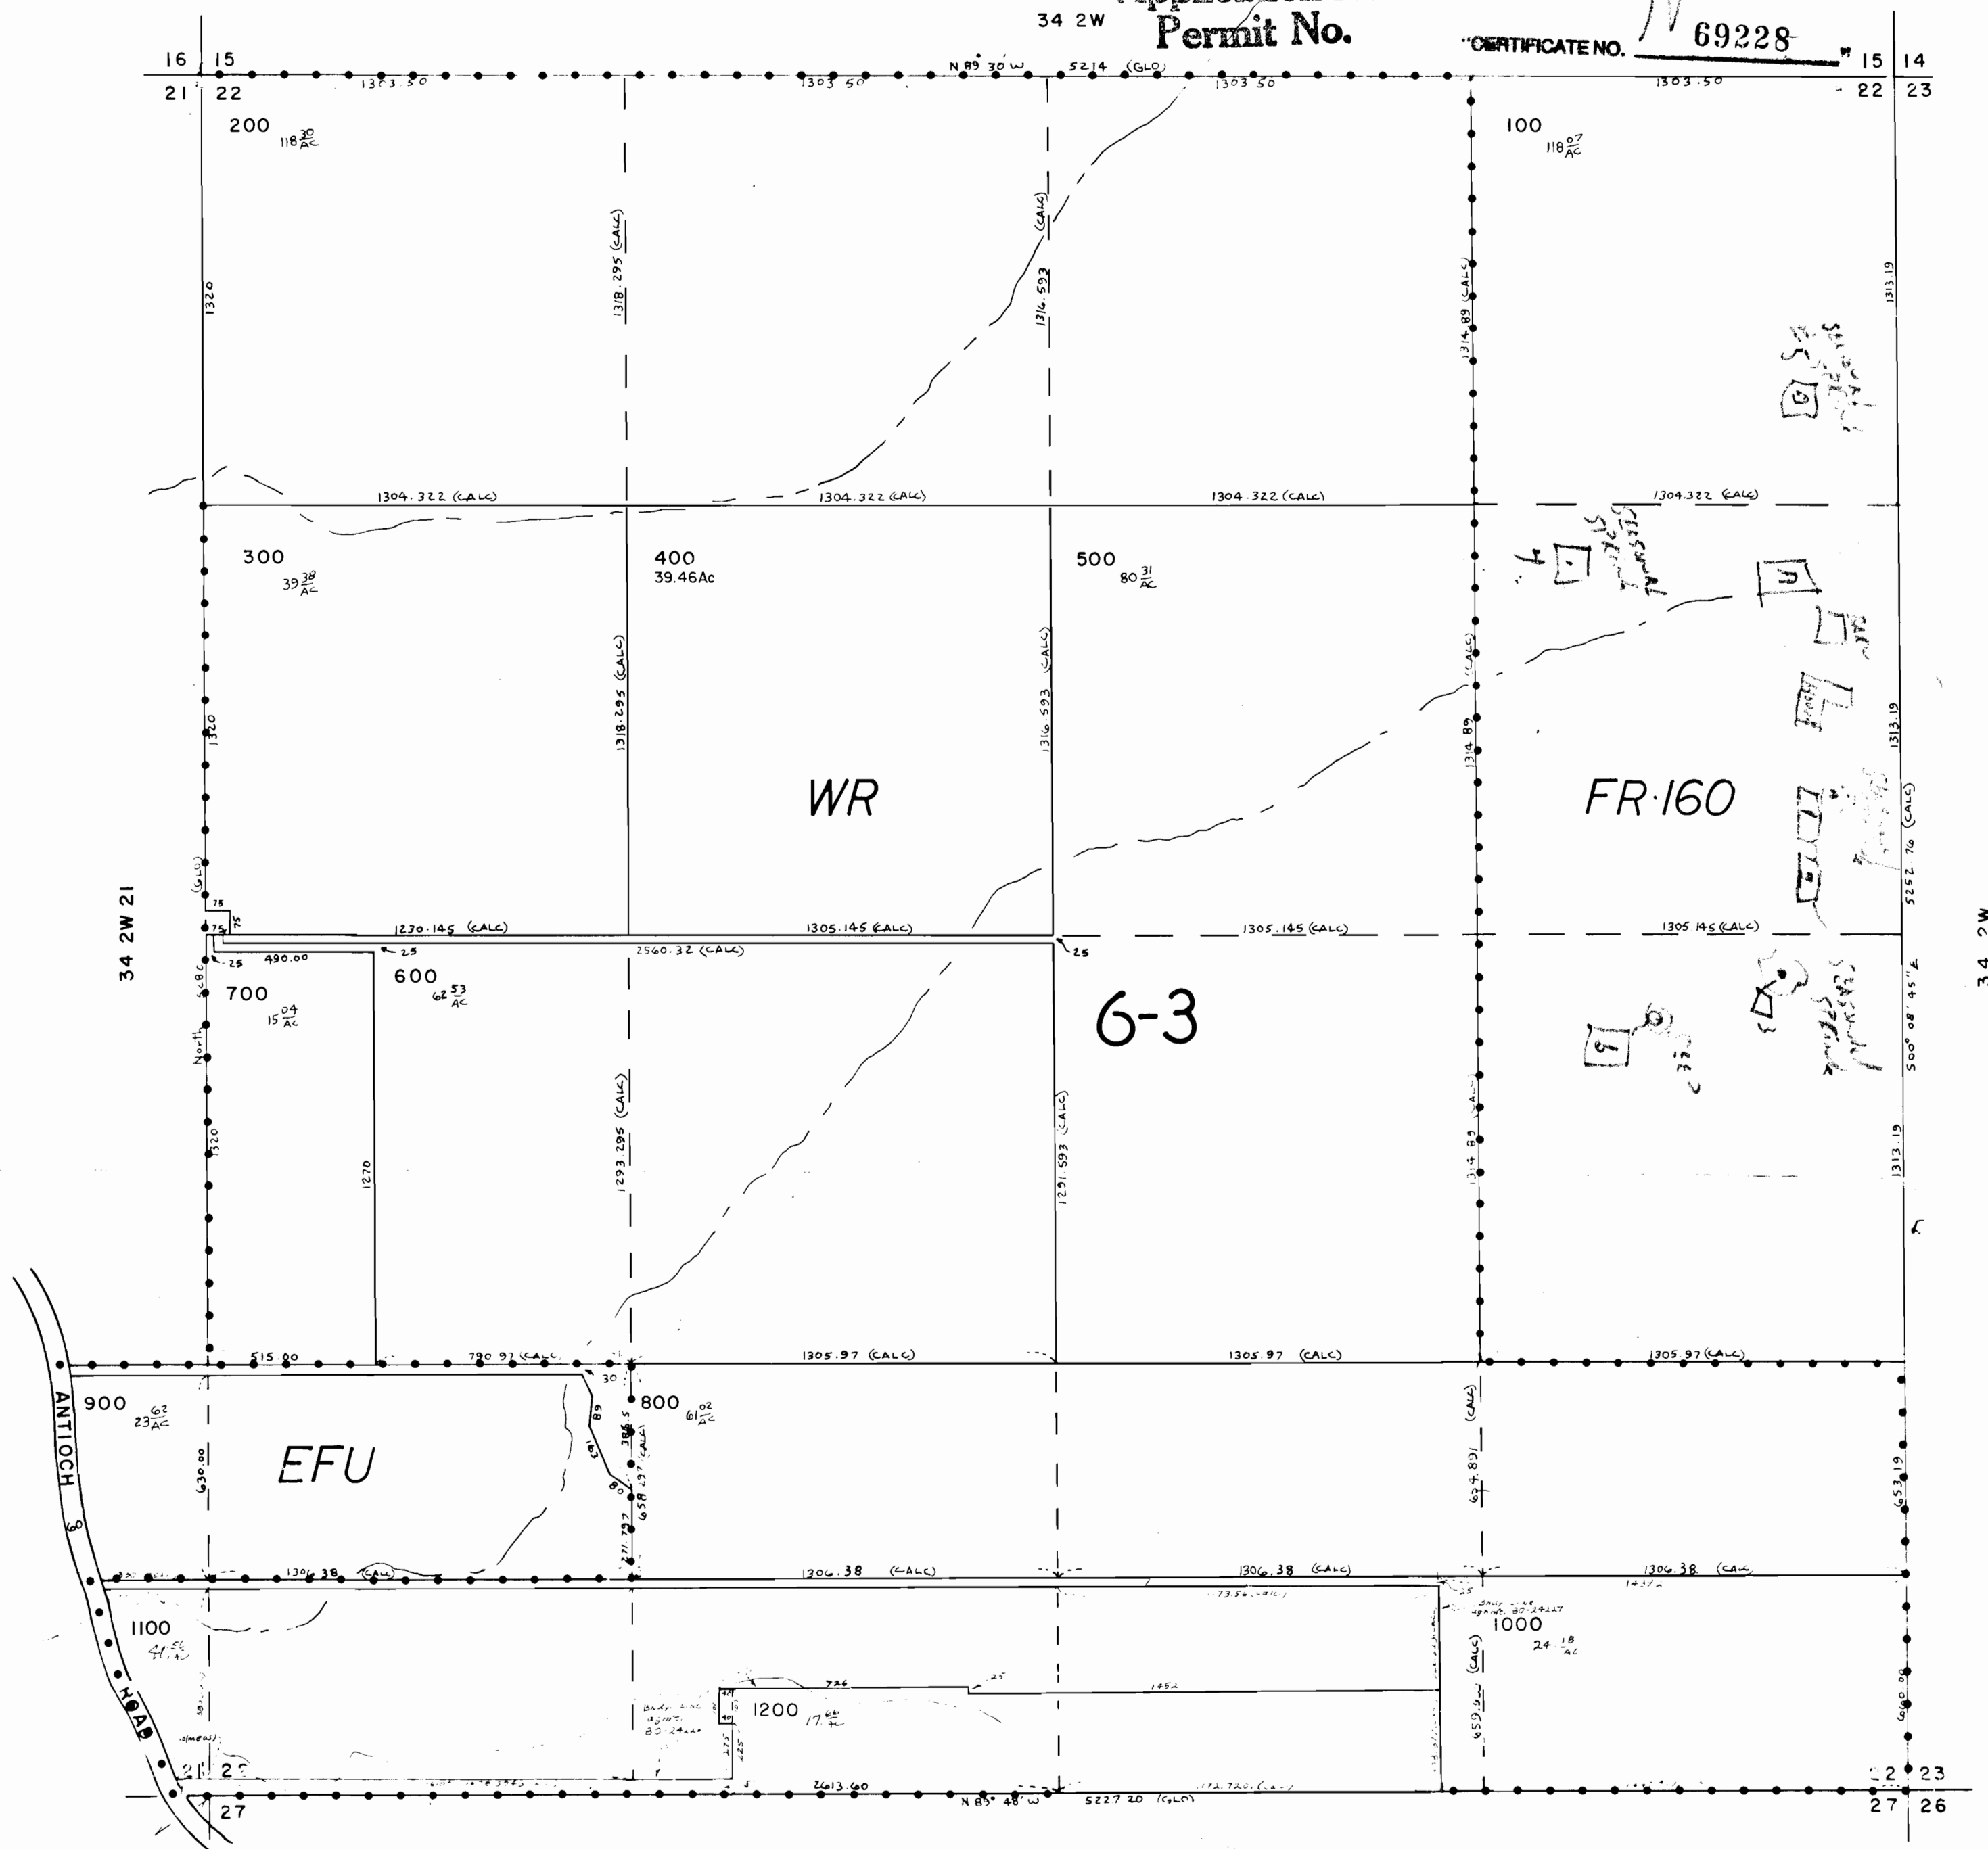

34

LS 2-22-80