


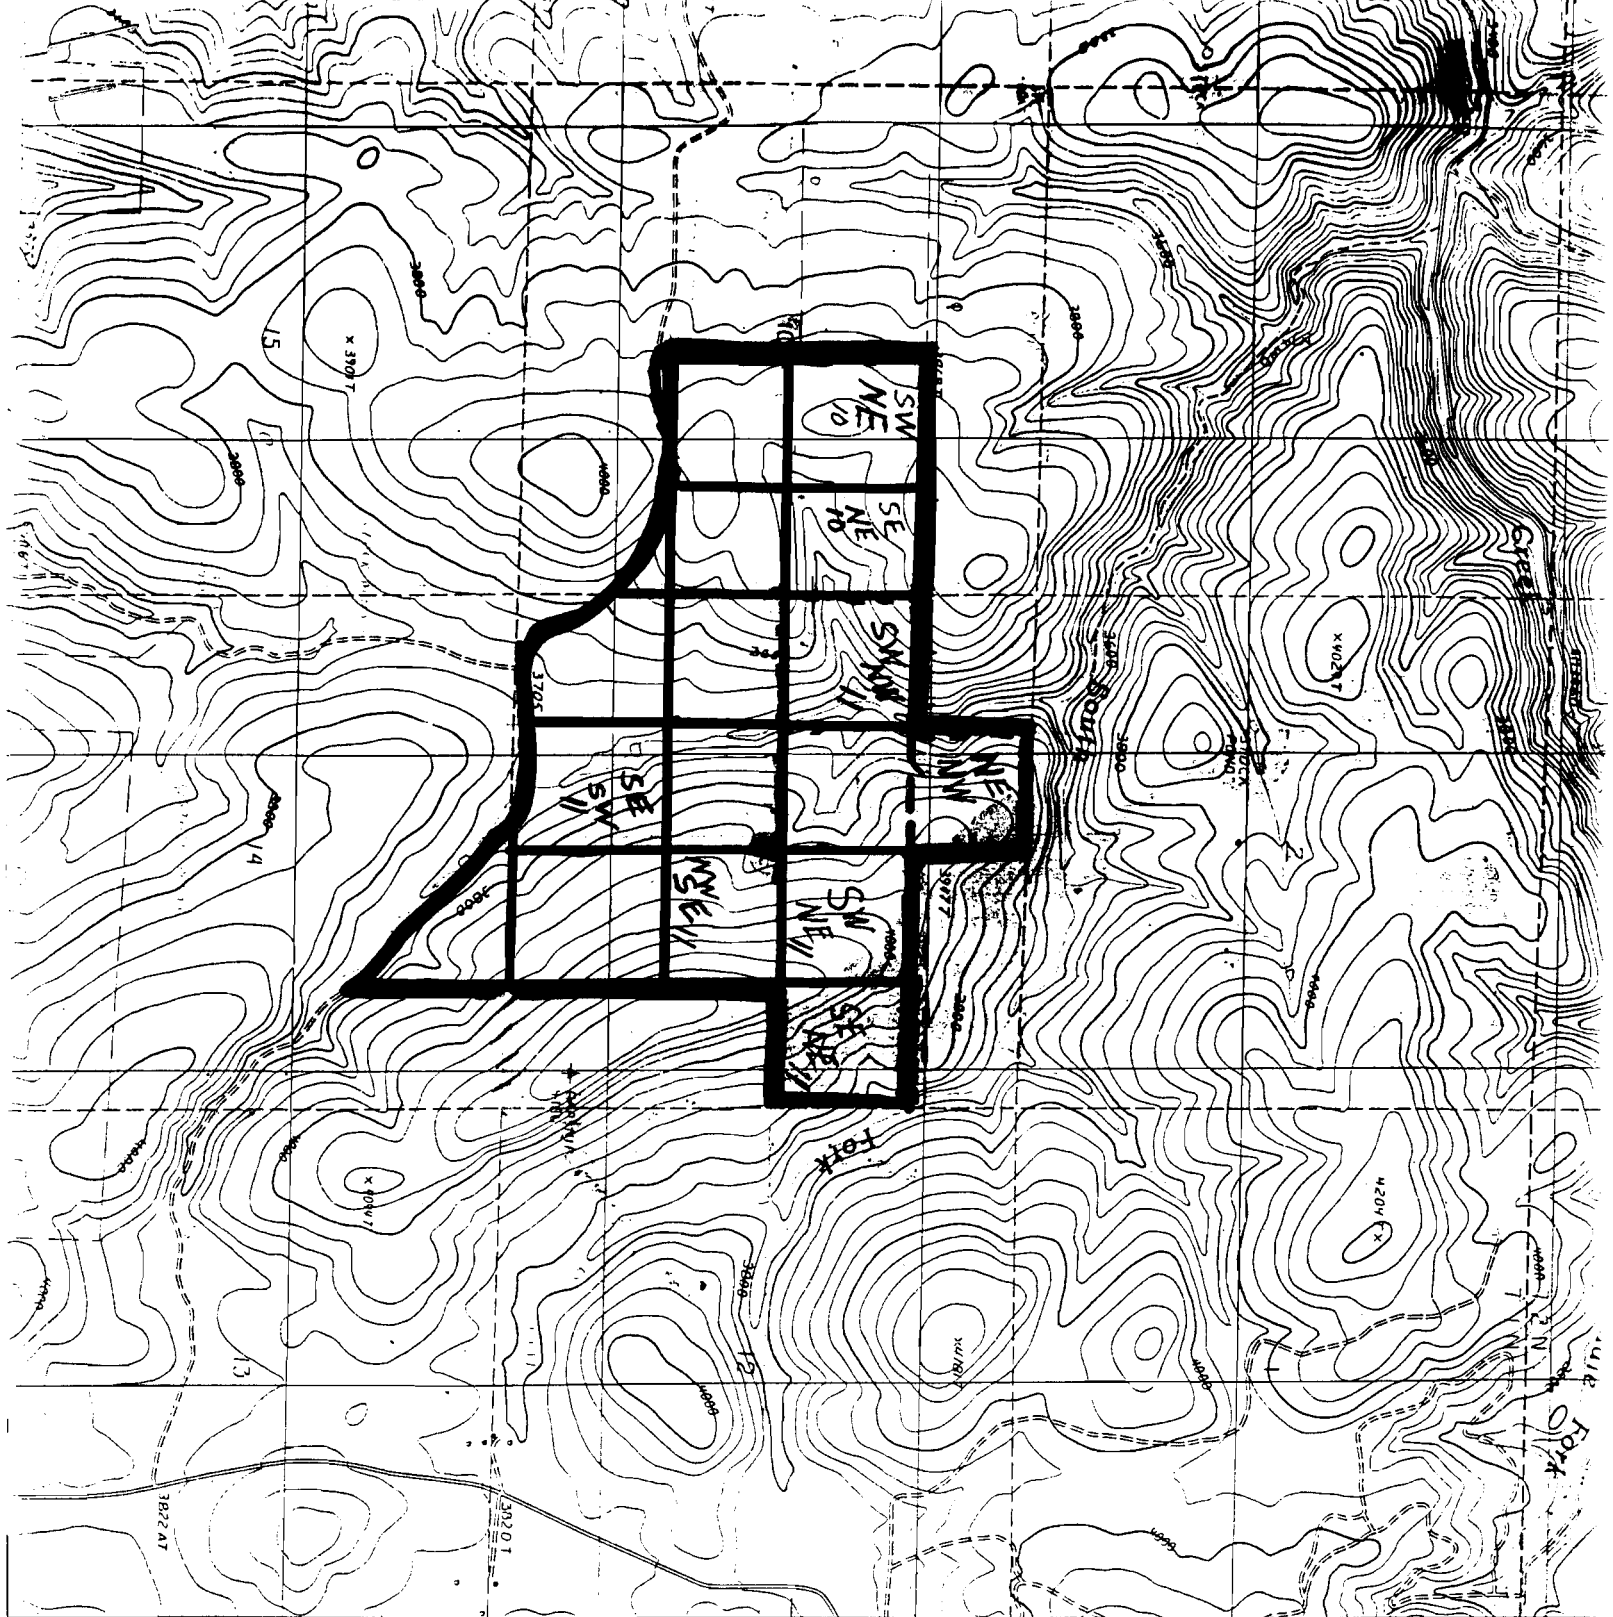

Application No. R74524
Permit No.

"CERTIFICATE NO. 00035"
SEP 21 1994

Tax Lot
2200
Twn 1N
R43 EWN

SEP 2 1994

3705

Application No. 12-74524
Permit No.

CERTIFICATE NO. 1235
169235

No Final Proof Map available

No Permit Map available