


UMATILLA NWR HB2153 POND LOCATION


UNITED STATES
DEPARTMENT OF THE INTERIOR
GEOLOGICAL SURVEY


PATERSON QUADRANGLE
WASHINGTON-OREGON
7.5 MINUTE SERIES (TOPOGRAPHIC)

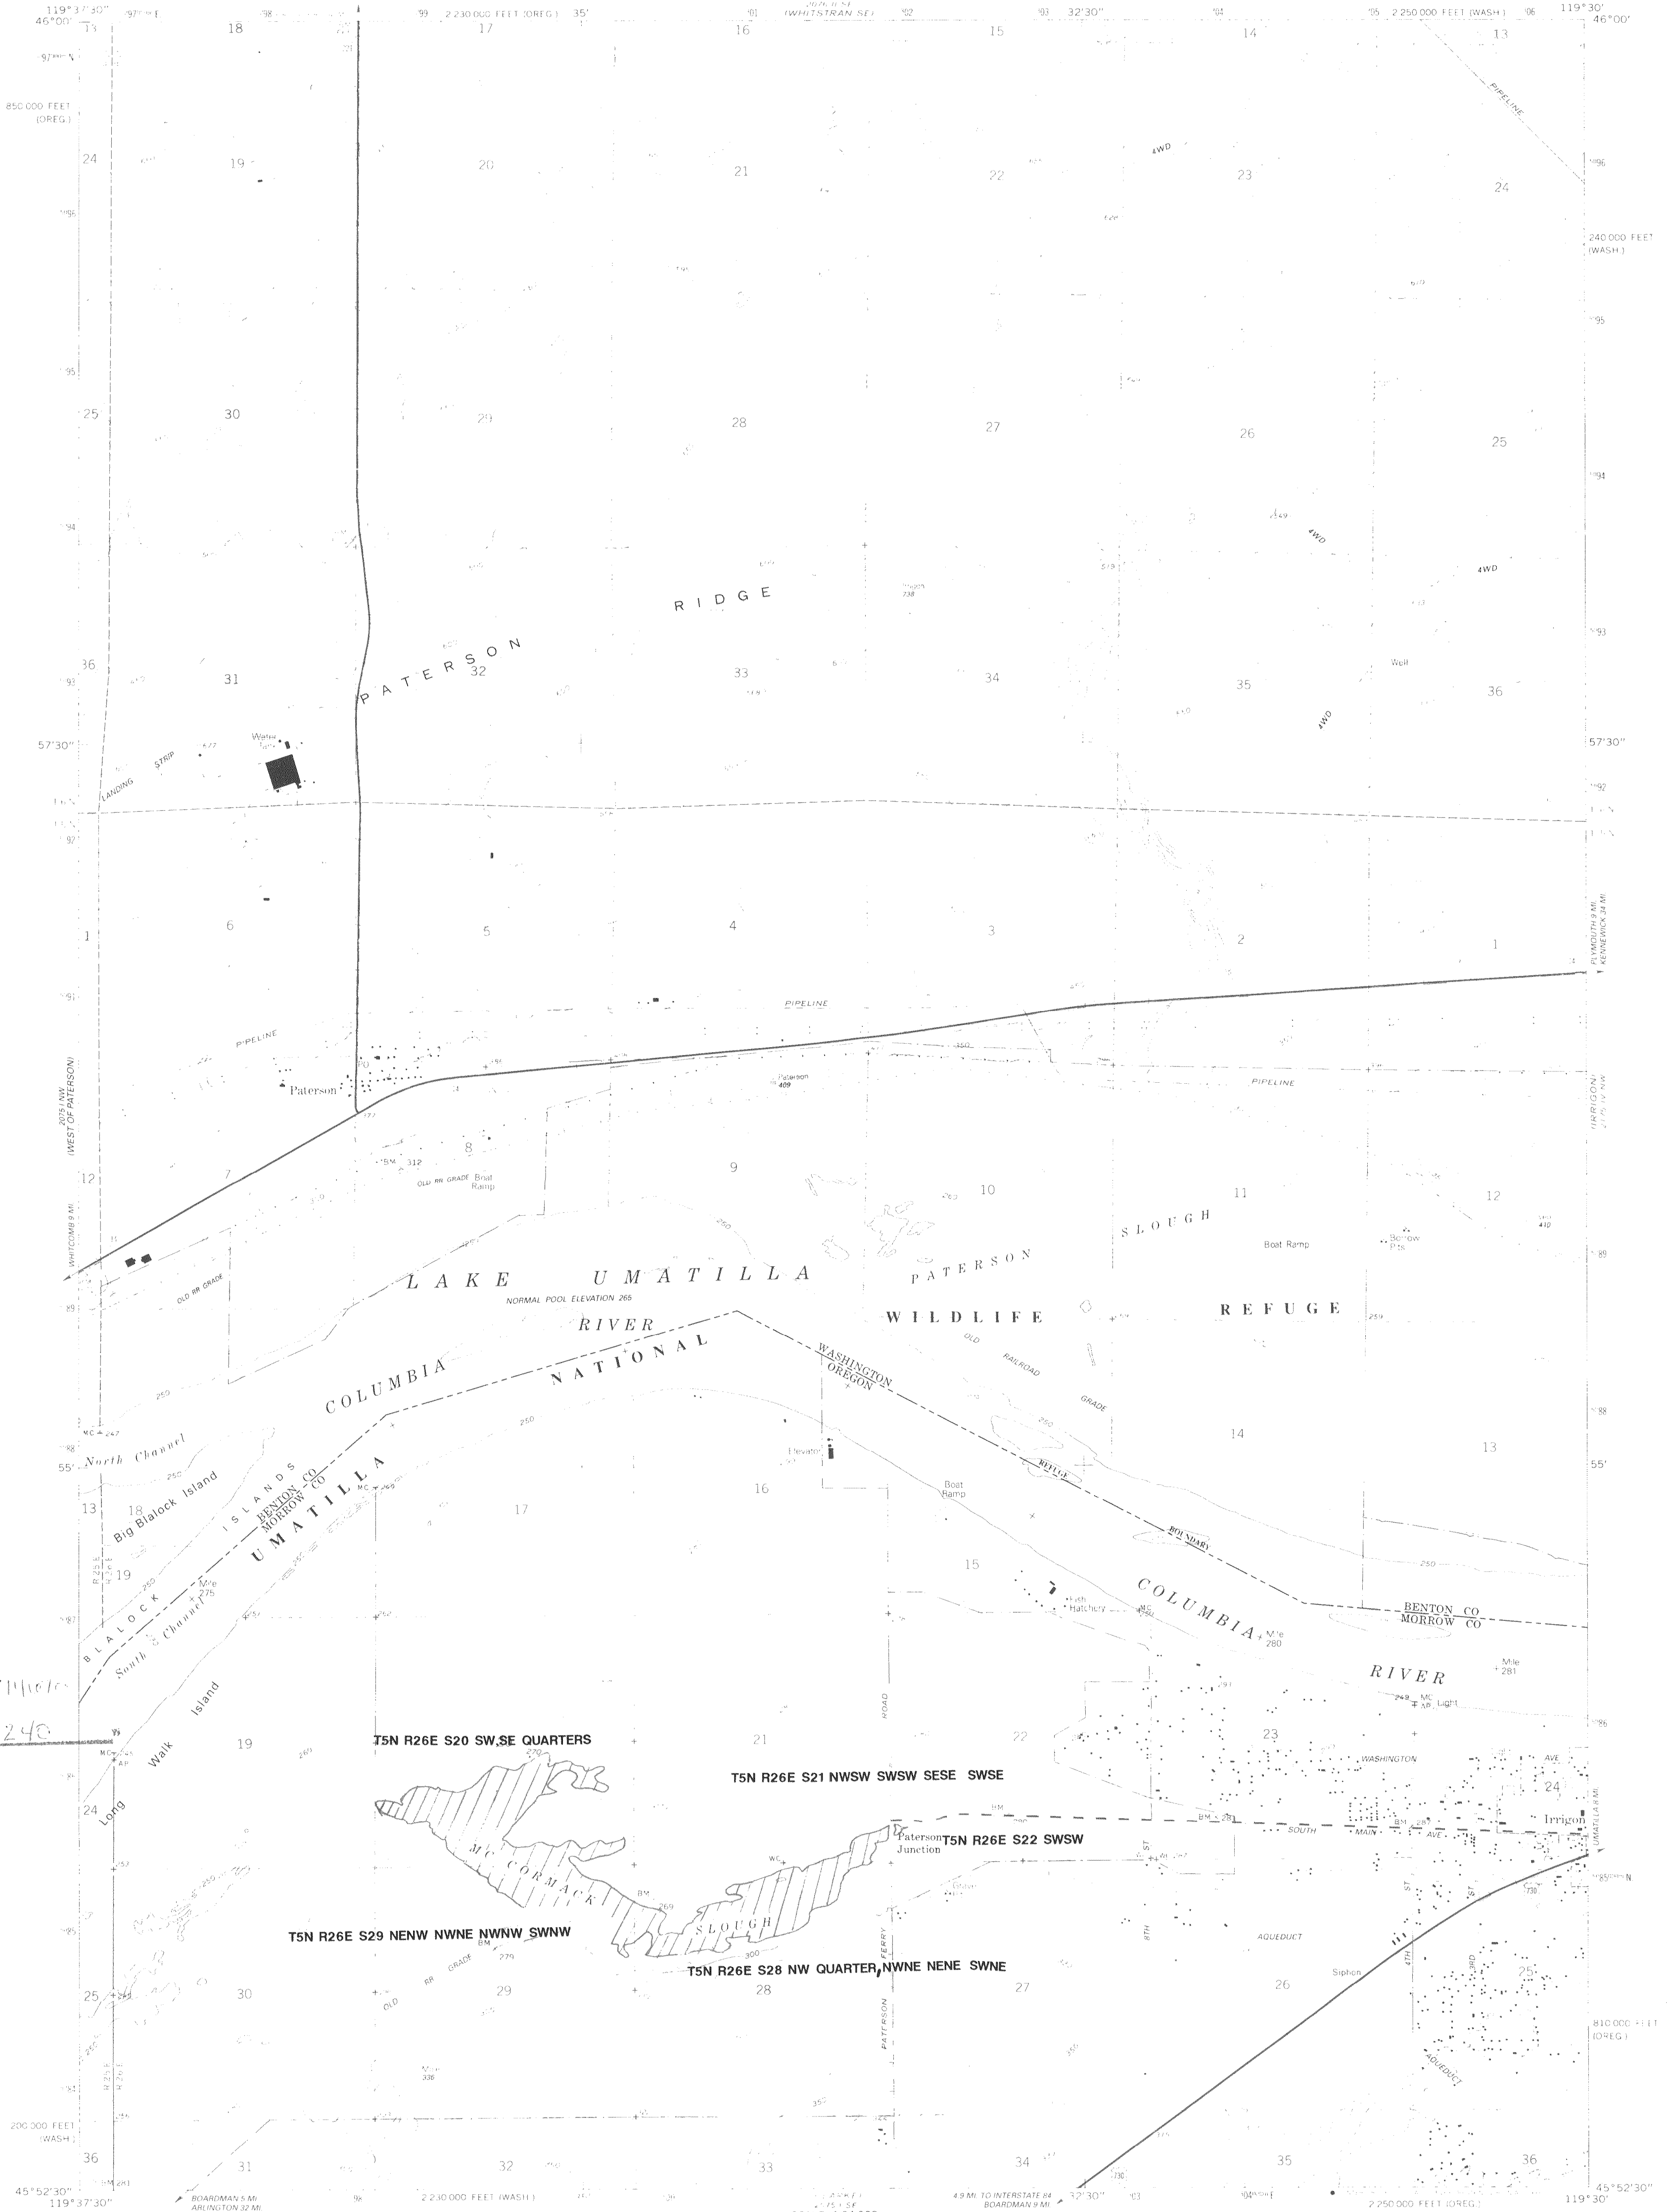

Produced by the United States Geological Survey
Composed by USGS and NOS/IOAA
Compiled from aerial photographs taken 1958 and 1960
Revised from aerial photographs taken 1988 and other sources
Field checked 1991. Map edited 1993
1927 North American Datum (NAD 27) - Project on
Washington Coordinate System, south zone (Lambert Conformal Conic
10000-foot ticks Washington Coordinate System, south zone and
Oregon Coordinate System - north zone
Blue 5000 meter Universal Transverse Mercator ticks, zone 11
North American Datum of 1983 (NAD 83) is shown by dashed
corner ticks. The values of the shift between NAD 27 and NAD 83
for 7.5-minute intersections are given in USGS Bulletin 1875
There may be private rights within the boundaries of the
National or State Reservations shown on this map.

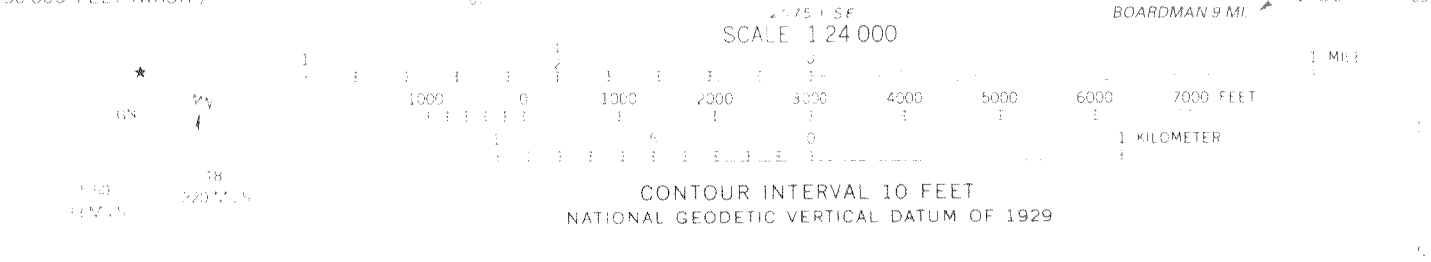

ROAD CLASSIFICATION

Heavy duty	Light duty
Medium duty	Unimproved dirt
U.S. Route	State Route

THIS MAP COMPLIES WITH NATIONAL MAP ACCURACY STANDARDS
FOR SALE BY U.S. GEOLOGICAL SURVEY, DENVER, COLORADO 80225 OR RESTON, VIRGINIA 22092
A FOLDER DESCRIBING TOPOGRAPHIC MAPS AND SYMBOLS IS AVAILABLE ON REQUEST

PATERSON, WASH.-OREG.
45119-H5-TF-024

1993

DMA 2075-1-NI-SERIES V891

UMATILLA NWR HB2153 POND LOCATION

CERTIFICATE NO. 69240

R-74670

PATERSON QUADRANGLE
WASHINGTON-OREGON
7.5 MINUTE SERIES (TOPOGRAPHIC)

UNITED STATES
DEPARTMENT OF THE INTERIOR
GEOLOGICAL SURVEY



App # 74670
CERTIFICATE NO. 69240

RECEIVED
SEP 28 1994
WATER RESOURCES DIVISION

Produced by the United States Geological Survey

Control by USGS and NOS/NOAA

Compiled from aerial photographs taken 1958 and 1960

Revised from aerial photographs taken 1988 and other sources.

Field checked 1991. Map edited 1993

1927 North American Datum (NAD 27). Projection:

Washington Coordinate System, south zone (Lambert Conformal Conic)

10 000-foot ticks: Washington Coordinate System, south zone and

Oregon Coordinate System, north zone

Blue 1000-meter Universal Transverse Mercator ticks, zone 11

North American Datum of 1983 (NAD 83) is shown by dashed

corner ticks. The values of the shift between NAD 27 and NAD 83 for

7.5-minute intersections are given in USGS Bulletin 1875

There may be private inholdings within the boundaries of the

National or State reservations shown on this map

SCALE 1:24 000

CONTOUR INTERVAL 10 FEET
NATIONAL GEODETIC VERTICAL DATUM OF 1929

UTM GRID AND 1983 MAGNETIC NORTH DECLINATION AT CENTER OF SHEET

THIS MAP COMPLIES WITH NATIONAL MAP ACCURACY STANDARDS

FOR SALE BY U. S. GEOLOGICAL SURVEY, DENVER, COLORADO 80225, OR RESTON, VIRGINIA 22092

A FOLDER DESCRIBING TOPOGRAPHIC MAPS AND SYMBOLS IS AVAILABLE ON REQUEST

ROAD CLASSIFICATION

Heavy-duty Light-duty

Medium-duty Unimproved dirt

U. S. Route State Route

PATERSON, WASH.-OREG.

45119-H5-TF-024

1993

DMA 2075 1 NE-SERIES V891