



# Baskett Slough NWR

## HB 2153 Pond Locations

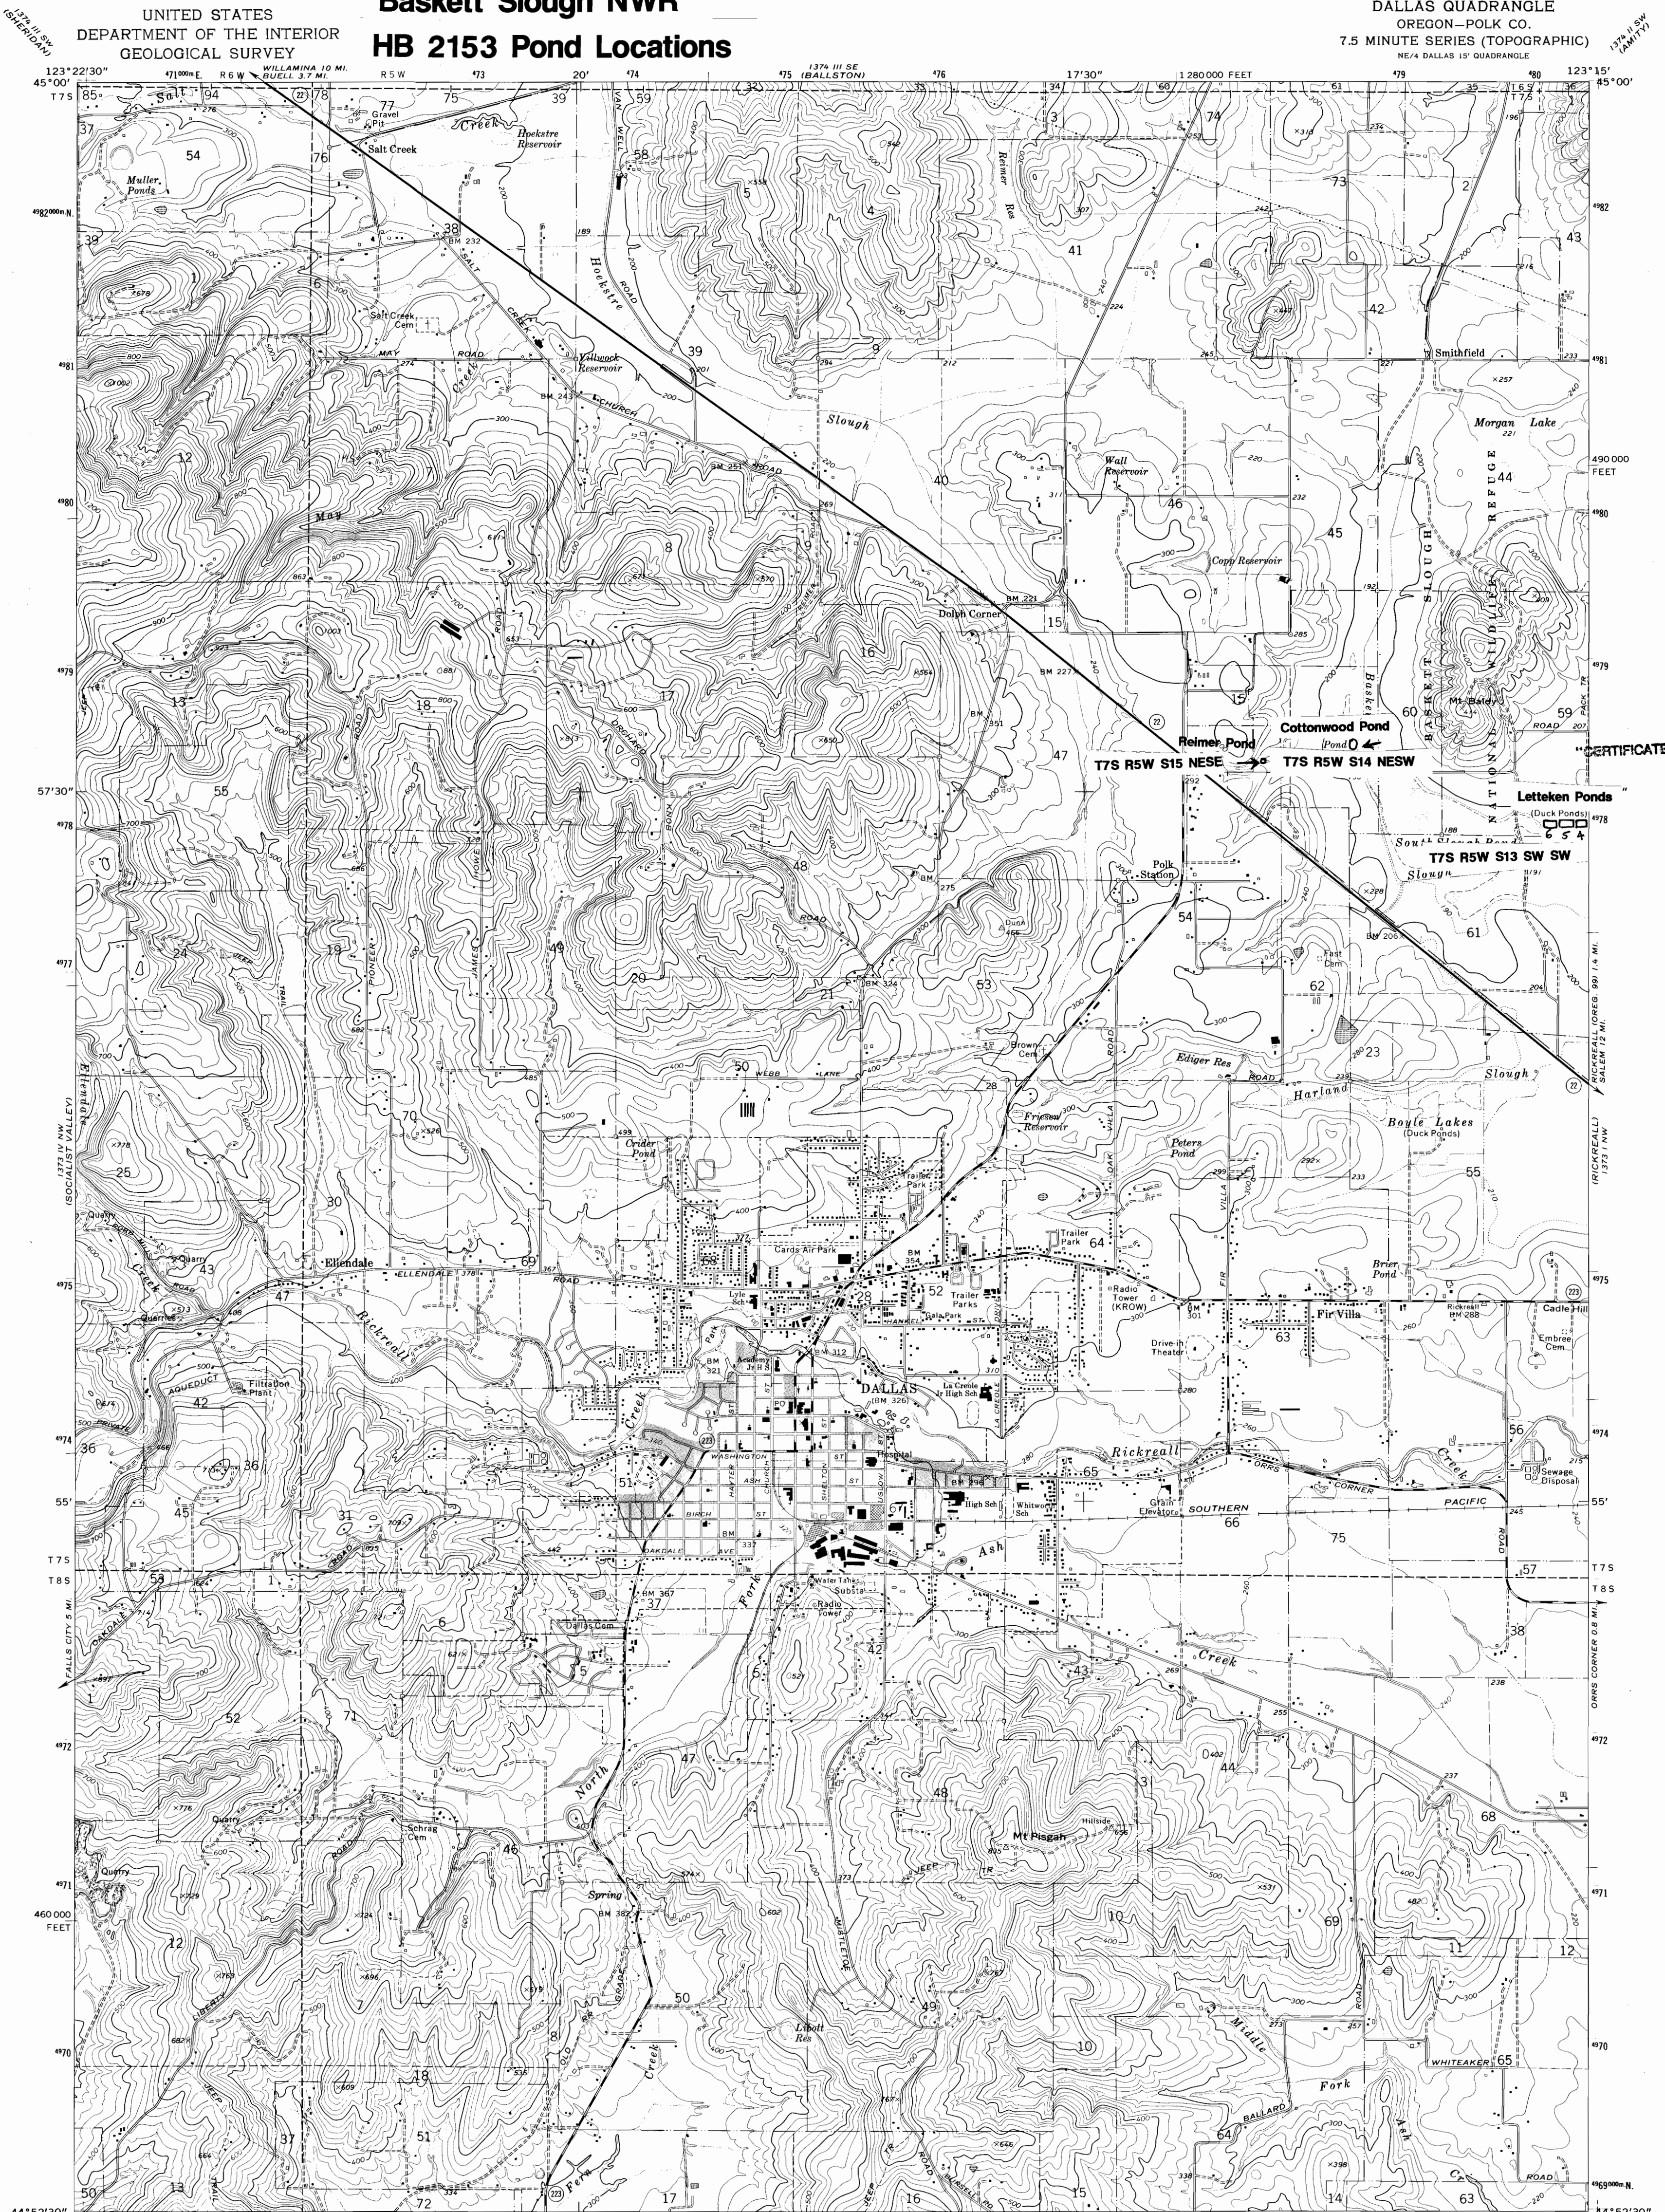

App # 74071  
CERTIFICATE NO. 02241

Mapped, edited, and published by the Geological Survey  
Control by USGS, NOS/NOAA, and State of Oregon  
Topography by photogrammetric methods from aerial  
photographs taken 1972. Field checked 1974  
Projection and 10,000-foot grid ticks: Oregon coordinate  
system, north zone (Lambert conformal conic)  
1000-meter Universal Transverse Mercator grid ticks,  
zone 10, shown in blue. 1927 North American datum  
To place on the predicted North American Datum 1983,  
move the projection lines 23 meters north and  
96 meters east as shown by dashed corner ticks  
There may be private inholdings within the boundaries of  
the National or State reservations shown on this map  
Red tint indicates areas in which only landmark buildings are shown

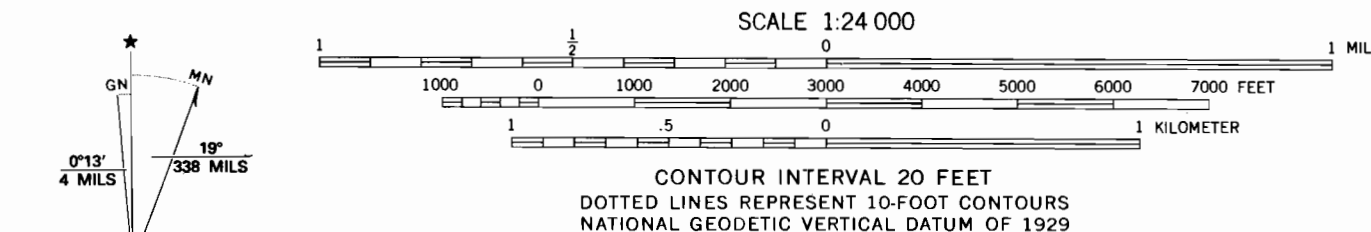

ROAD CLASSIFICATION  
Primary highway, hard surface  
Secondary highway, hard surface  
Light-duty road, hard or improved surface  
Unimproved road  
Interstate Route  
U. S. Route  
State Route



DALLAS, OREG.  
NE/4 DALLAS 15' QUADRANGLE  
44123-H3-TF-024  
1974  
PHOTOREVISED 1986  
DMA 1373 IV NE-SERIES 1982

THIS MAP COMPLIES WITH NATIONAL MAP ACCURACY STANDARDS  
FOR SALE BY U. S. GEOLOGICAL SURVEY, DENVER, COLORADO 80225, OR RESTON, VIRGINIA 22092  
A FOLDER DESCRIBING TOPOGRAPHIC MAPS AND SYMBOLS IS AVAILABLE ON REQUEST

Revisions shown in purple compiled from aerial  
photographs taken 1982 and other sources  
This information not field checked. Map edited 1986

R74671

No Final Proof Map available

No Permit Map available