


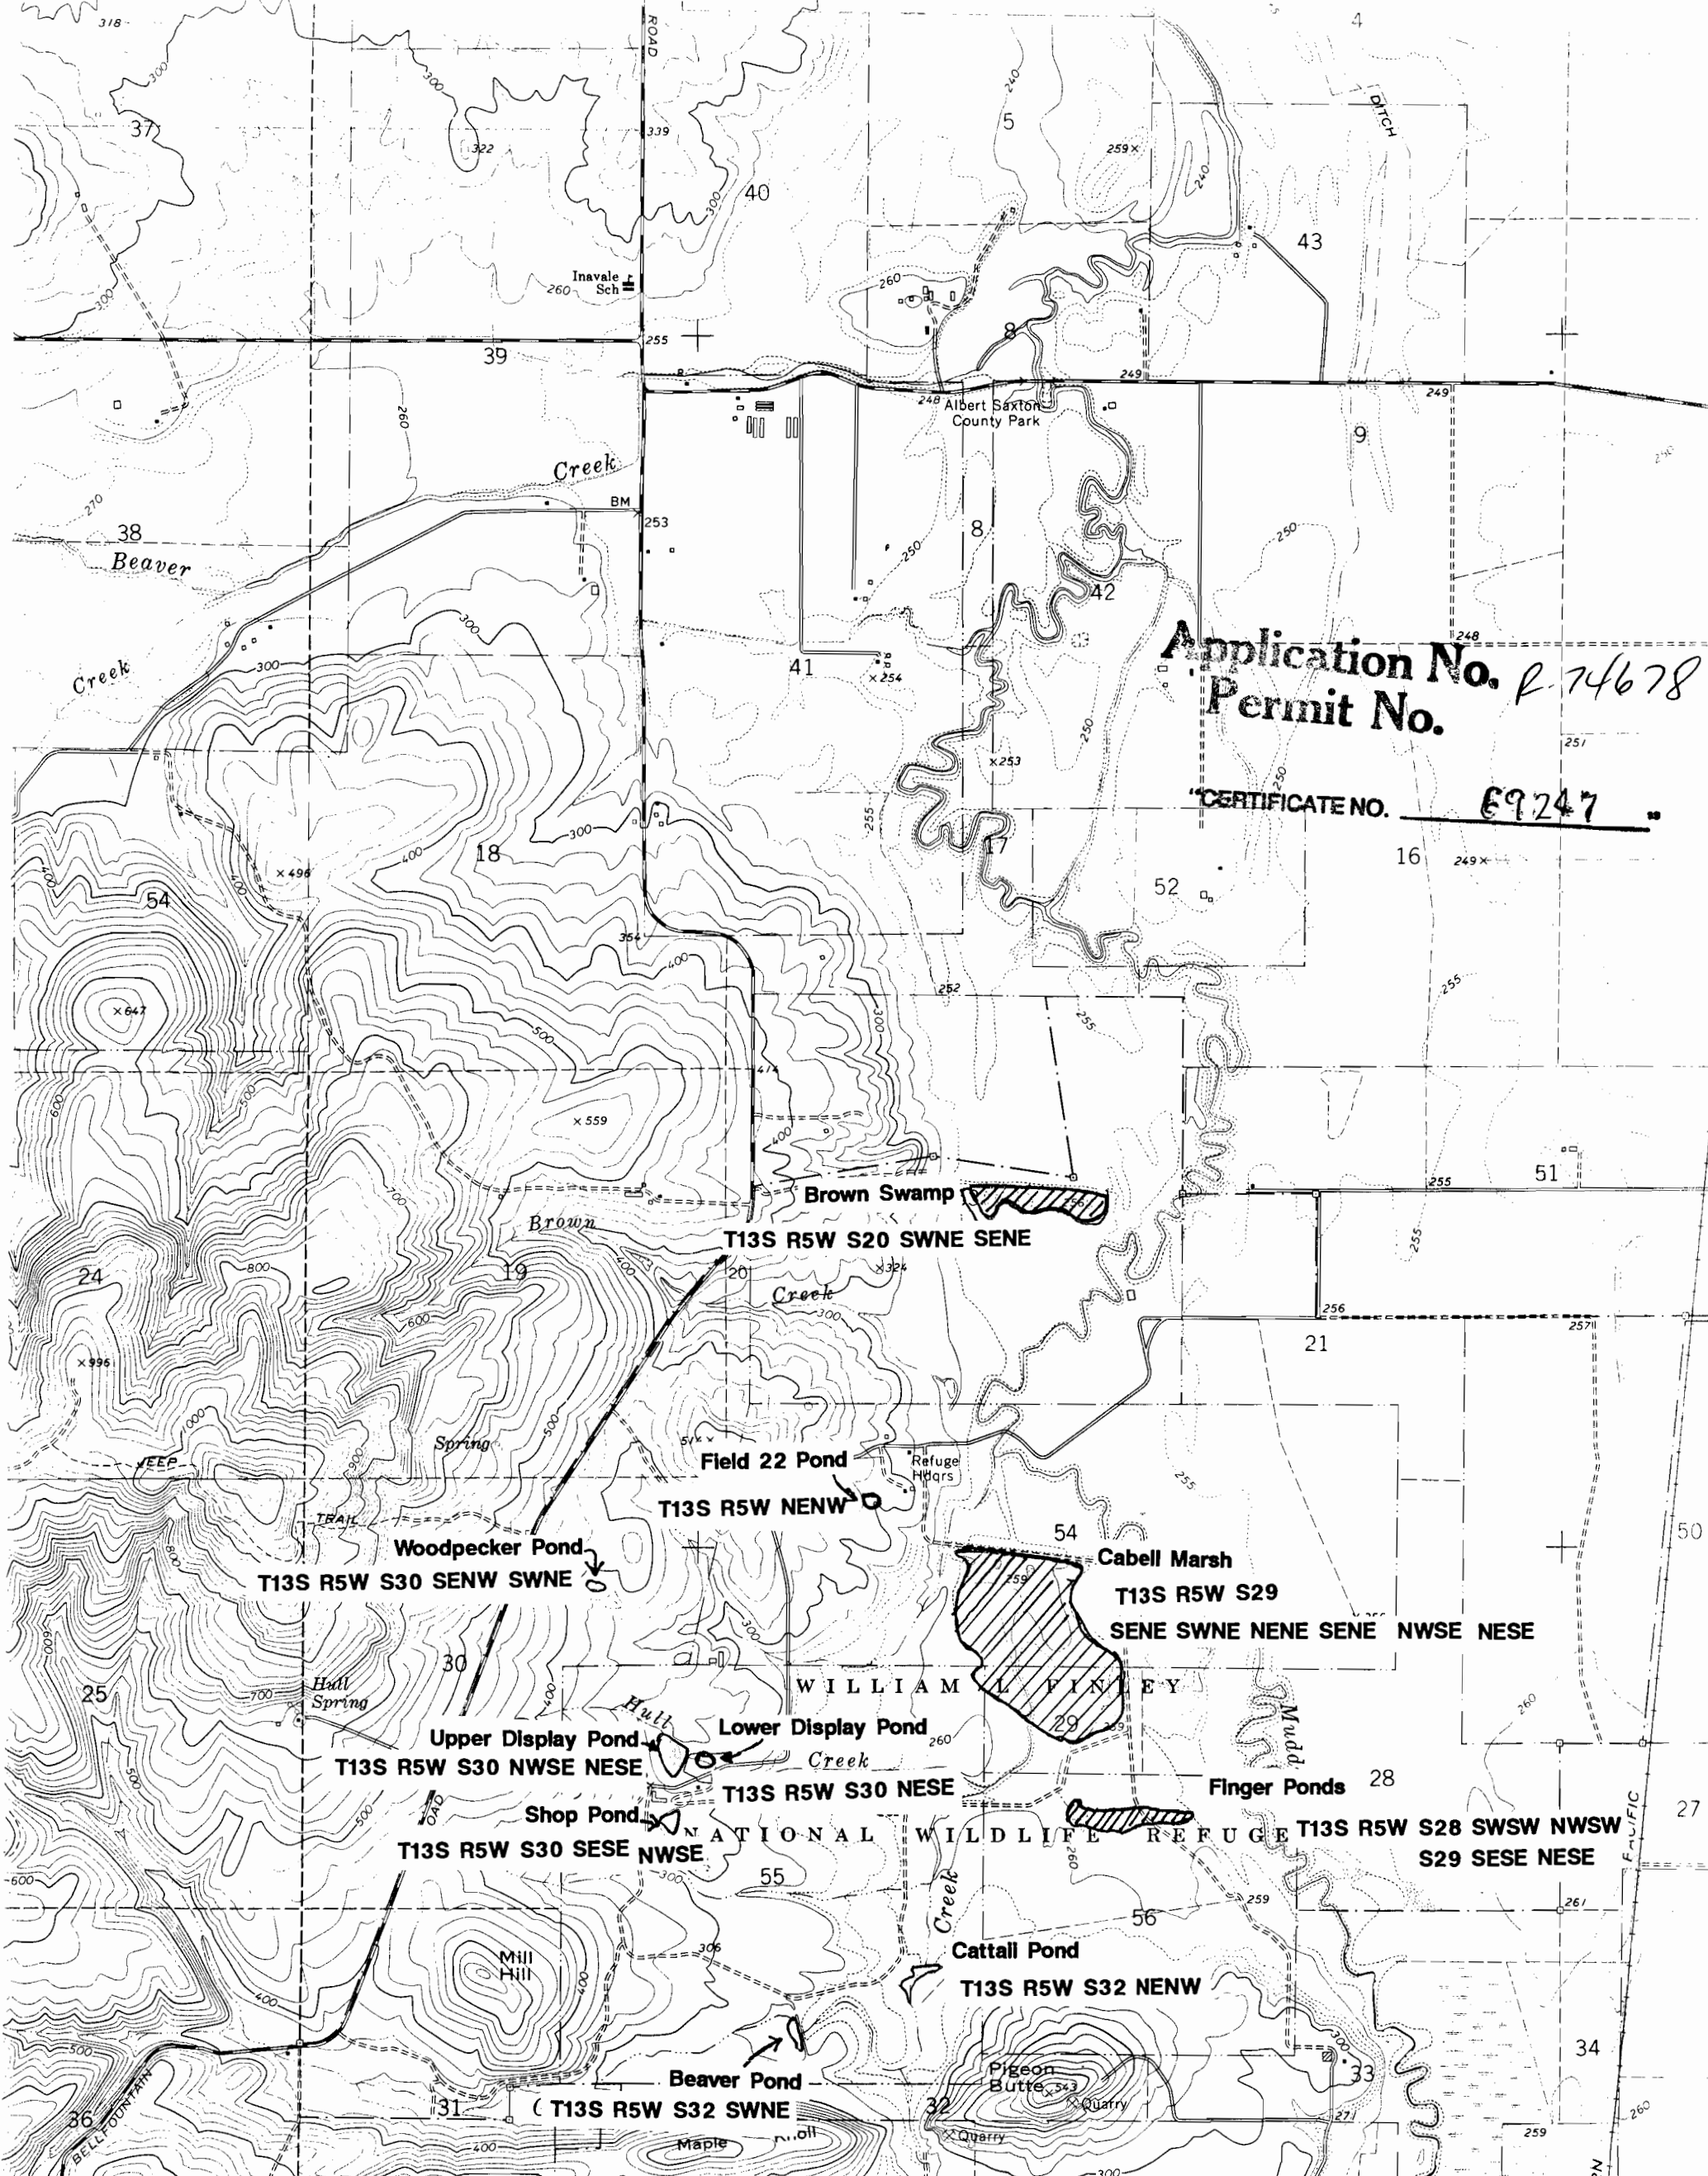

Application No. P 74678
Permit No.

CERTIFICATE NO. 69247

T13S R5W S20 SWNE SENE

T13S R5W NENW

T13S R5W S30 SENW SWNE

T13S R5W S29
SENE SWNE NENE SENE NWSE NESE

T13S R5W S30 NWSE NESE

T13S R5W S30 NESE

T13S R5W S30 SESE NWSE

T13S R5W S28 SWSW NWSW
S29 SESE NESE

T13S R5W S32 NENW

T13S R5W S32 SWNE

No Final Proof Map available

No Permit Map available