

Application No. 274698
Permit No.


RECEIVED

OCT - 3 1994

SEP 22 1994

CERTIFICATE NO. 2256

WATER RESOURCES DEPT.
SALEM, OREGON

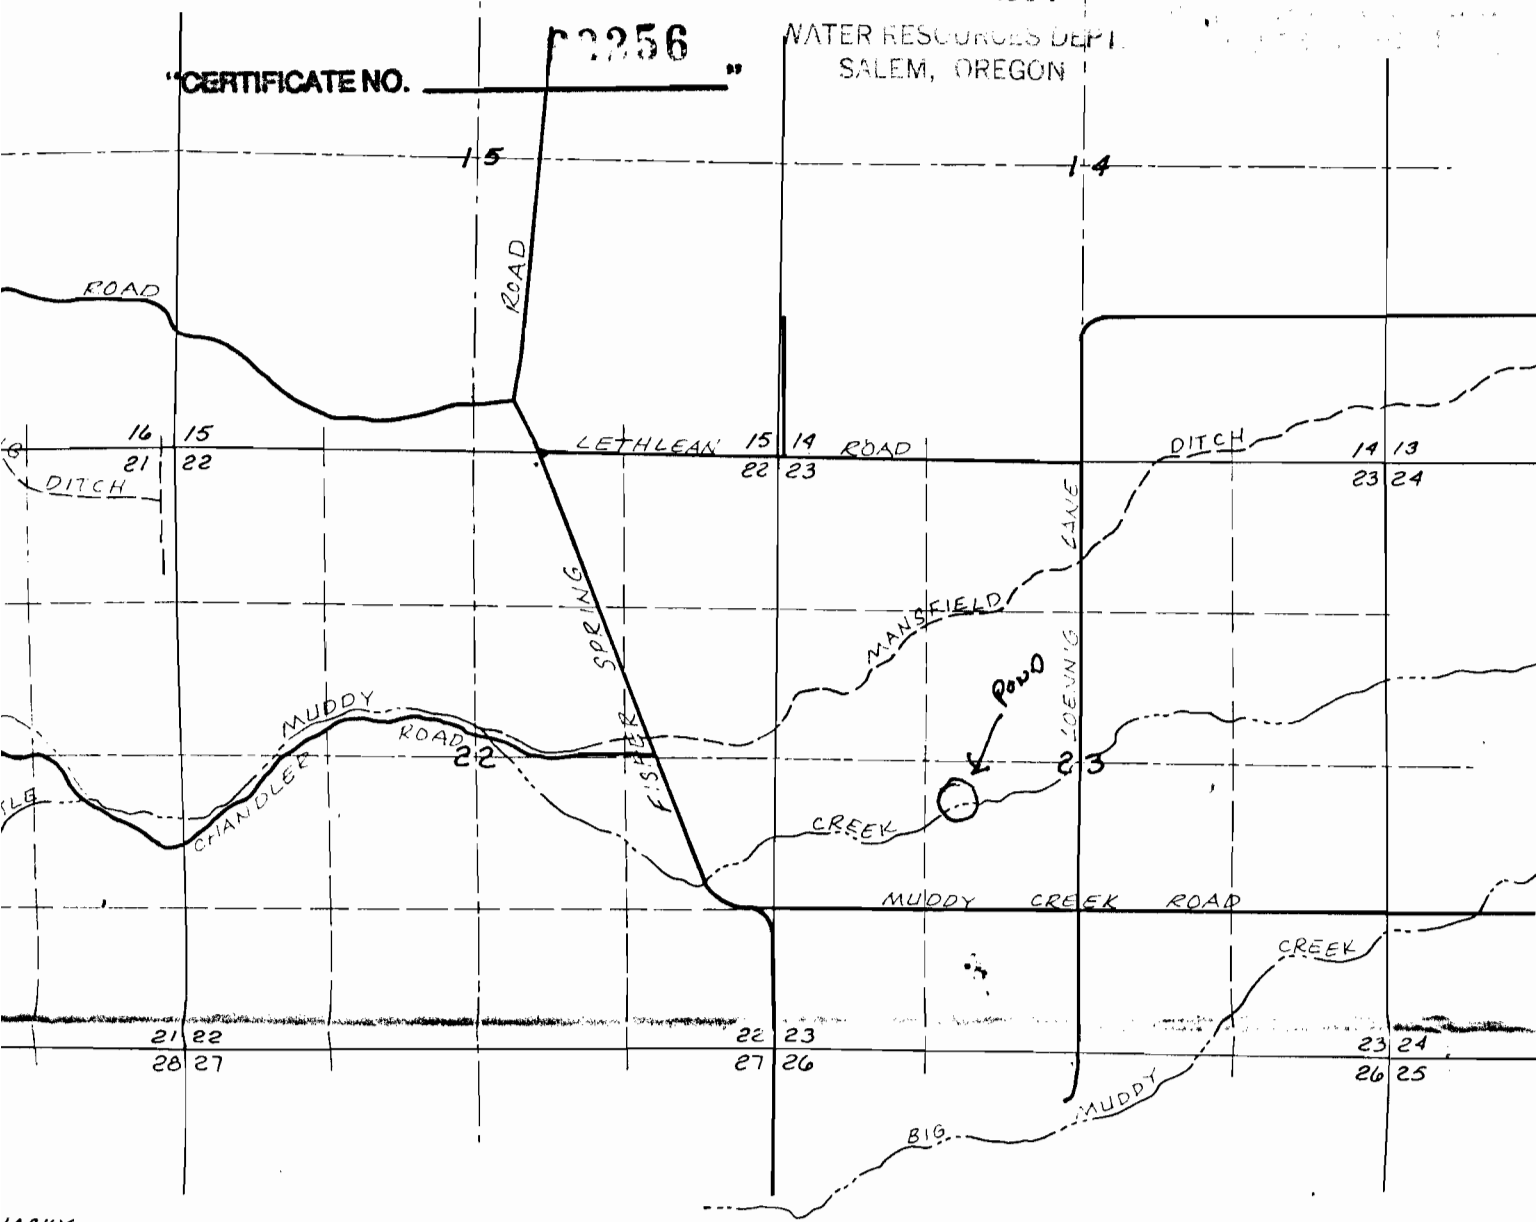

FINAL PROOF SURVEY
MAP

ADDITIONAL
POINT OF DIVERSION
T-6003

JULY 10, 1989

SCALE: 1" = 1320'

