

This map was prepared for
assessment purpose only


SECTION 26 T.39S. R.19E. W.M.
LAKE COUNTY

1" = 400'

39 19 26

SEE MAP 39 19 23

22 23
27 26

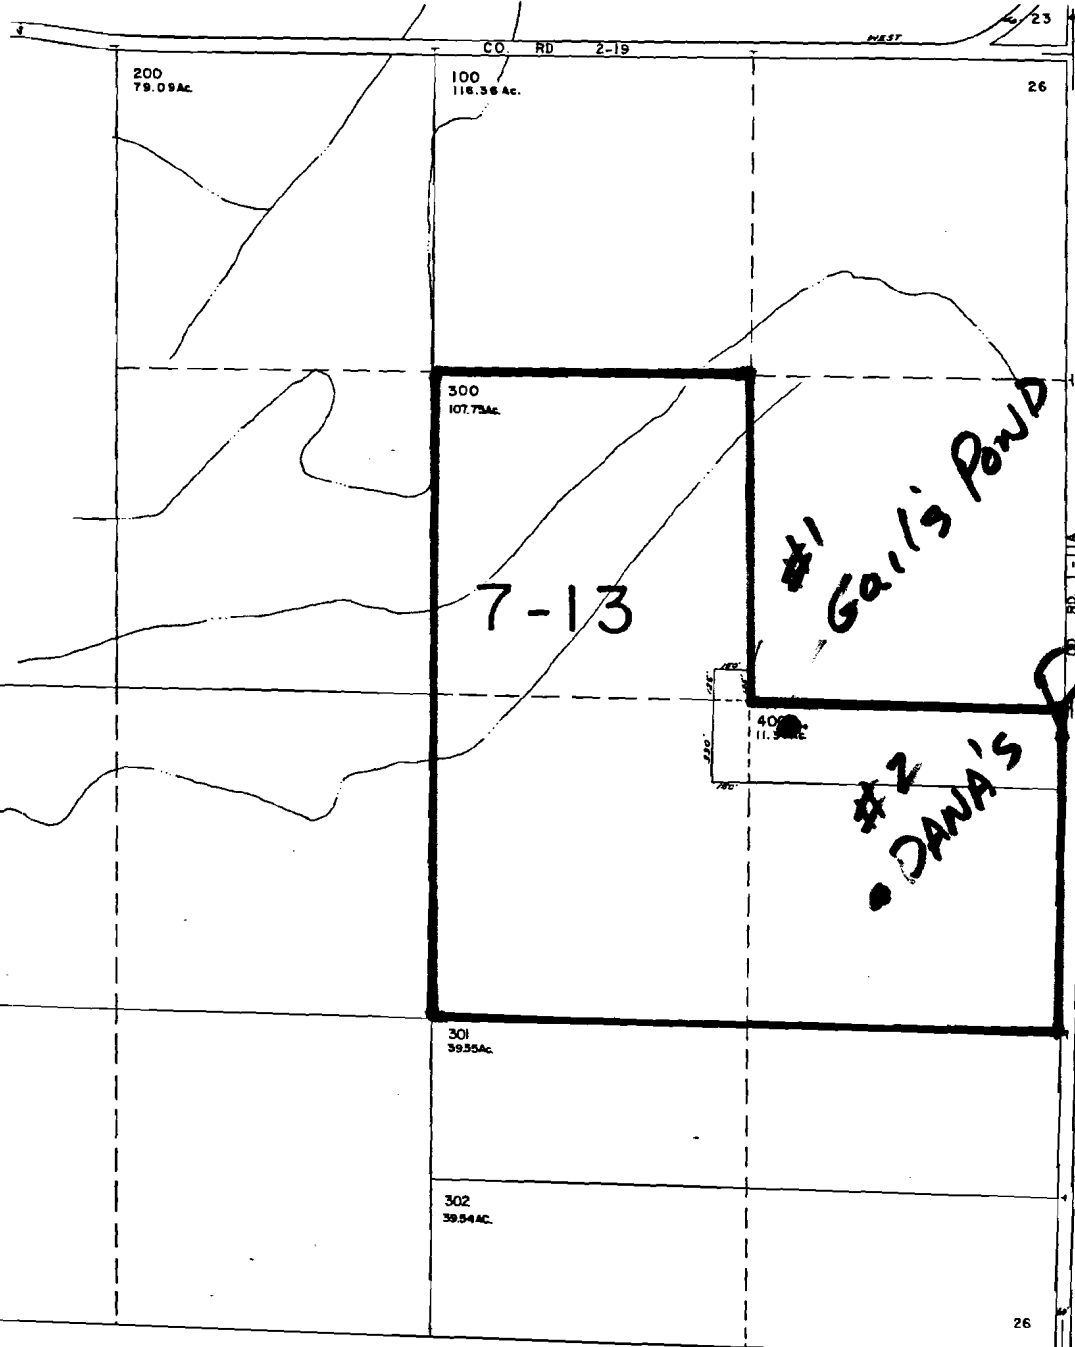

CERTIFICATE NO. 1057 SEE MAP 39 19 26

On No. P-14699
No. 1057

SCALE 1:3600



SEE MAP 39 19

1994