


LAKE

SCALE 1:48000



Application No. R74727

3022/5251

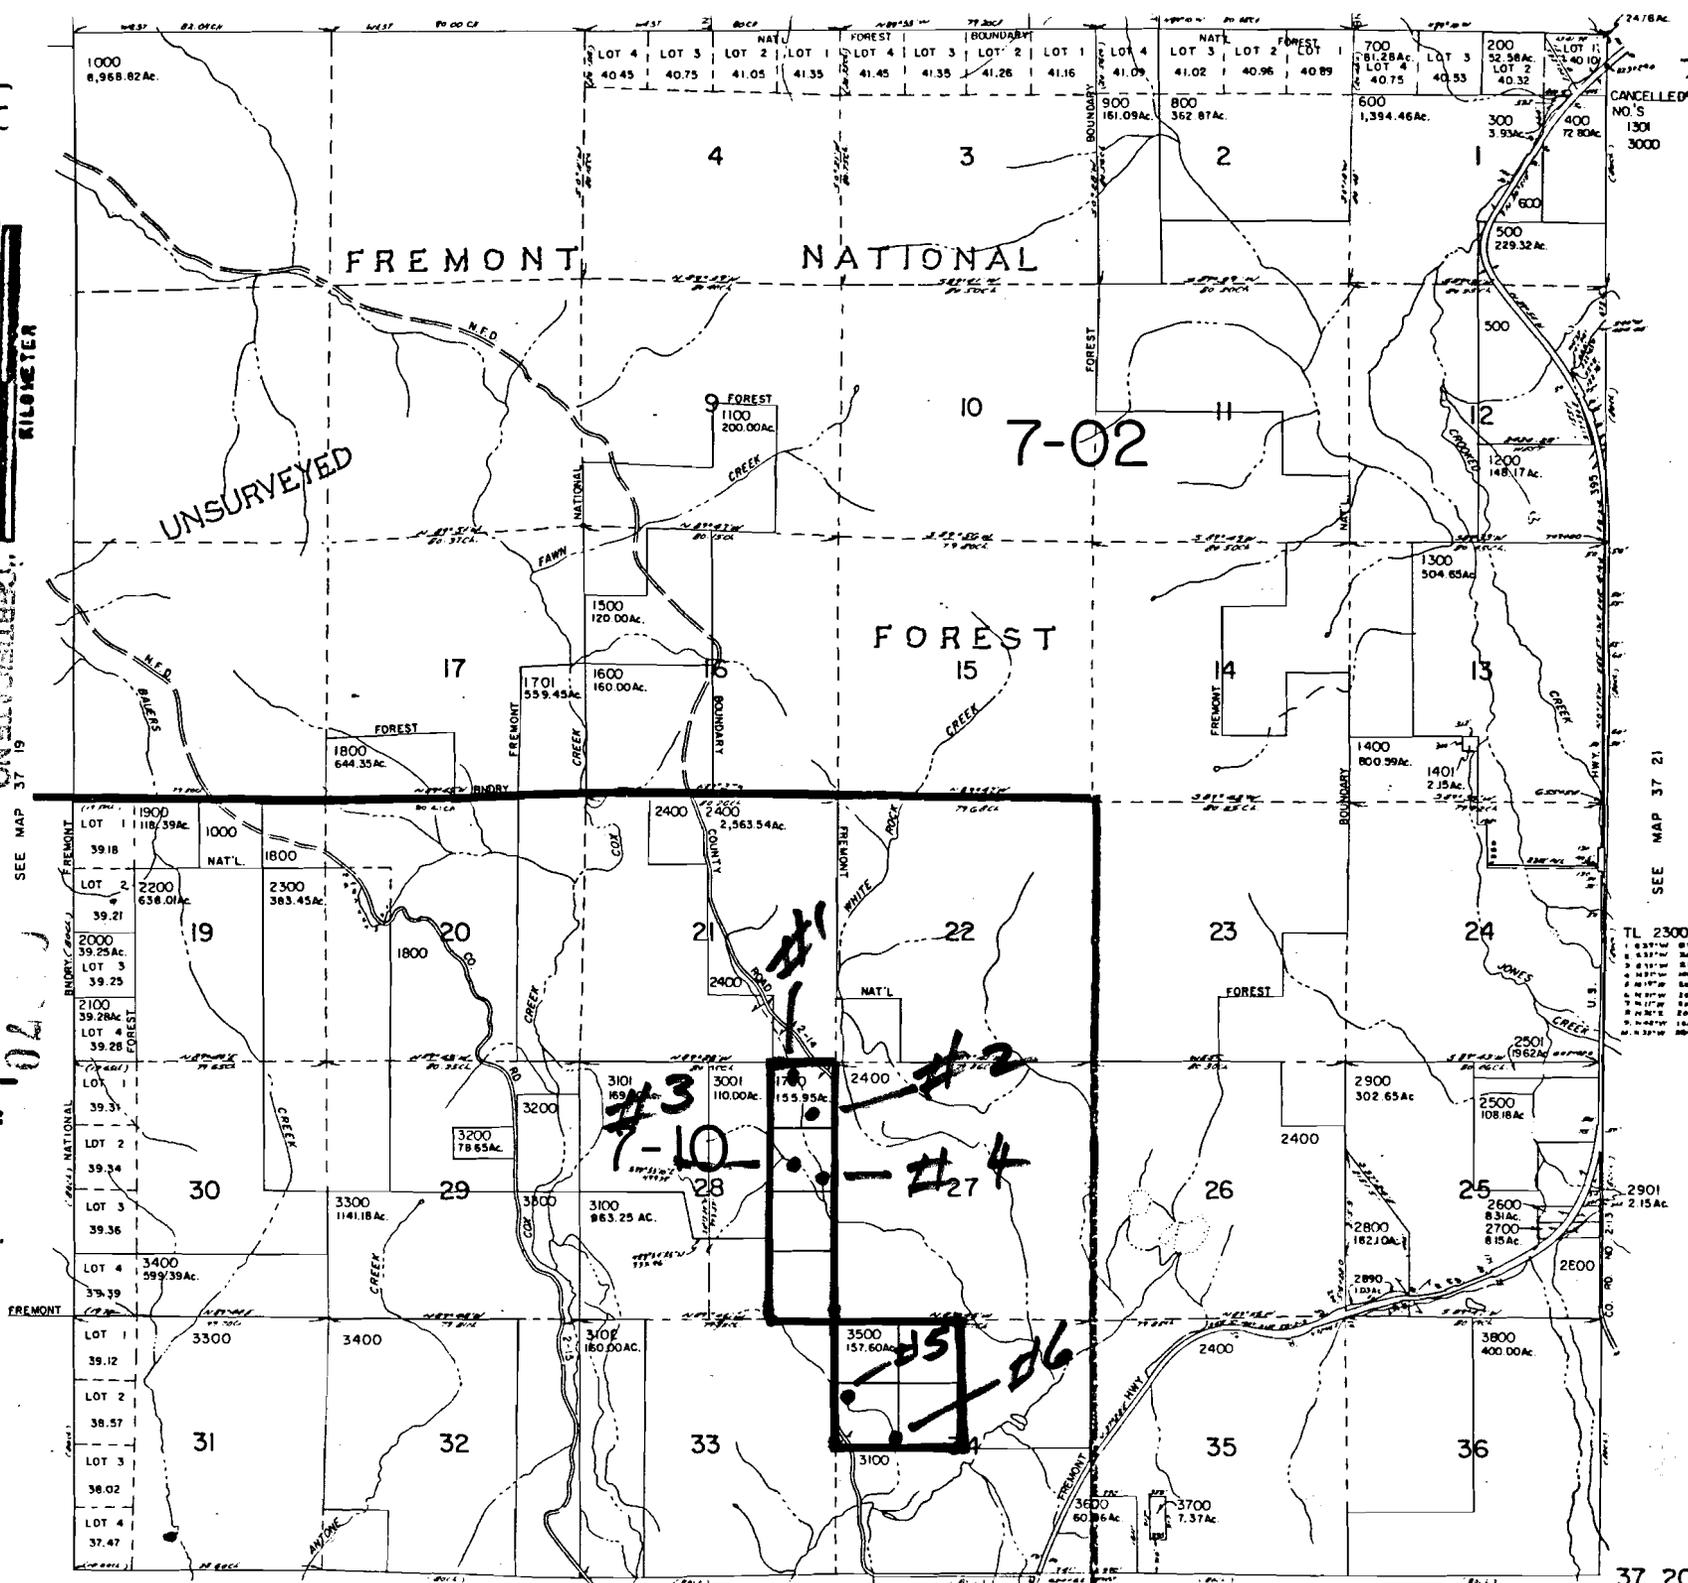

37 20

CANCELLED NO. 5 1301 3000

7-02

7-10

37 20

Permit No.

SEE MAP 37 19

SEE MAP 37 21

TL 2300
 1 637.41 Ac
 2 637.41 Ac
