


UNITED STATES
DEPARTMENT OF THE INTERIOR
GEOLOGICAL SURVEY

LAURELWOOD QUADRANGLE
OREGON
7.5 MINUTE SERIES (TOPOGRAPHIC)

DATED 1956

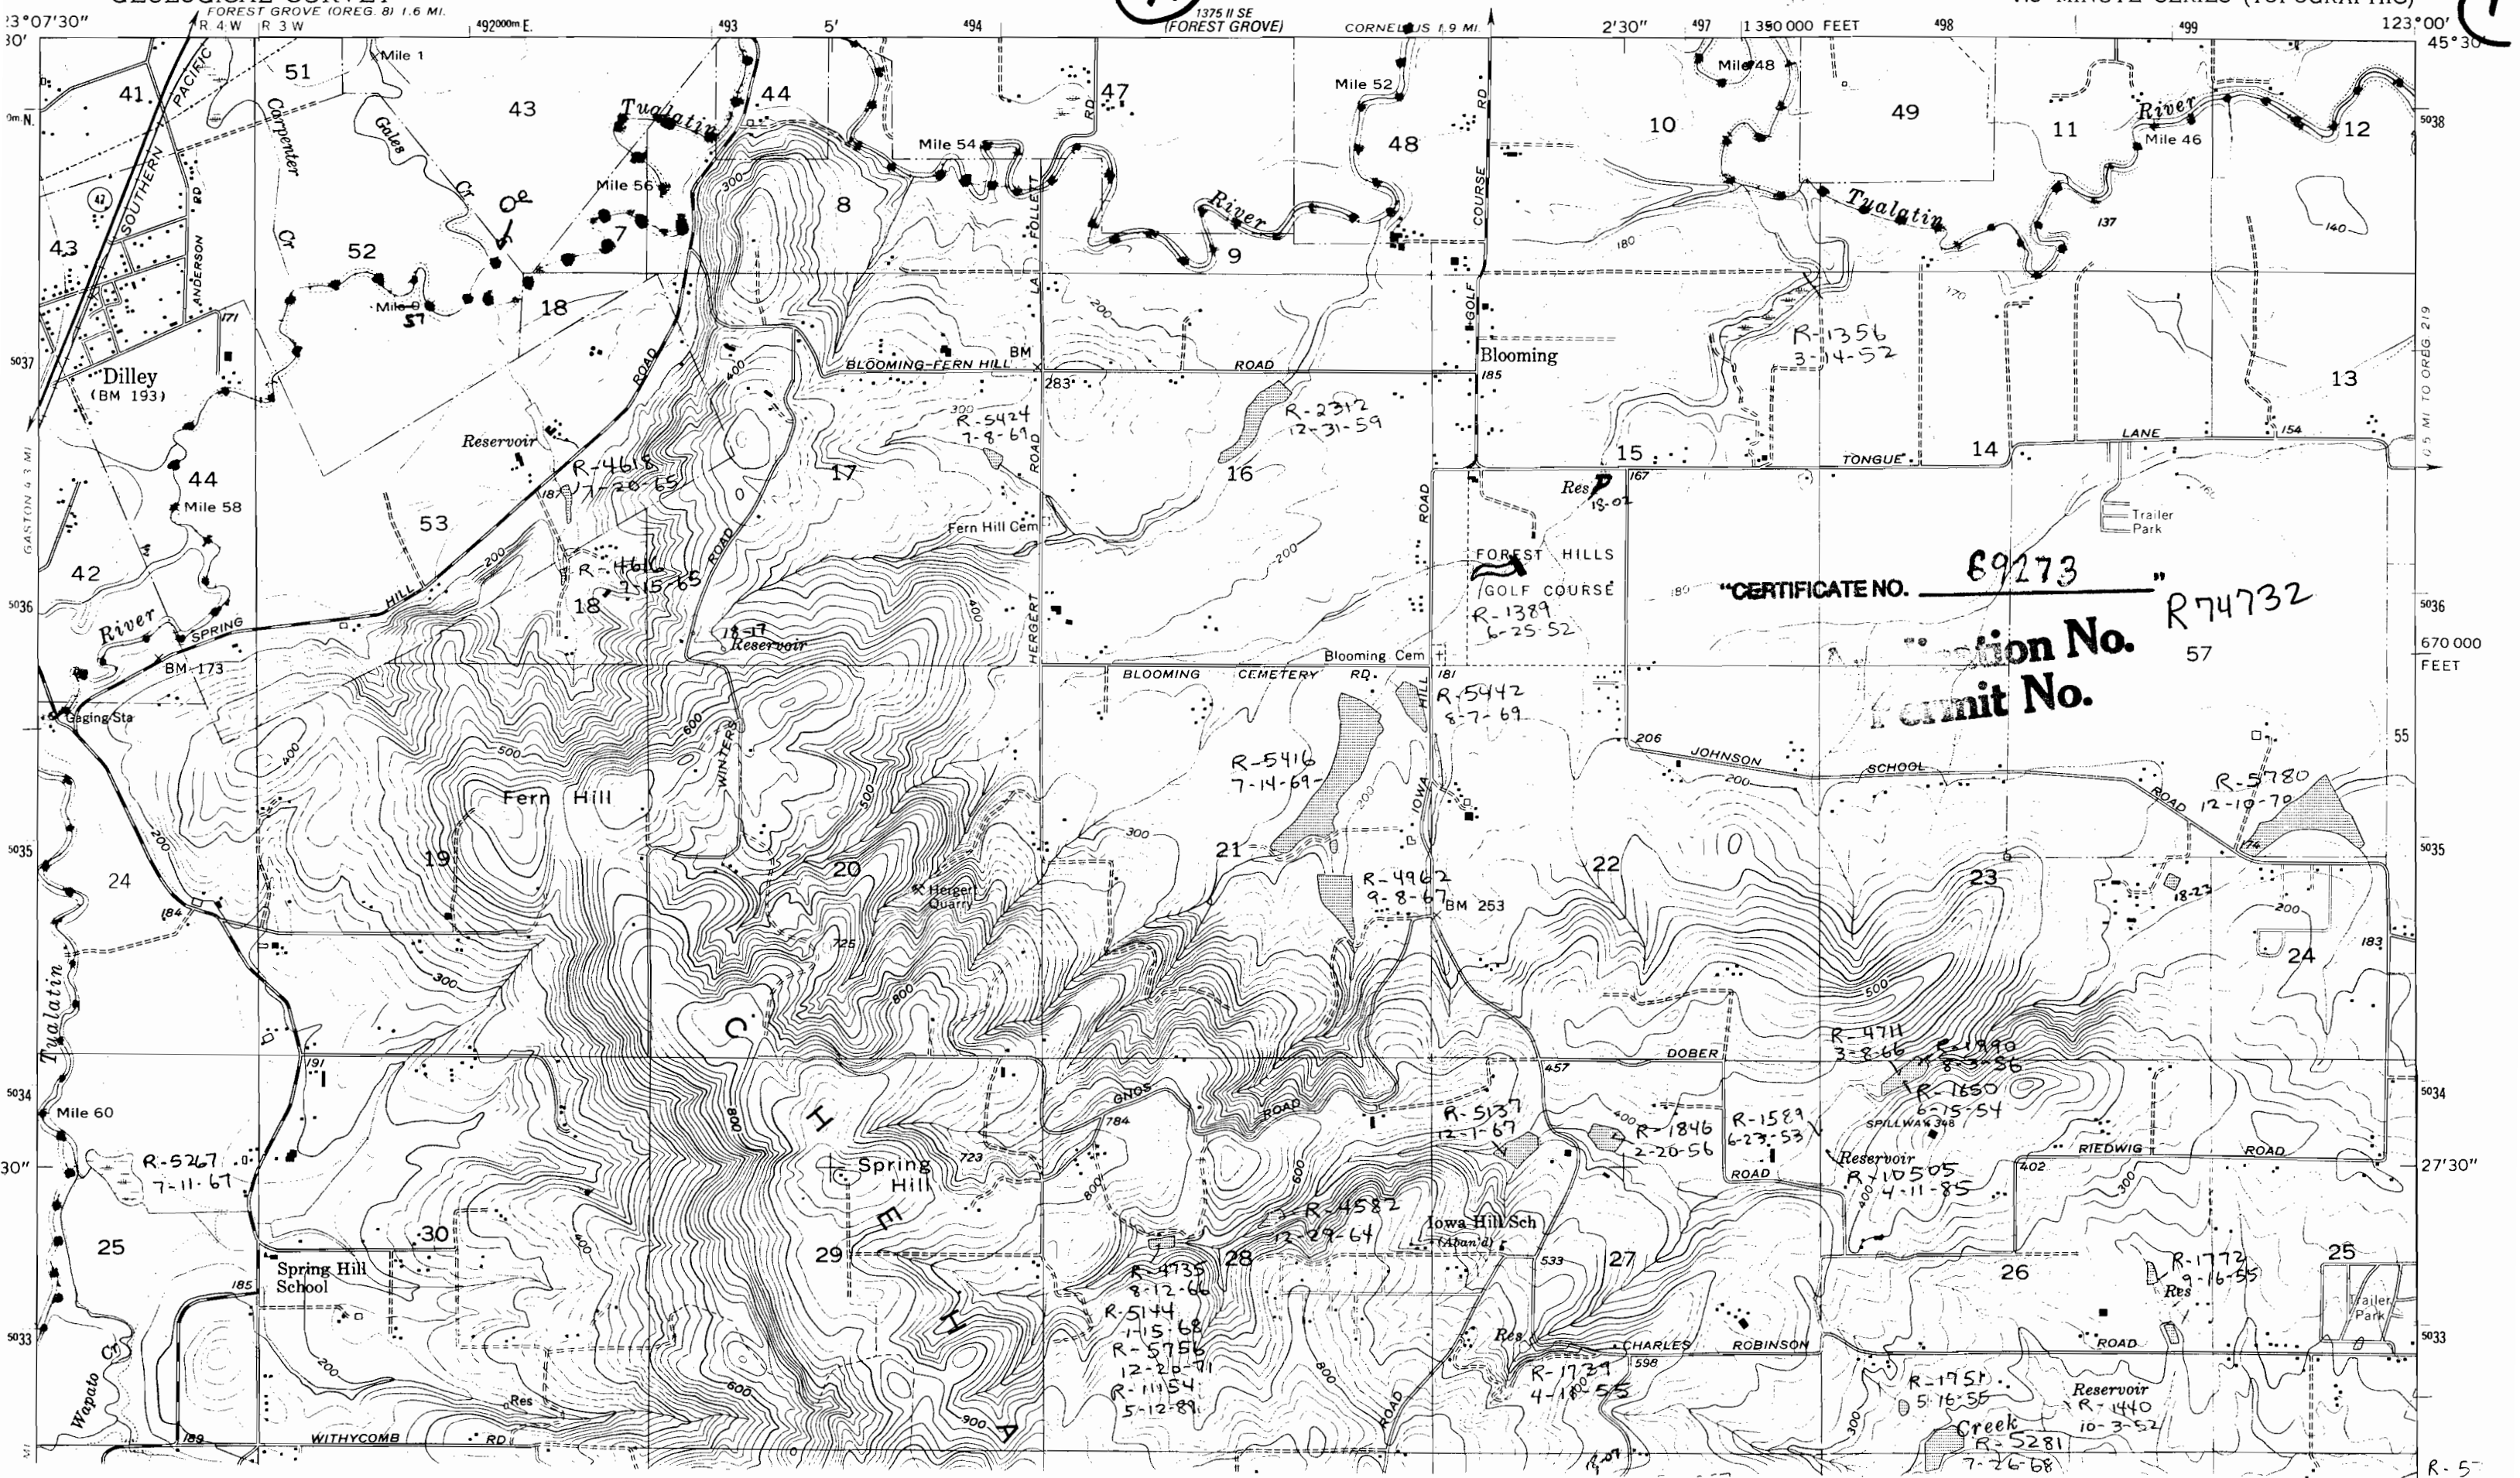

11

1475 III SW

"CERTIFICATE NO. 69273"
Permit No. 57
R 74732

R-4735 8-12-66
R-5144 1-15-68
R-5156 12-20-61
R-11454 5-12-81

R-474 3-8-66
R-1650 6-15-54
R-10505 4-11-85

R-1751 5-16-55
R-5281 7-26-68

Reservoir R-1440 10-3-52

R-5