


207

1934

T 38 S / R 20 E

1  
N  
R

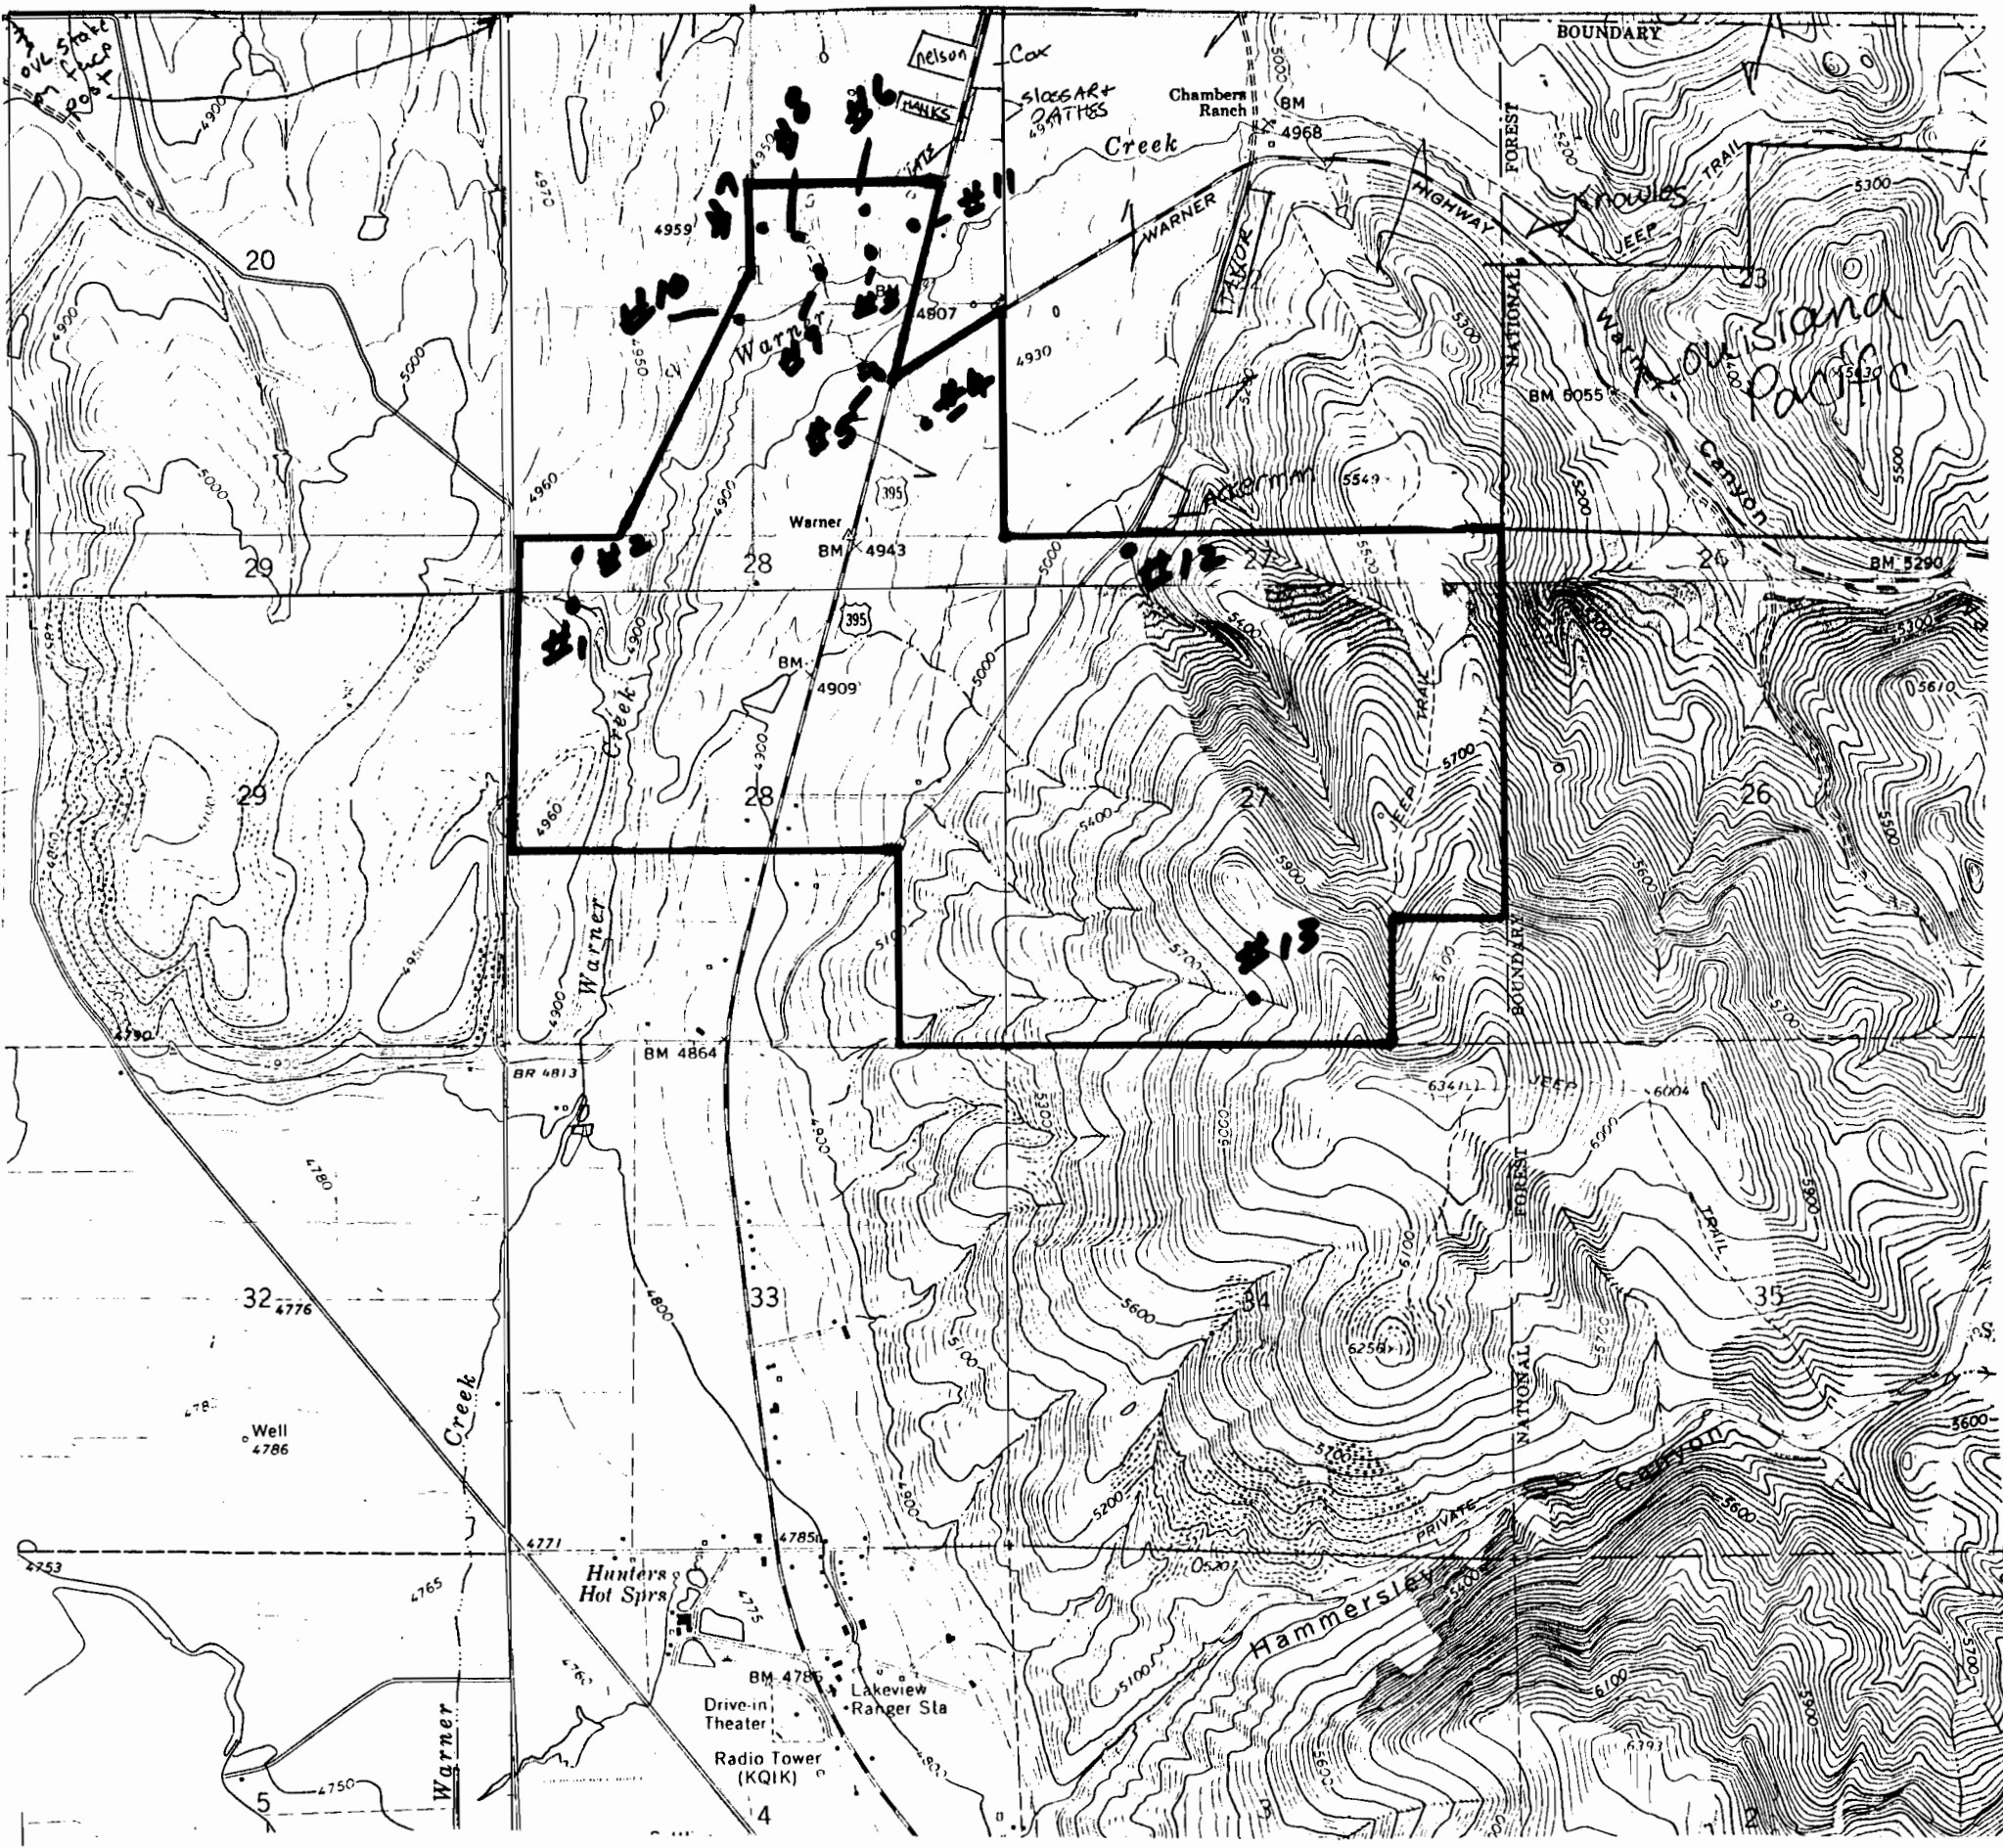

Application No. R-74829  
Permit No.

"CERTIFICATE NO. 02281"

No Final Proof Map available

No Permit Map available