


207 1934

T 38 S / R 20 E

1
N
R

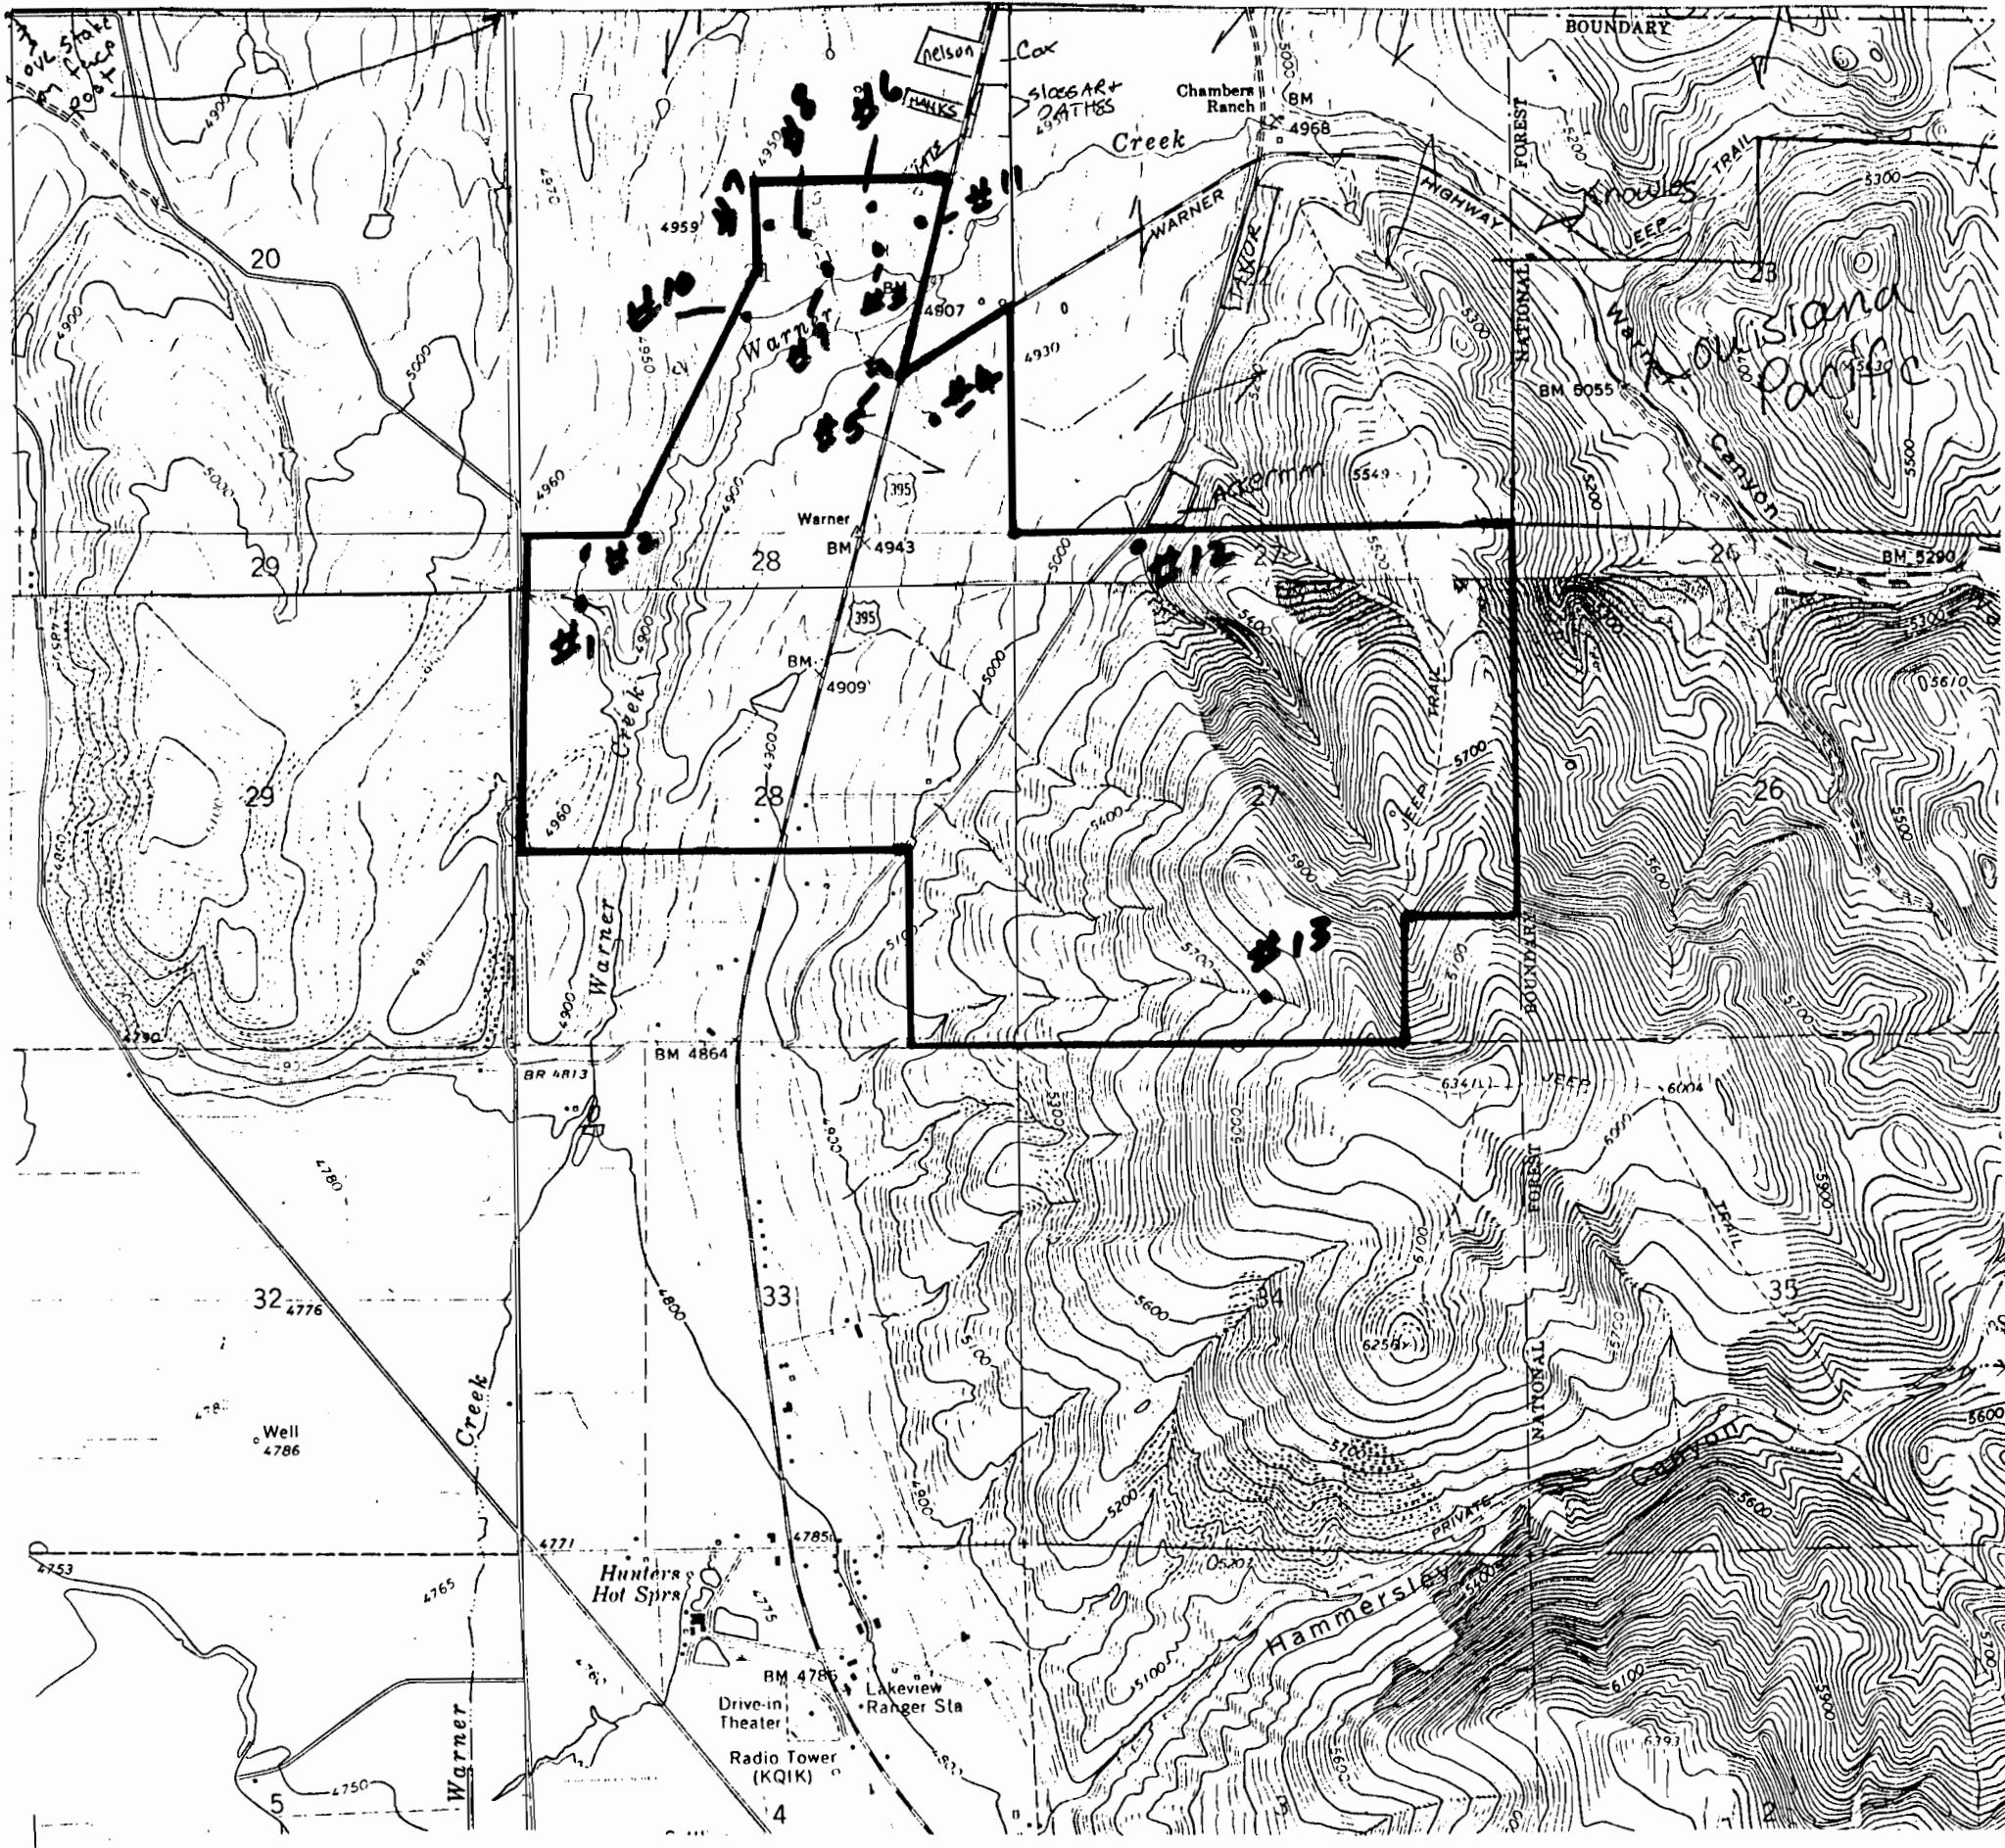

Application No. 74830
Permit No.

"CERTIFICATE NO. 62282"

No Final Proof Map available

No Permit Map available