

SECTION 32 T.27S. R.7W. W.M.  
DOUGLAS COUNTY

OCT 1994

27 7 32


THIS MAP WAS PREPARED FOR  
ASSESSMENT PURPOSE ONLY.

1"=400'

Application No. R-74836  
Permit No.

SEE MAP 27 7 29

CERTIFICATE NO. 69286

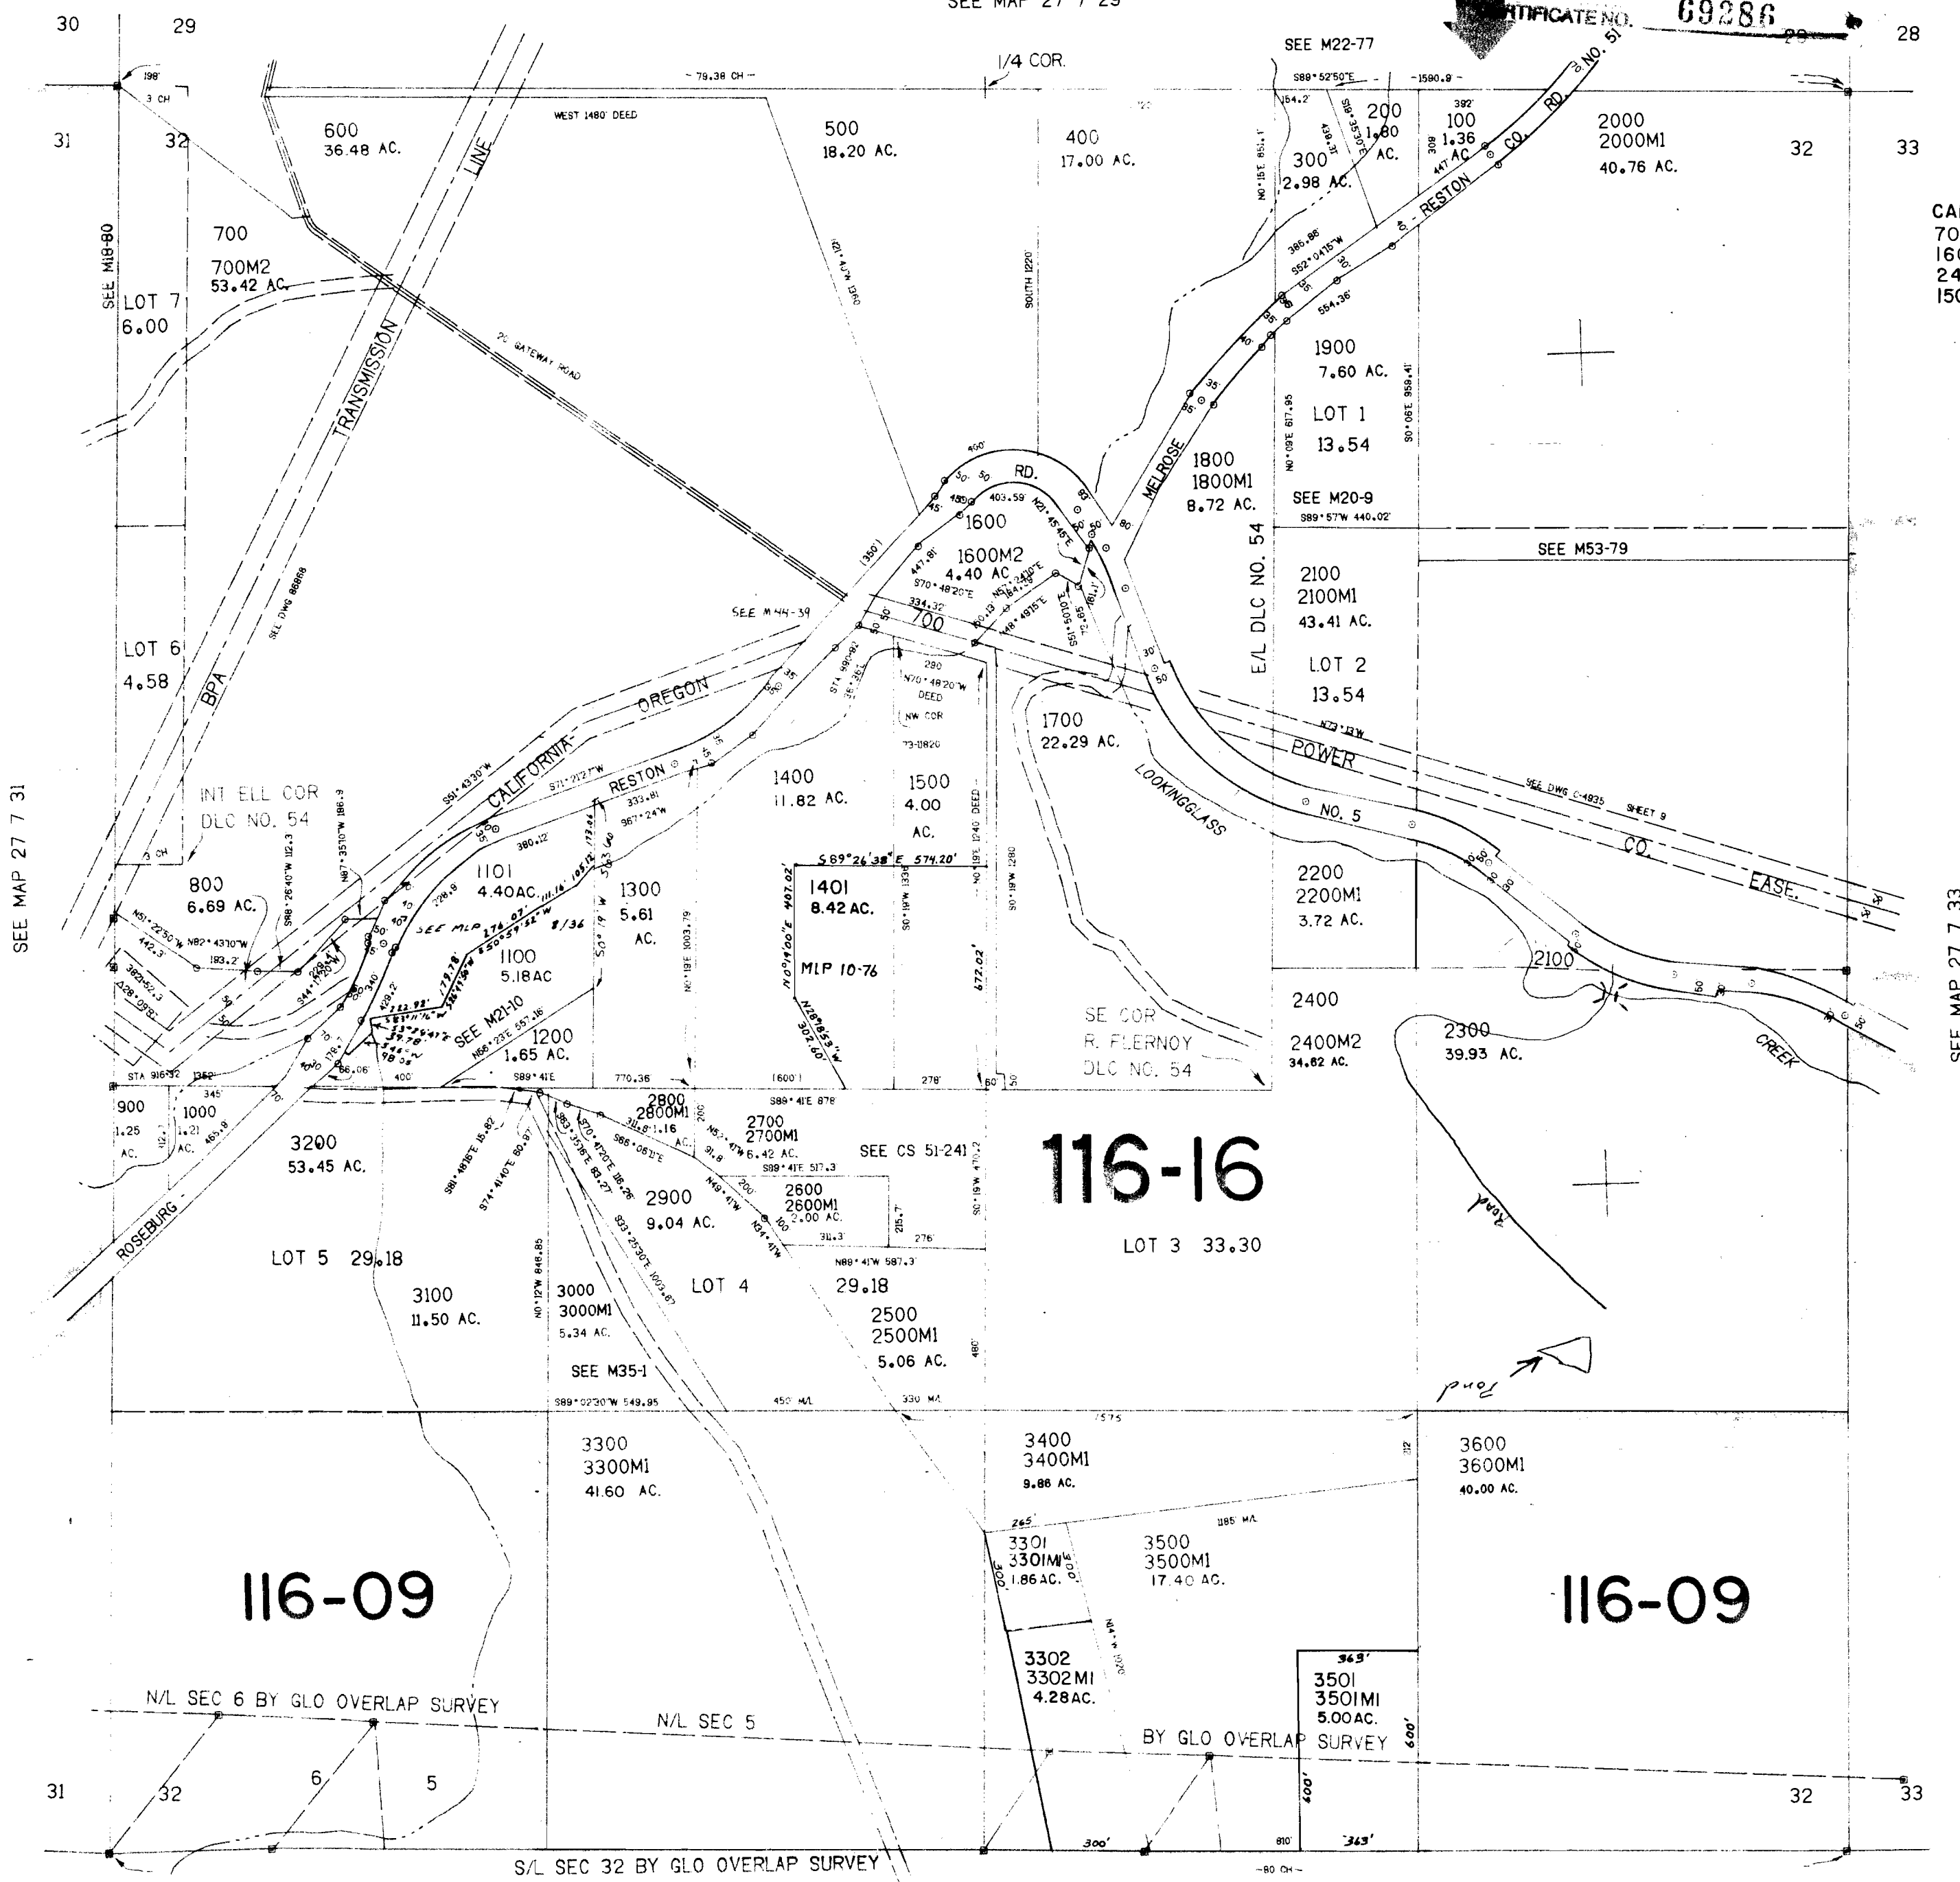

CANCELLED NO'S  
700MI  
1600MI  
2400MI  
150I

565.000

SEE MAP 28 7 6

SEE MAP 28 7 5

5 4

27 7 32

182.500

No Final Proof Map available

No Permit Map available