


"CERTIFICATE NO. 37"

Application No. R-74838
Permit No.

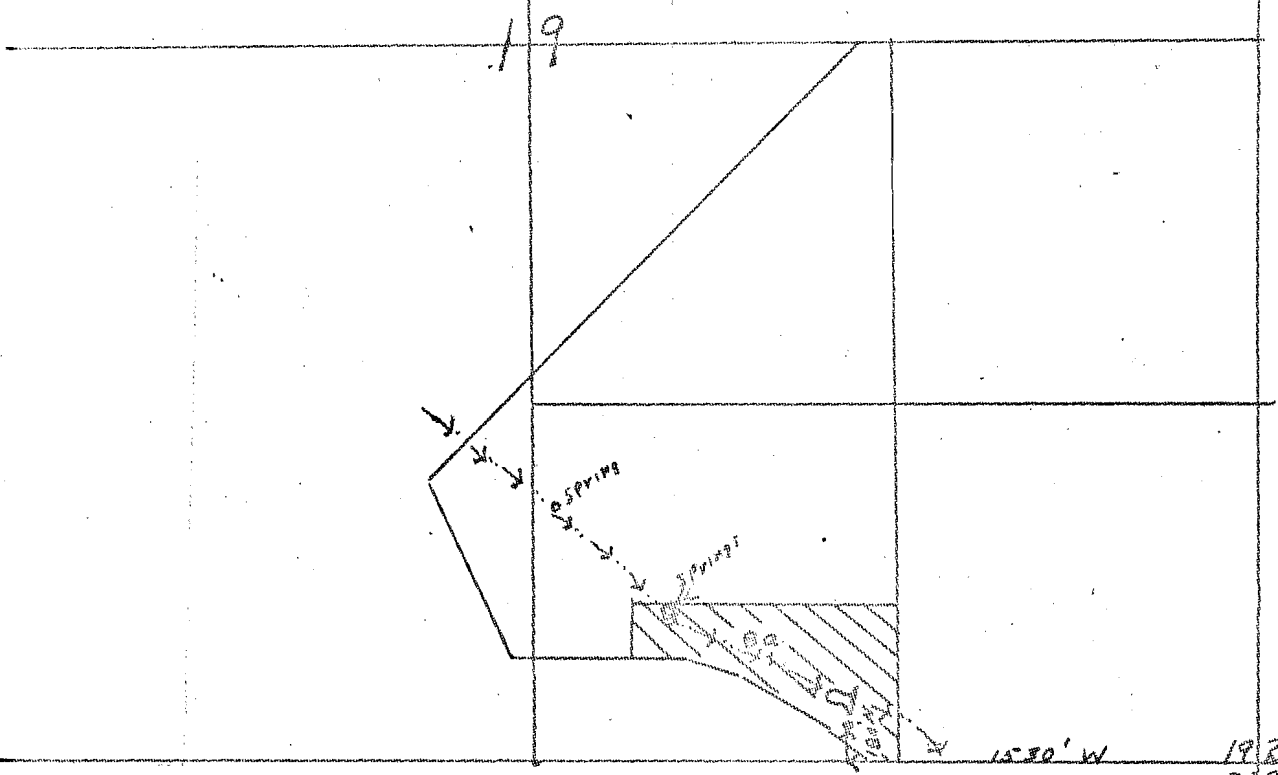

1920
3029

Mr. A. L. Clay, Cartwright Farm
Township 8 South Range 3 West
Scale - 1" = 660'

Wallace Dawson
Soil Conservation Service
Staxton Ore
2-25-59

No Final Proof Map available

No Permit Map available