


SECTION 23 T.39S R.19E.W.M.
LAKE COUNTY
1" = 400'

SCALE 1:9600



SEE MAP 39 19 14

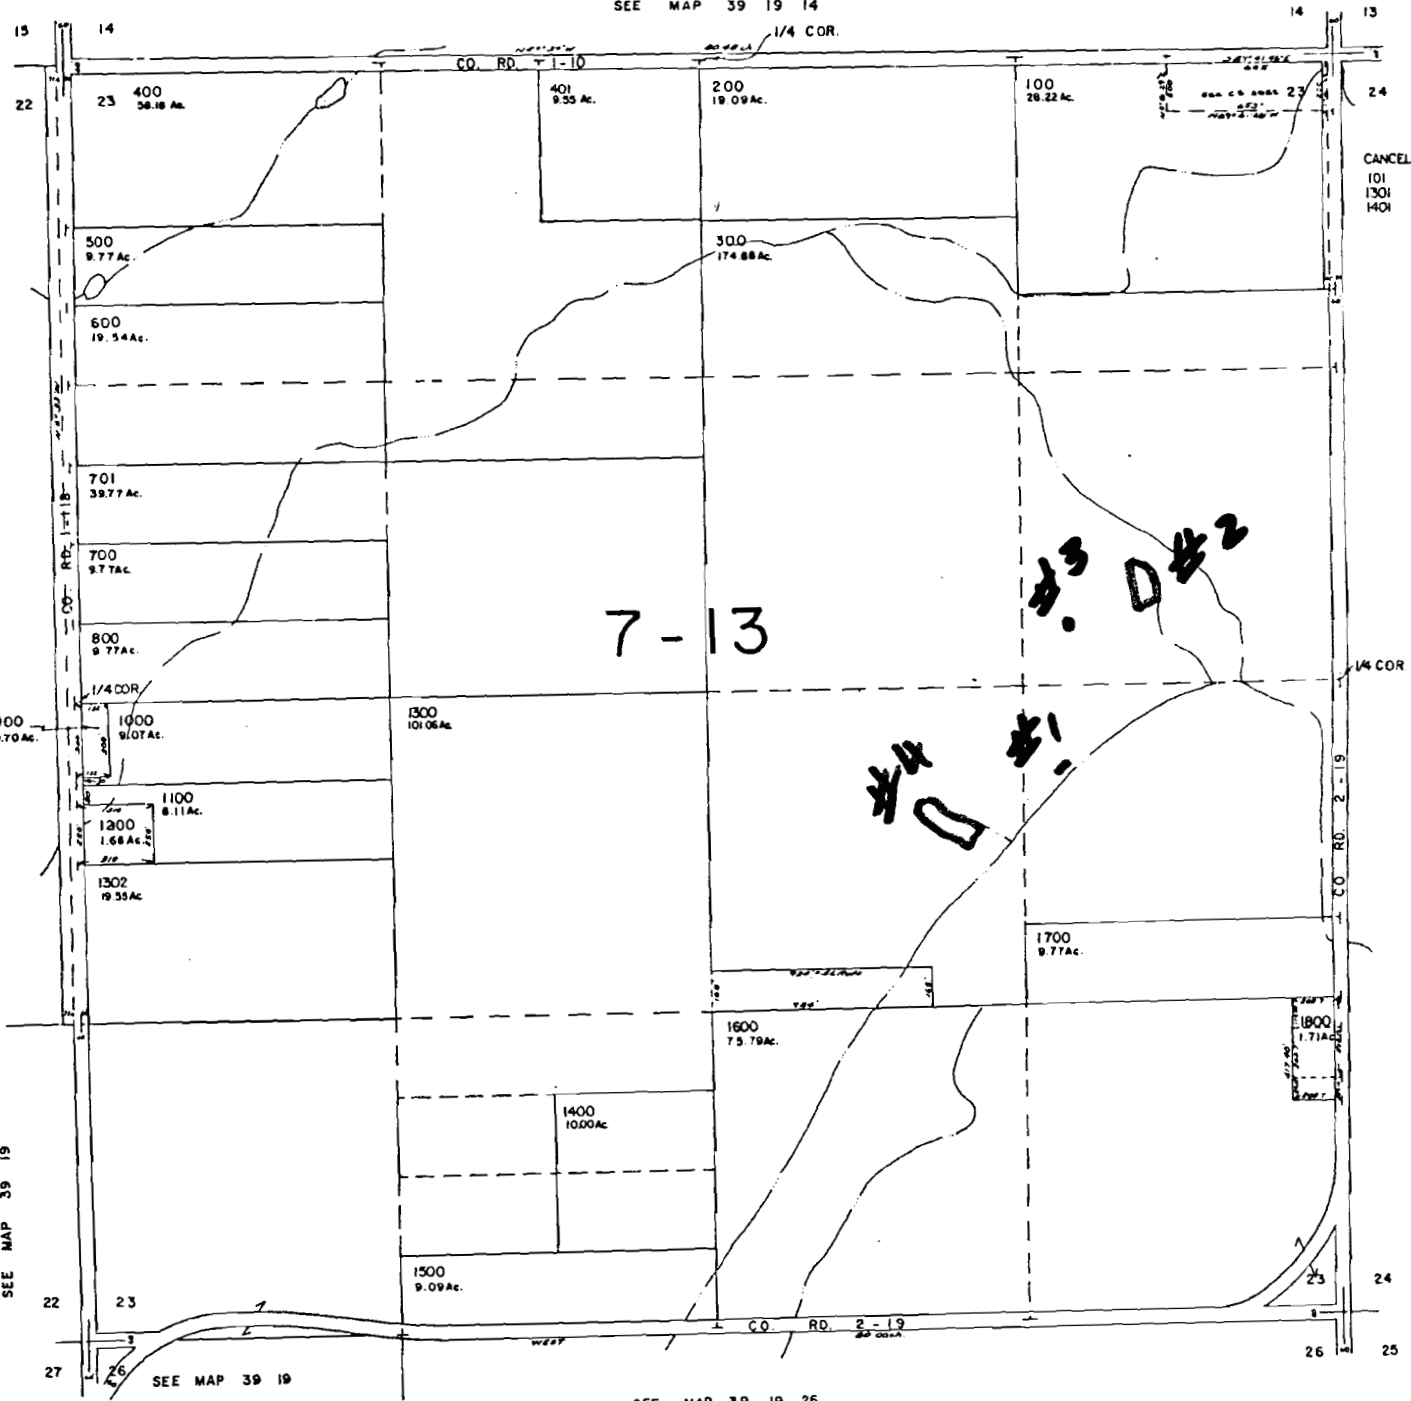

CANCELLED NO'S
101
1301
1401

SEE MAP 39 19

SALEM, OREGON

NOV - 2 1994

CERTIFICATE NO. 39

R-7484

SEE MAP 39 19 22

SEE MAP 39 19

SEE MAP 39 19

SEE MAP 39 19 26

No Final Proof Map available

No Permit Map available