
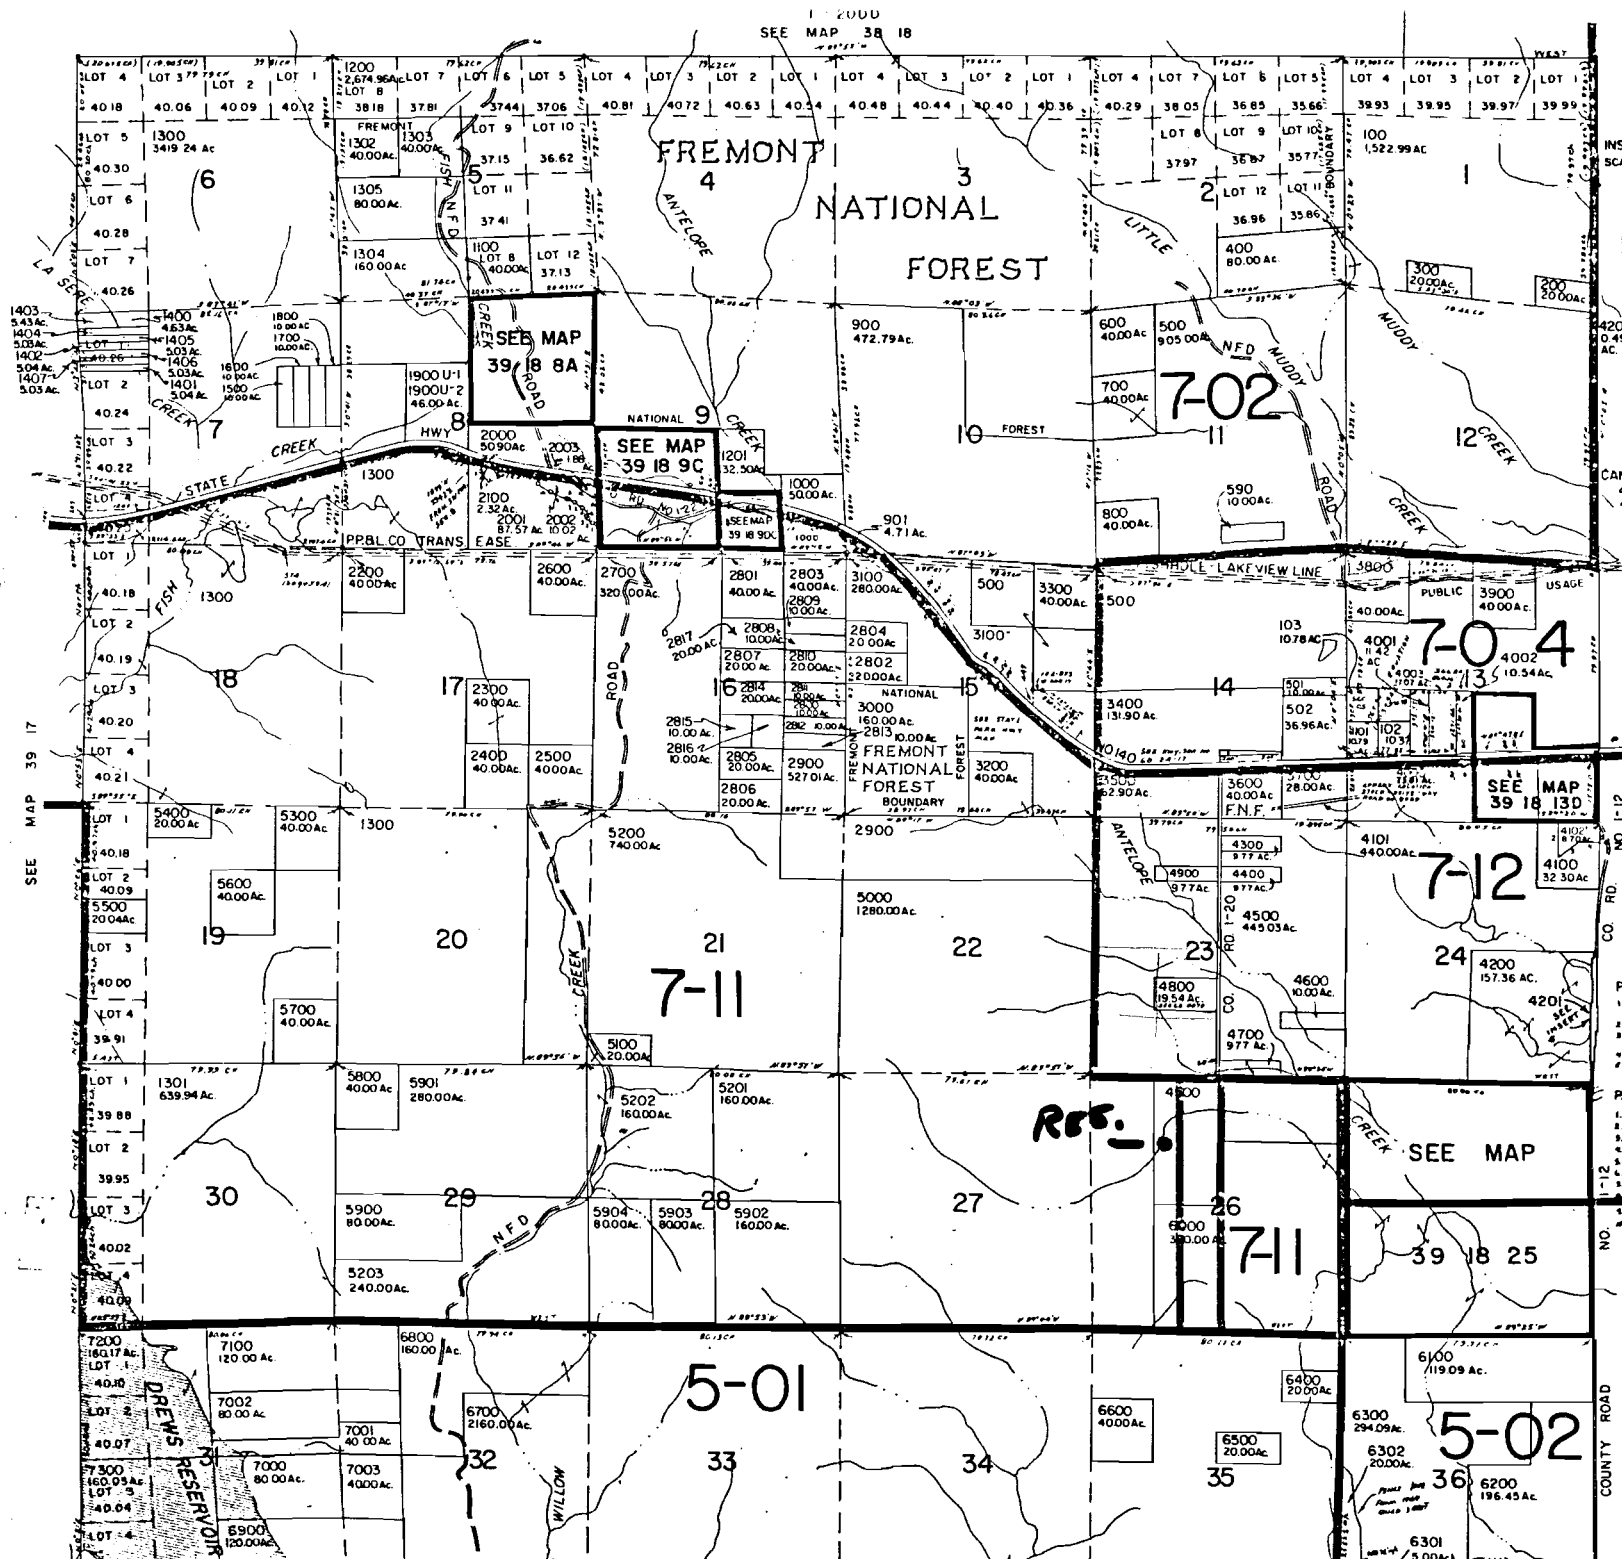


39 18

SCALE 1:48000

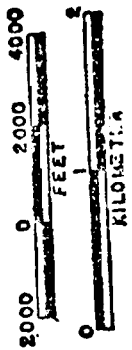

SEC. 8
PARCEL 2002

1. N 10° 45' 01" E 40.91'
2. N 40° 10' 00" E 100.54'
3. N 20° 00' 00" E 39.47'
4. N 27° 41' 00" E 91.21'
5. N 10° 00' 00" E 107.80'
6. N 10° 00' 00" E 117.50'
7. N 10° 00' 00" E 117.50'
R-74843

CERTIFICATE NO.

NOV 22 1994
REGISTRATION DEPT
OREGON

INSERT SEC. 24
SCALE 1:200

CANCELLED NOS
4005
4004

SEC. 24
PARCEL 4102:

PARCEL 4201:

SEE MAP

39 18 25

NO.

COUNTY ROAD

NO.

NO.

NO.

NO.

No Final Proof Map available

No Permit Map available