


H32153 RECEIVE R74848  
1-1-93  
JLI GA  
NOV 03 1993 AMT R Misc

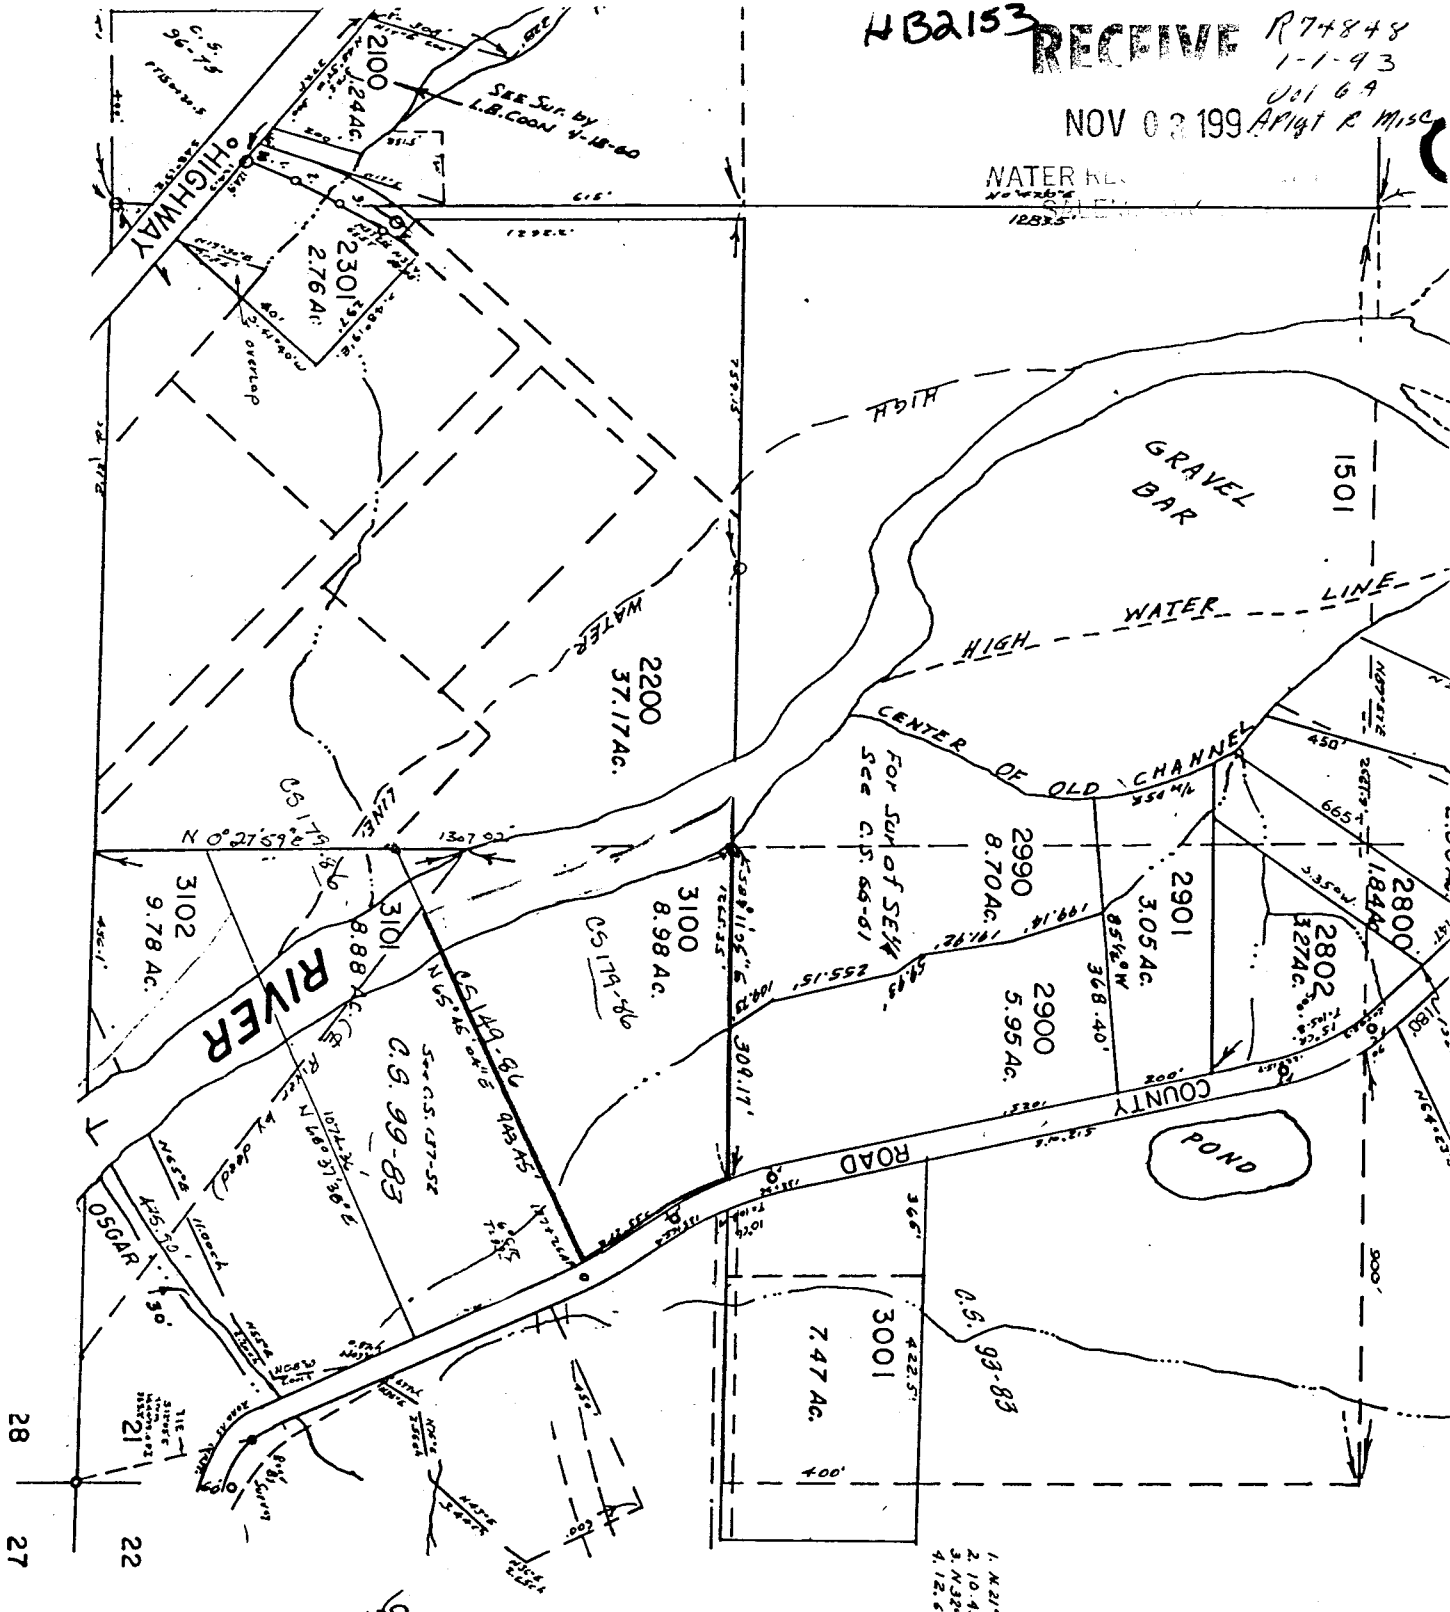

SEE MAP

Map No. R 74848  
Permit No.

CERTIFICATE NO. 69292

# MAP SHOWING LOCATION OF RESERVOIR


LOCATED IN: T. 37 S., R. 5 W., W.M.  
SECTION 21

**APPLICANT:**  
**H. LOWELL IRWIN &**  
**MARGARET A. IRWIN**  
**9245 N. APPLGATE ROAD**  
**GRANTS PASS, OR 97527**

1994



SCALE: 1" = 400'

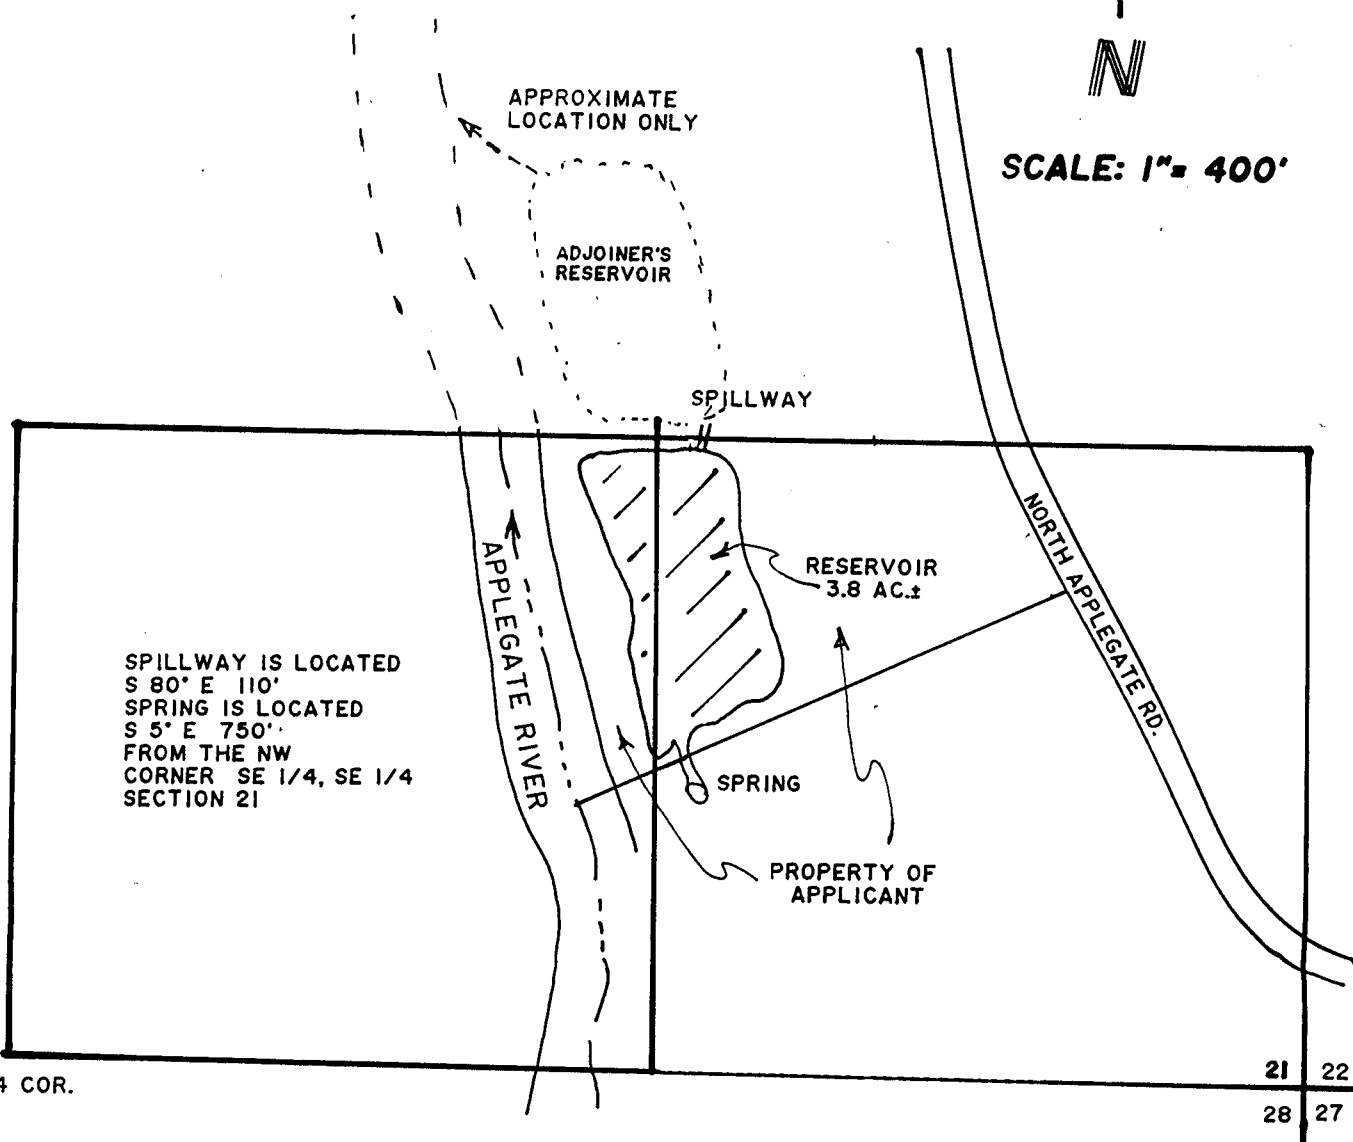


SPILLWAY IS LOCATED  
S 80° E 110'  
SPRING IS LOCATED  
S 5° E 750'  
FROM THE NW  
CORNER SE 1/4, SE 1/4  
SECTION 21

THIS MAP IS FOR THE PURPOSE OF  
IDENTIFYING THE LOCATION OF THE  
WATER RIGHT ONLY AND IS NOT IN-  
TENDED TO PROVIDE LEGAL DIMEN-  
SIONS OR LOCATIONS OF PROPERTY  
OWNERSHIP LINES.

CERTIFICATE NO. 69292

PREPARED BY:  
**JONATHAN C. SPERO W.R.E. 123**  
**1002 KINCAID RD./P.O. BOX 16**  
**WILLIAMS, OREGON 97544**  
**PHONE (503) 848-8848**

*No. R-74848*  
*Permit No.*

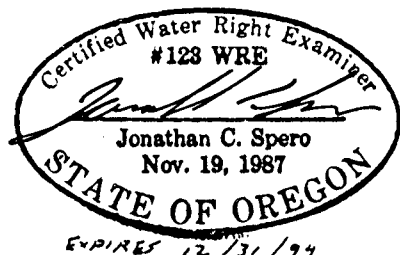

AUGUST 17, 1994