

RECEIVED

JUN 28 1994

WATER RESOURCES DEPT. SALEM, OREGON


09301

PROJECT NO.

783W 19
81M 21
R-74863

Applicant No. R-74863

Tract No.

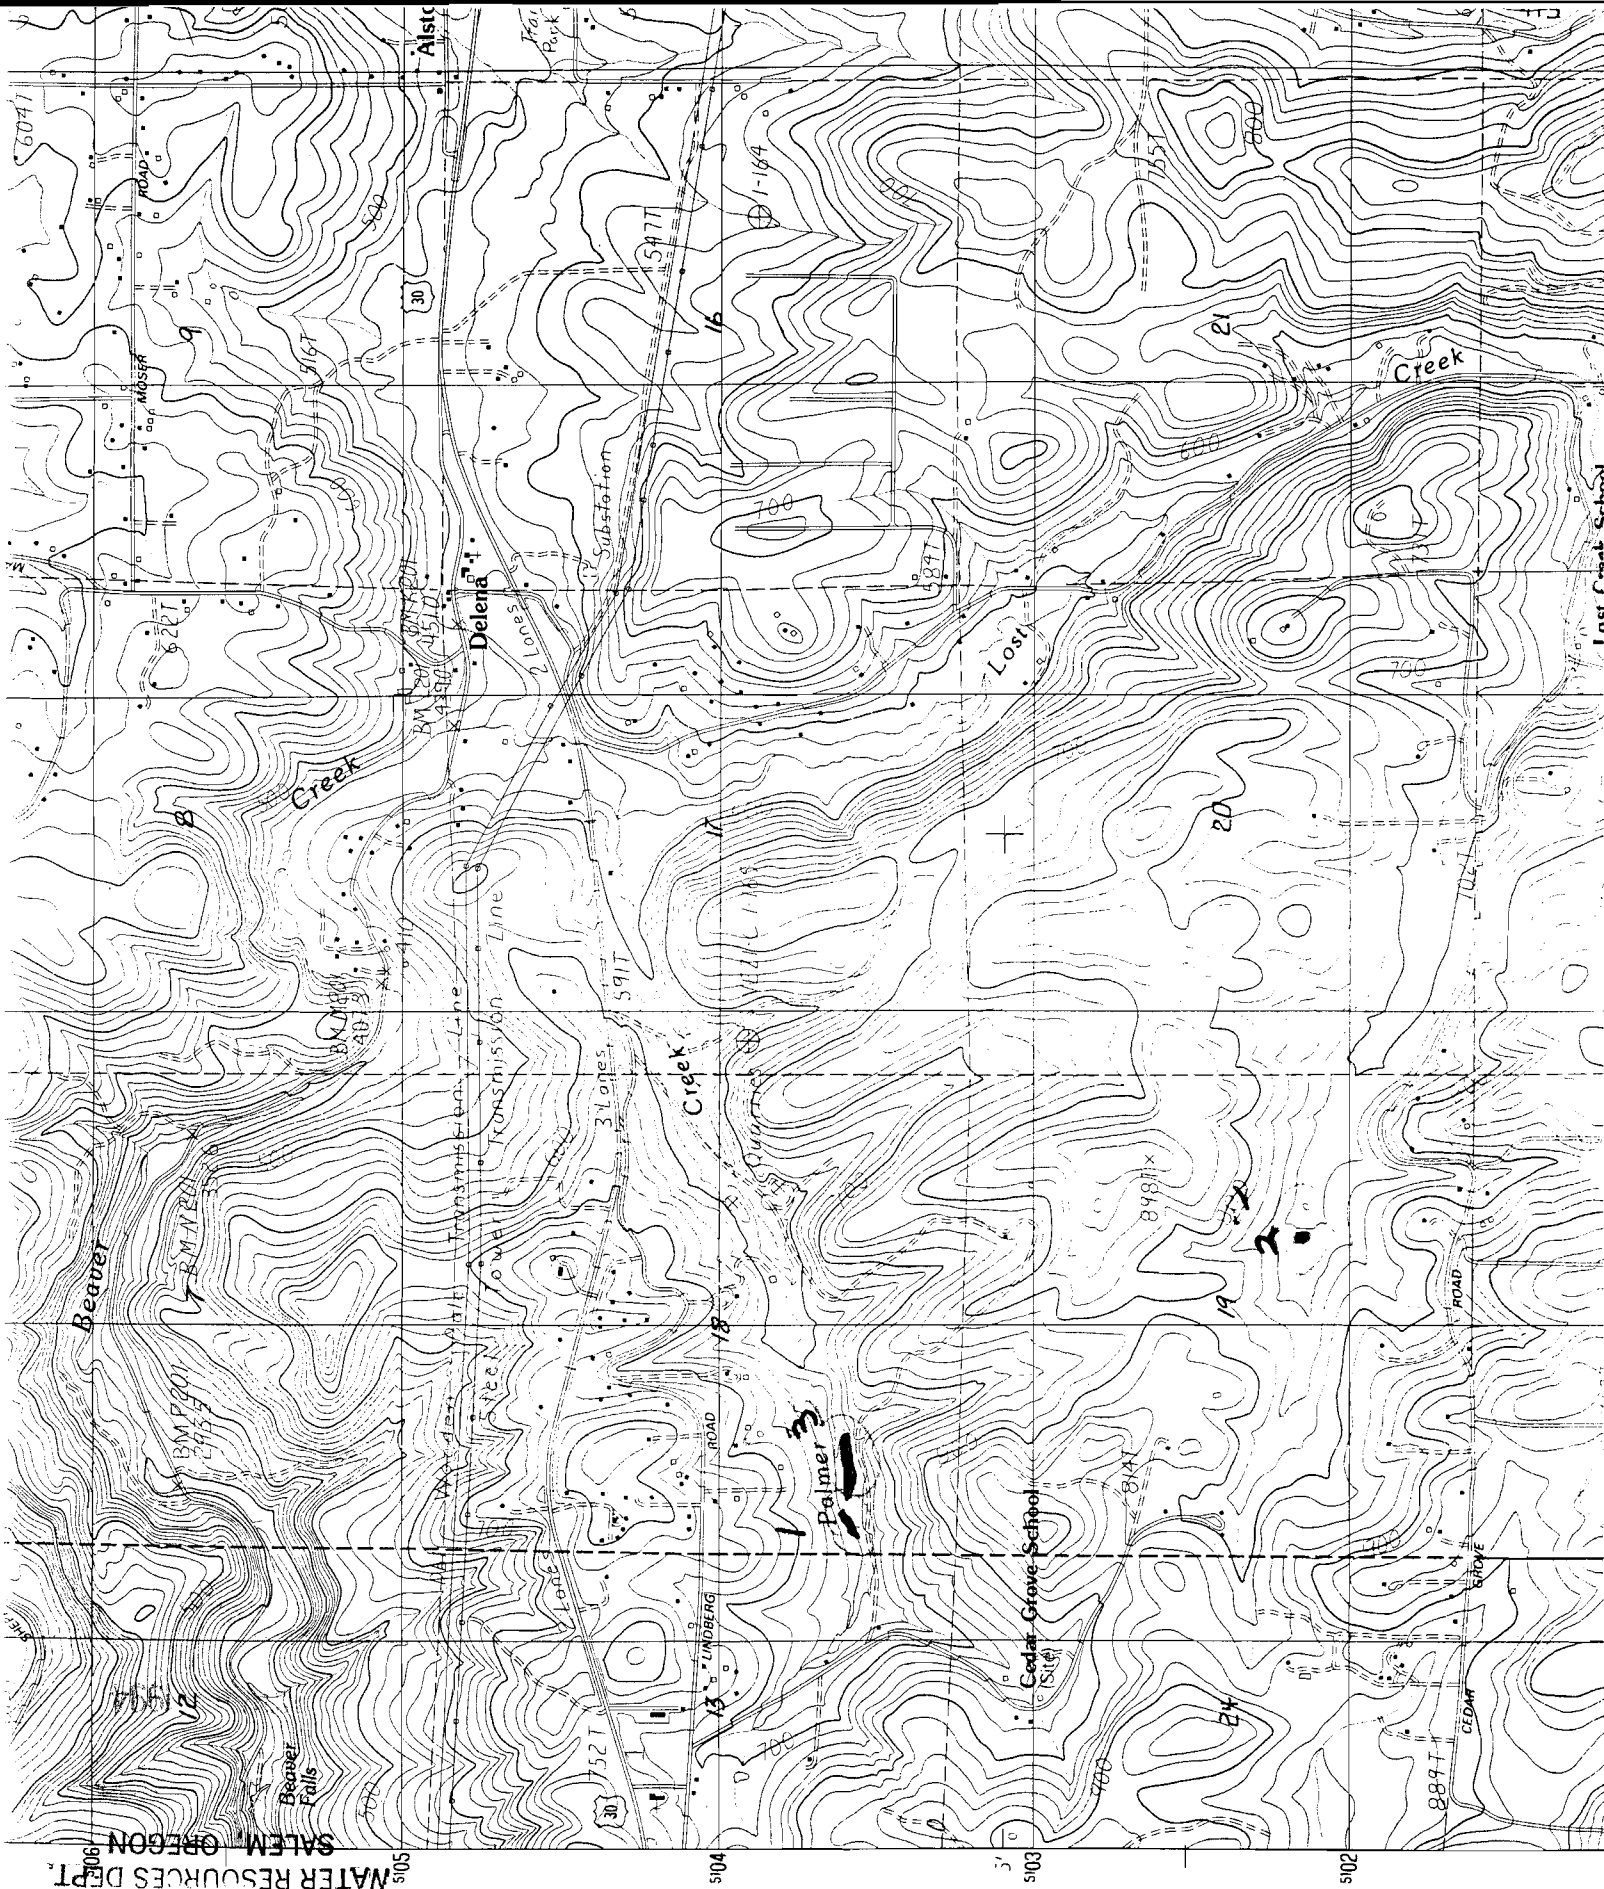

No Final Proof Map available

No Permit Map available