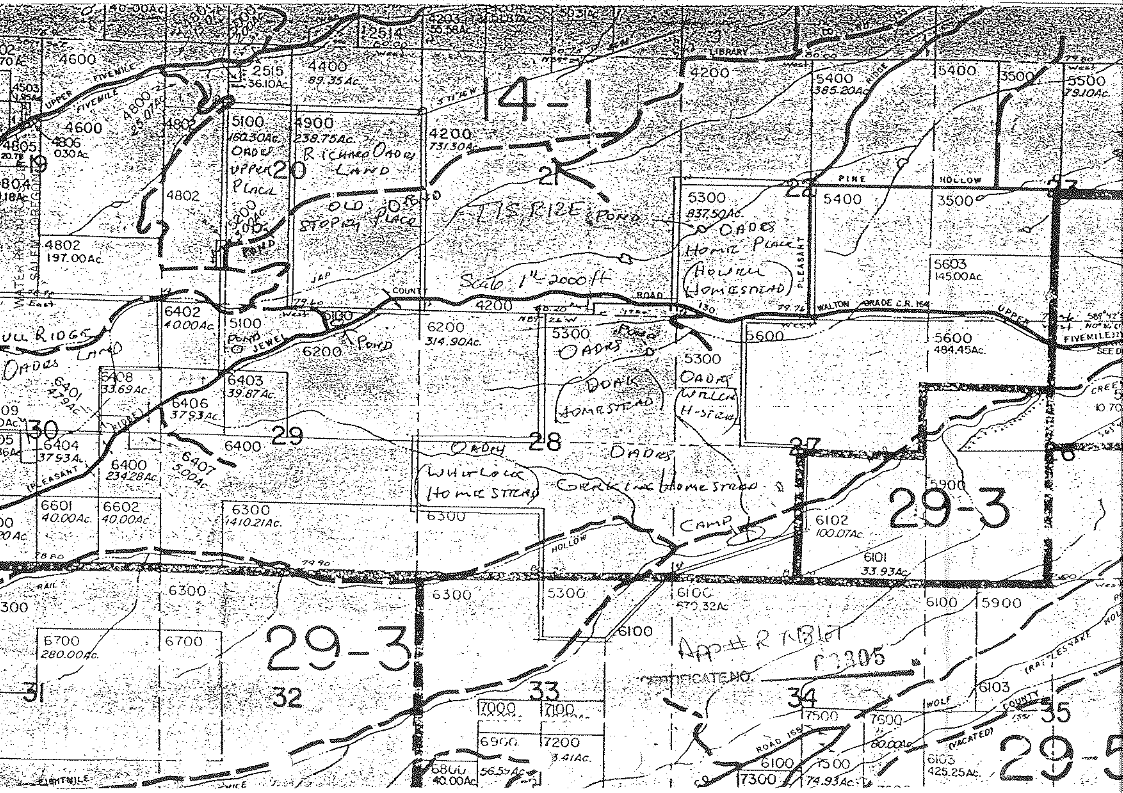
14-1
29-3
29-3
Scale 1" = 2000 ft
TTS RIDE
OLD STOPPING PLACE
Richard Oades Land
Oades Upper Place
Oades Home Place
Howell Homestead
Oades Doak Homestead
Oades Welch H-stead
Whitlock Homestead
Gerking Homestead
Camp
Pond
App # R 76167
CERTIFICATE NO.
UPPER FIVEMILE
PINE HOLLOW
WALTON GRADE C.R. 164
PLEASANT
LIBRARY
JEWEL
COUNTY ROAD
HOLLOW
WOLF
ROAD 168
RATTLESNAKE
EIGHTMILE
SEED
4200
731.30Ac.
5300
837.50Ac.
5400
385.20Ac.
5600
484.45Ac.
5603
145.00Ac.
6200
314.90Ac.
6300
1410.21Ac.
6102
100.07Ac.
6101
33.93Ac.
6700
280.00Ac.
5100
160.30Ac.
4900
238.75Ac.
4400
89.35Ac.
2515
36.10Ac.
4802
197.00Ac.
6402
40.00Ac.
6403
39.87Ac.
6406
37.93Ac.
6408
33.69Ac.
6400
234.28Ac.
6407
5.00Ac.
6601
40.00Ac.
6602
40.00Ac.
6103
425.25Ac.
5500
79.10Ac.
4203
55.58Ac.
WATER RESOURCES DEPT
SALEM, OREGON