


Application No. R-7487d
 Section No. 11

RECEIVED
 AUG 8 1986
 WATER RESOURCES DEPT.
 SALEM OREGON


Mapped, edited, and published by the Geological Survey
 Control by USGS and USC&GS

Topography by photogrammetric methods from aerial
 photographs taken 1963 and planetable surveys 1965
 Polyconic projection. 1927 North American datum
 10,000-foot grid based on Oregon coordinate system,
 north zone
 1000 meter Universal Transverse Mercator grid ticks,
 zone 11, shown in blue
 Fine red dashed lines indicate selected fence lines

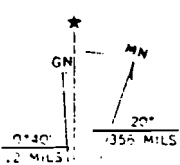


UTM GRID AND 1965 MAGNETIC NORTH
 DECLINATION AT CENTER OF SHEET


CONTOUR INTERVAL 5 FEET
 DATUM IS MEAN SEA LEVEL

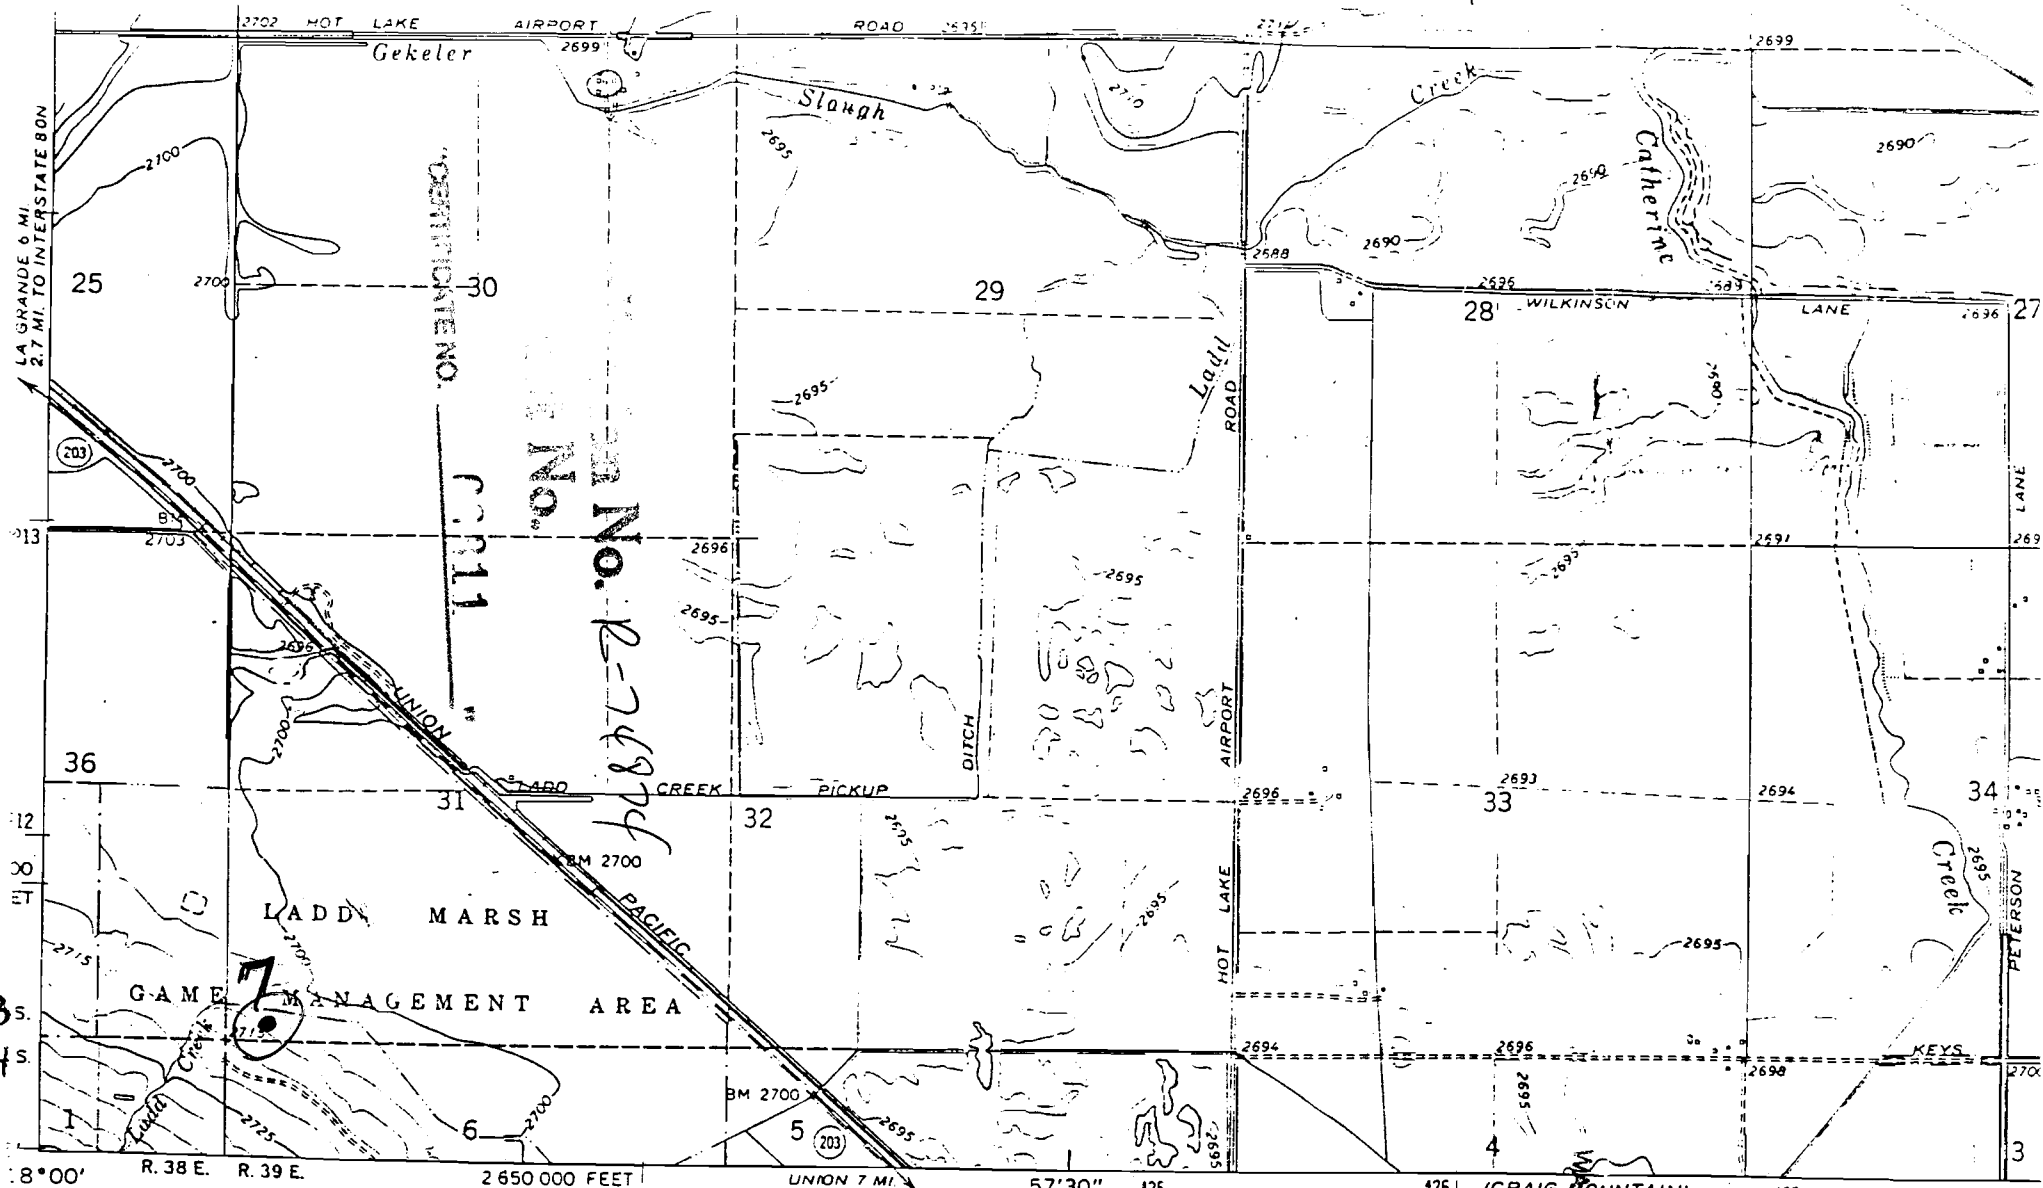


Mapped, edited, and published by the Geological Survey
 Control by USGS and USC&GS
 Topography by photogrammetric methods from aerial photographs taken 1963 and planetable surveys 1965
 Polyconic projection. 1927 North American datum
 10,000-foot grid based on Oregon coordinate system, north zone
 1000-meter Universal Transverse Mercator grid ticks, zone 11, shown in blue
 Fine red dashed lines indicate selected fence lines

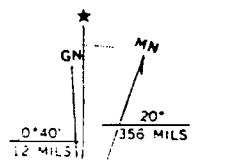

UTM GRID AND 1965 MAGNETIC NORTH DECLINATION AT CENTER OF SHEET


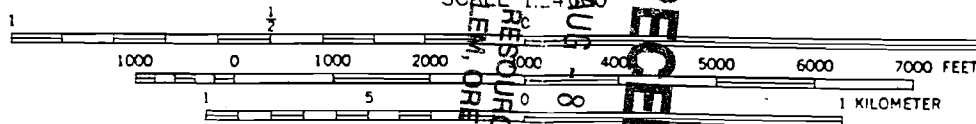


RECEIVED
 SALEM, OREGON
 AUG 11 1969
 CONTOUR INTERVAL 5 FEET
 DATUM OREGON MEAN SEA LEVEL

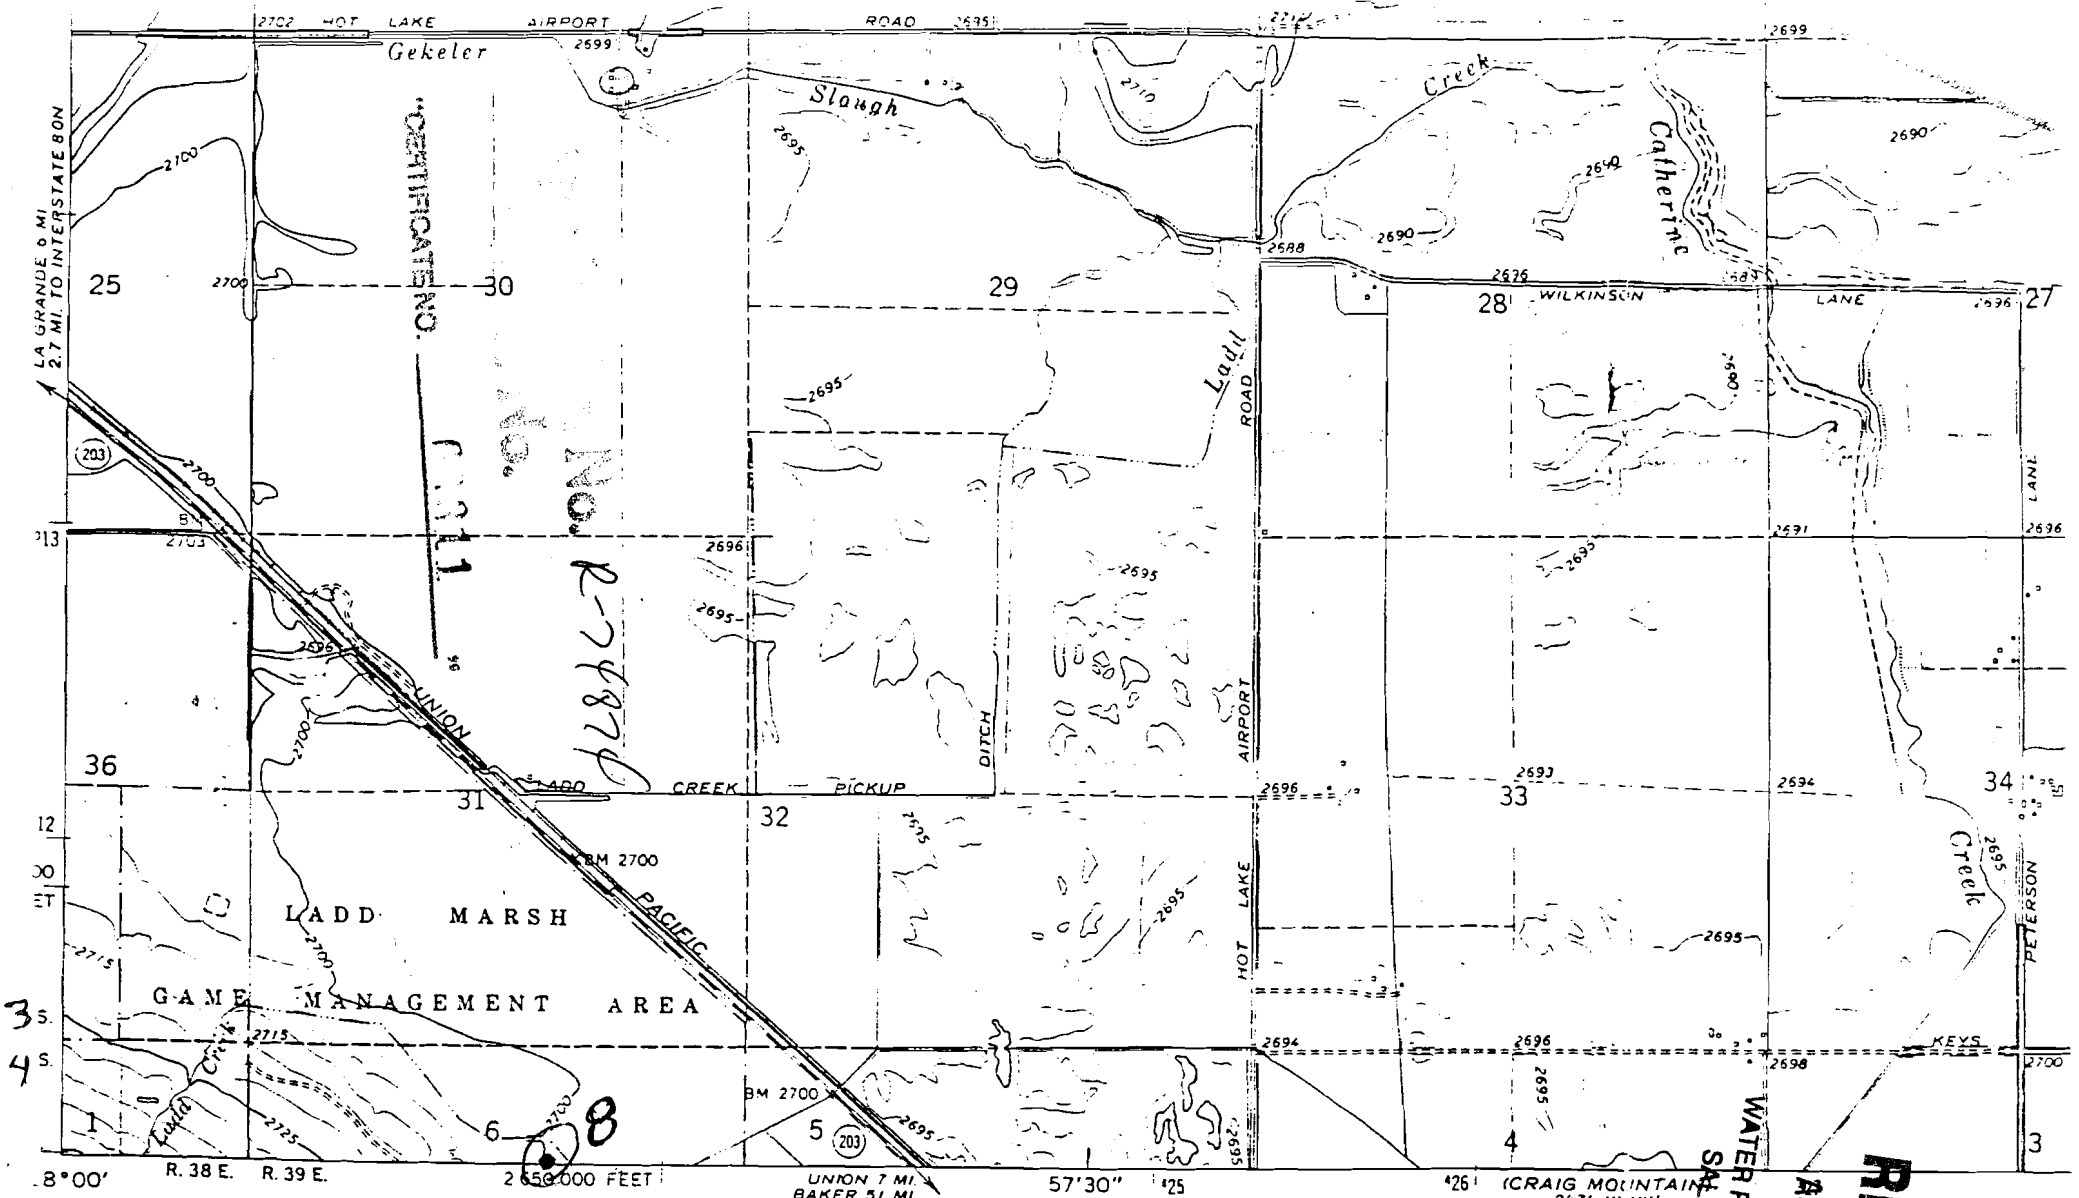

Mapped, edited, and published by the Geological Survey
 Control by USGS and USC&GS

Topography by photogrammetric methods from aerial photographs taken 1963 and planetable surveys 1965
 Polyconic projection. 1927 North American datum
 10,000-foot grid based on Oregon coordinate system, north zone
 1000-meter Universal Transverse Mercator grid ticks, zone 11, shown in blue
 Fine red dashed lines indicate selected fence lines

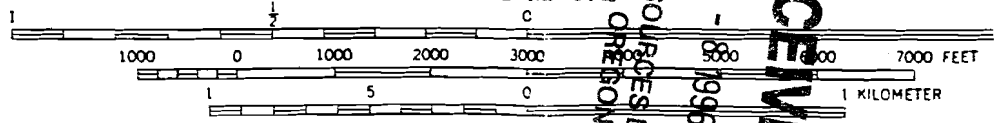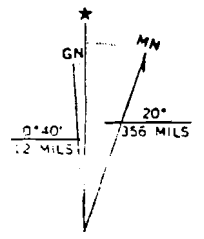


CONTOUR INTERVAL 5 FEET
 DATUM IS MEAN SEA LEVEL

RECEIVED
 AUG - 1995
 WATER RESOURCES DEPT.
 SALEM, OREGON

RECEIVED

AUG - 8 1996

WATER RESOURCES DEPT
SALEM, OREGON

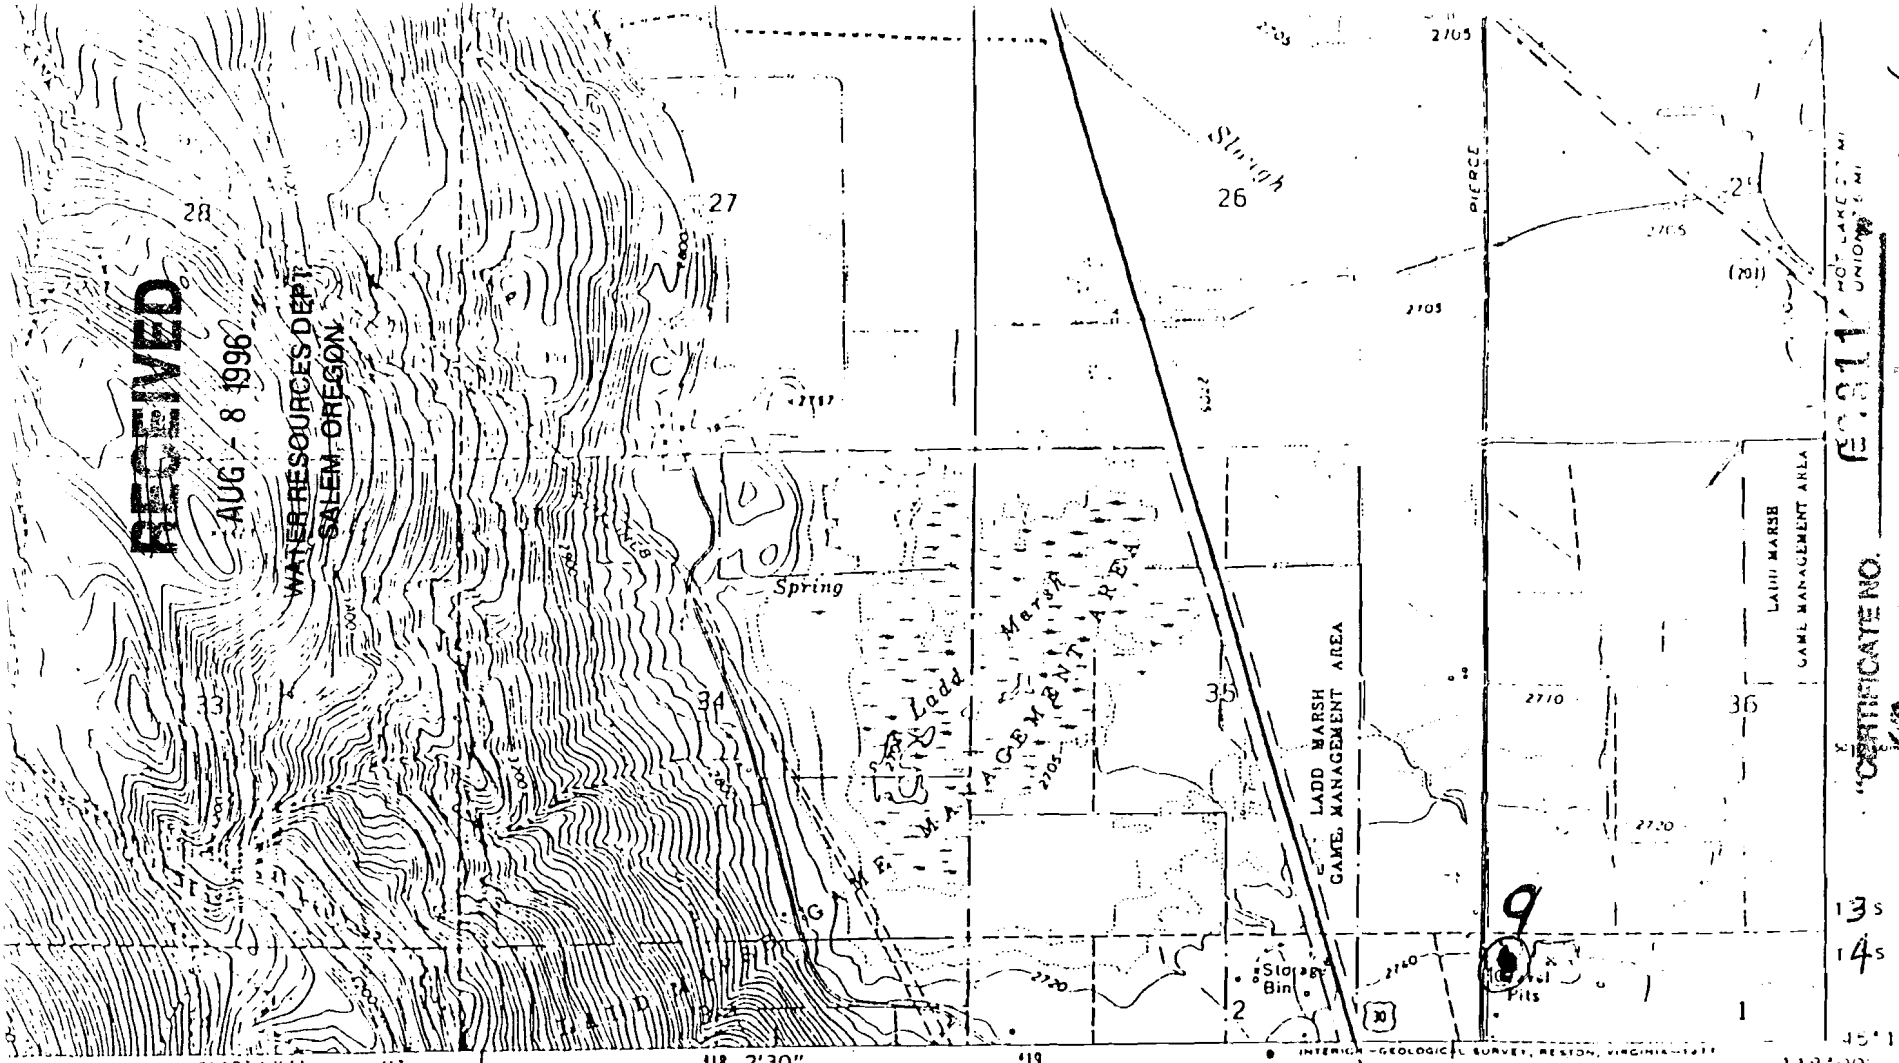

CERTIFICATE NO. 17

NO. 2-74874

No.

16 17 18 2'30" 19 20 21 22 118'00"


SCALE 1:24 000

1 MILE

1000 2000 3000 4000 5000 6000 7000 FEET

1 KILOMETER

CONTOUR INTERVAL 20 FEET
DOTTED LINES REPRESENT 5 FOOT CONTOURS
NATIONAL GEODETIC VERTICAL DATUM OF 1929

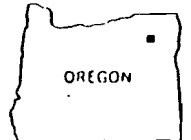

QUADRANGLE LOCATION

ROAD CLASSIFICATION

- Heavy duty
- Medium-duty
- Light duty
- Unimproved dirt
- Interstate Route
- U S Route
- State Route


LA GRANDE SE, OREG.

N4515 - W11800/7 5

1903

AMS 2374 1:24,000 SERIES V002

COMPLIES WITH NATIONAL MAP ACCURACY STANDARDS
NATIONAL SURVEY, DENVER COLORADO 80225, OR RESTON, VIRGINIA 22092
TOPOGRAPHIC MAPS AND SYMBOLS IS AVAILABLE ON REQUEST

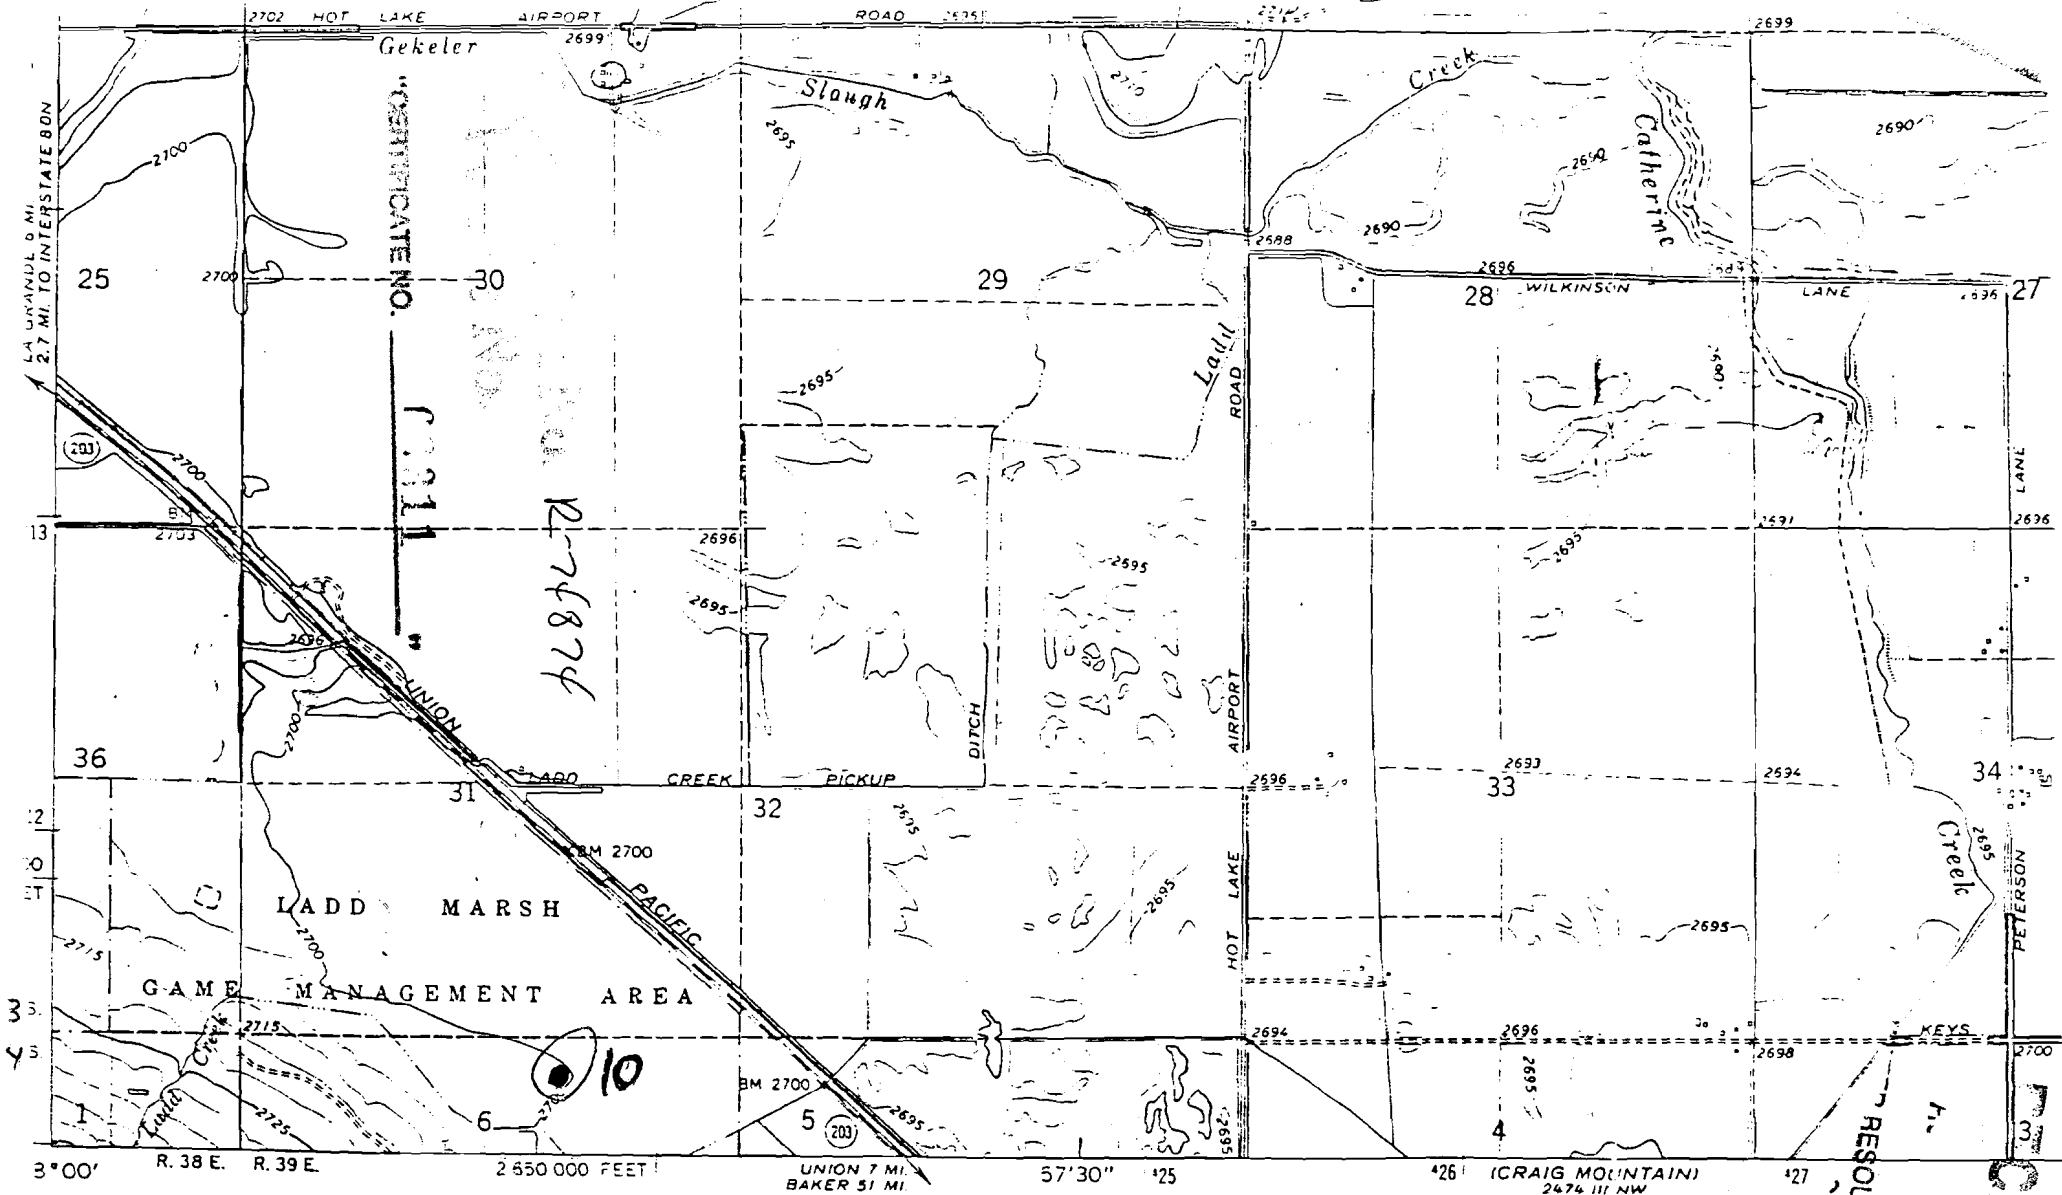

Mapped, edited, and published by the Geological Survey


Control by USGS and USC&GS

Topography by photogrammetric methods from aerial photographs taken 1963 and planetable surveys 1965


Polyconic projection. 1927 North American datum
10,000-foot grid based on Oregon coordinate system, north zone

1000-meter Universal Transverse Mercator grid ticks, zone 11, shown in blue

Fine red dashed lines indicate selected fence lines

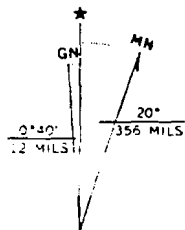


UTM GRID AND 1965 MAGNETIC NORTH DECLINATION AT CENTER OF SHEET

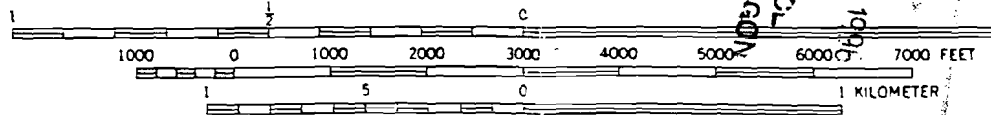

SCALE 1:24 000
CONTOUR INTERVAL 5 FEET
DATUM IS MEAN SEA LEVEL

THIS MAP COMPLIES WITH NATIONAL MAP ACCURACY STANDARDS
FOR SALE BY U. S. GEOLOGICAL SURVEY, DENVER, COLORADO 80225

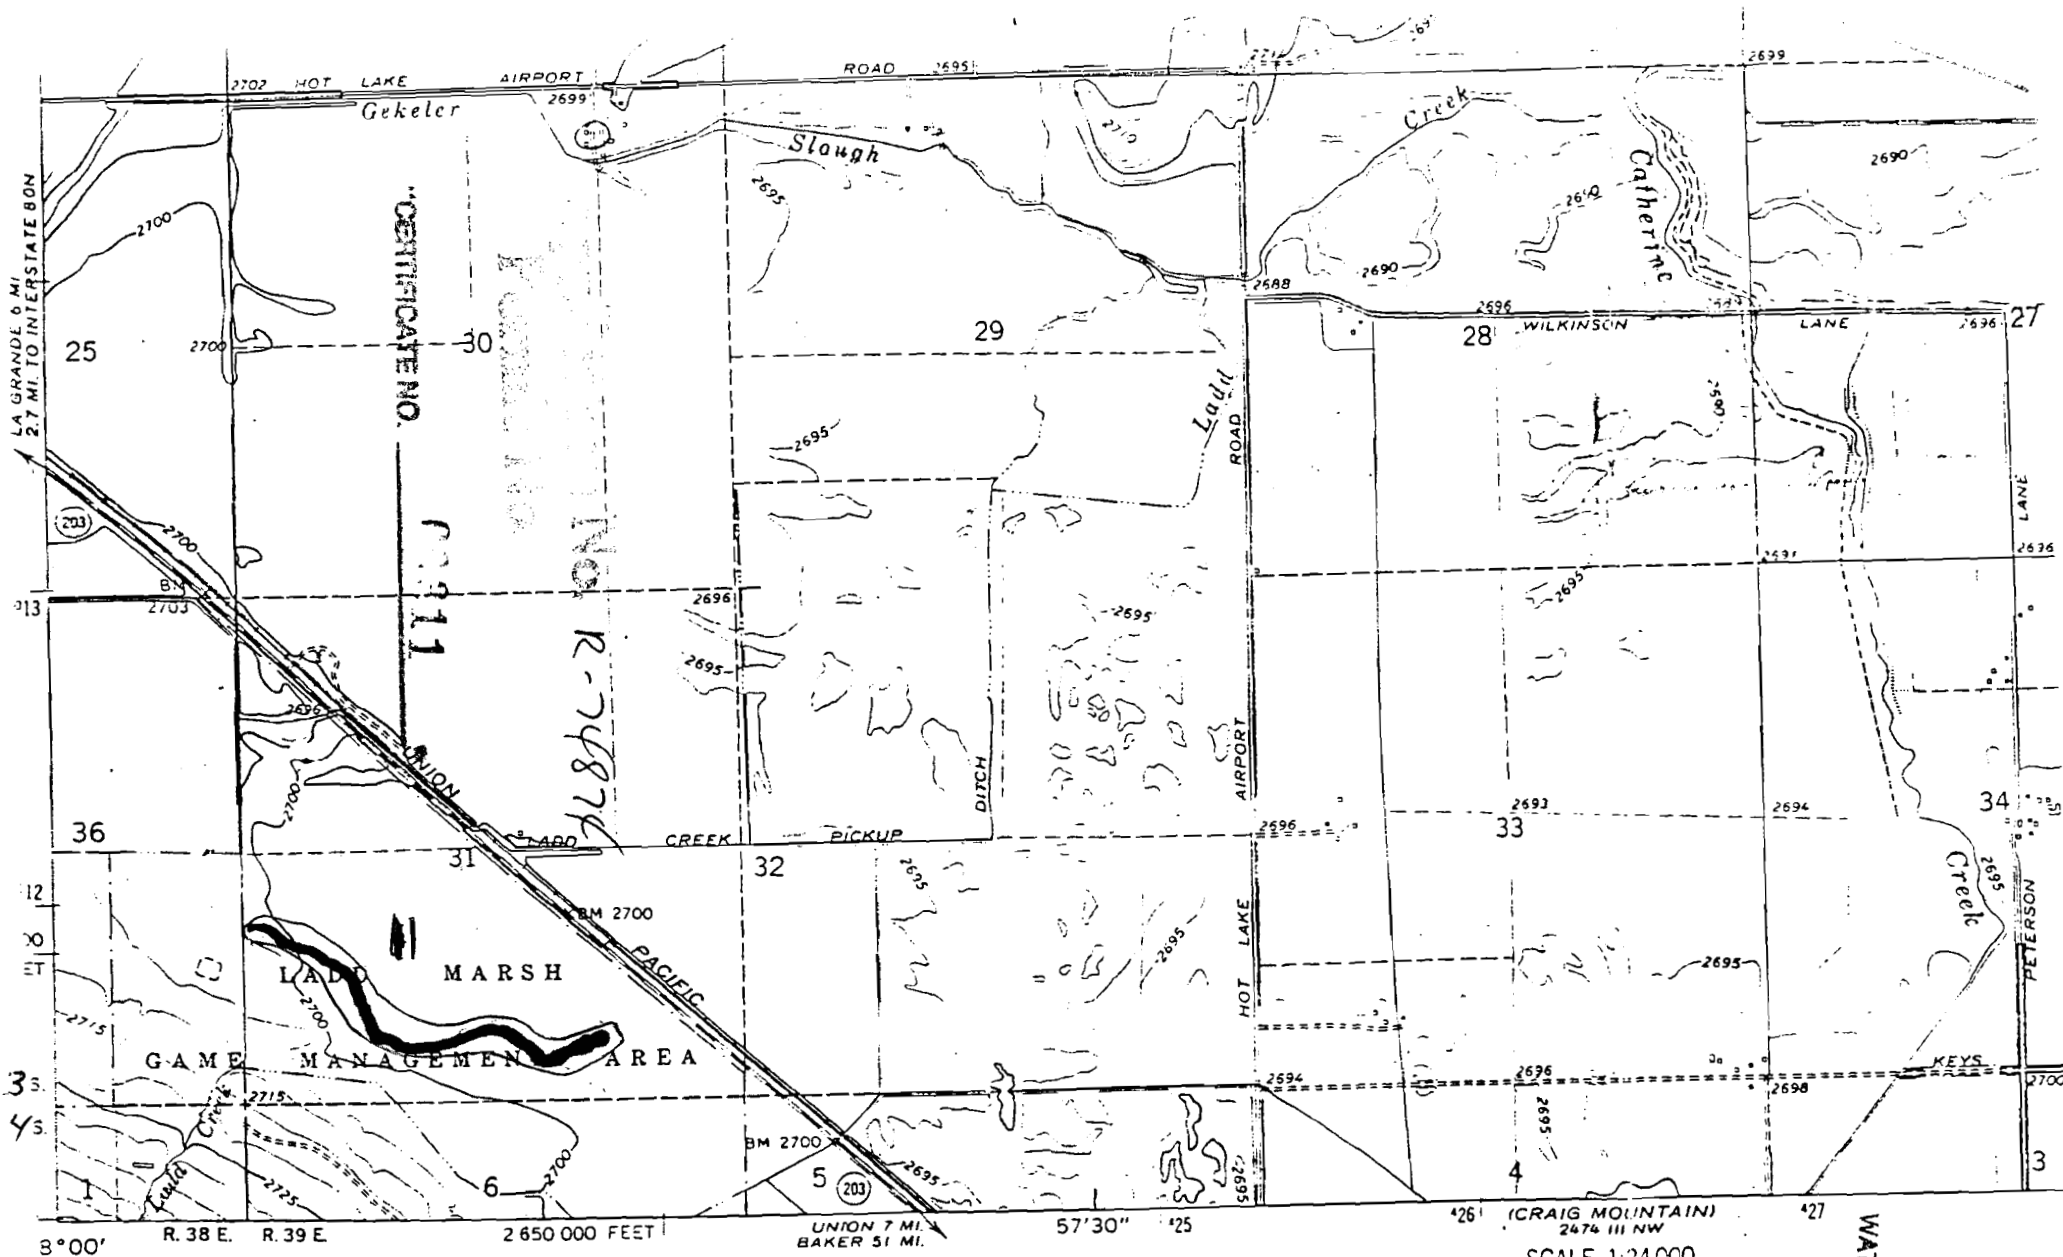

Mapped, edited, and published by the Geological Survey

Control by USGS and USC&GS



Topography by photogrammetric methods from aerial photographs taken 1963 and planetable surveys 1965

Polyconic projection. 1927 North American datum
10,000-foot grid based on Oregon coordinate system,
north zone

1000-meter Universal Transverse Mercator grid ticks,
zone 11, shown in blue

Fine red dashed lines indicate selected fence lines

UTM GRID AND 1965 MAGNETIC NORTH
DECLINATION AT CENTER OF SHEET

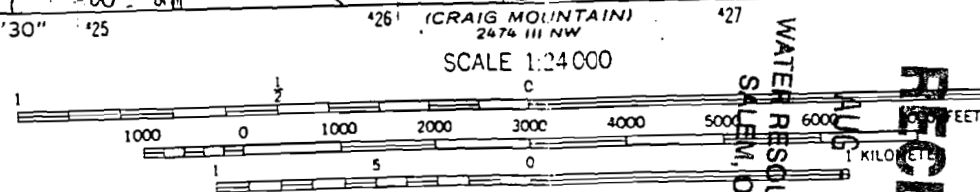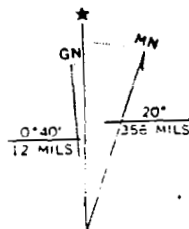


THIS MAP COMPLIES WITH NATIONAL MAP ACCURACY STANDARDS

WATER RESOURCES DEPT.
SALEM, OREGON

AUG 8 1996

RECEIVED

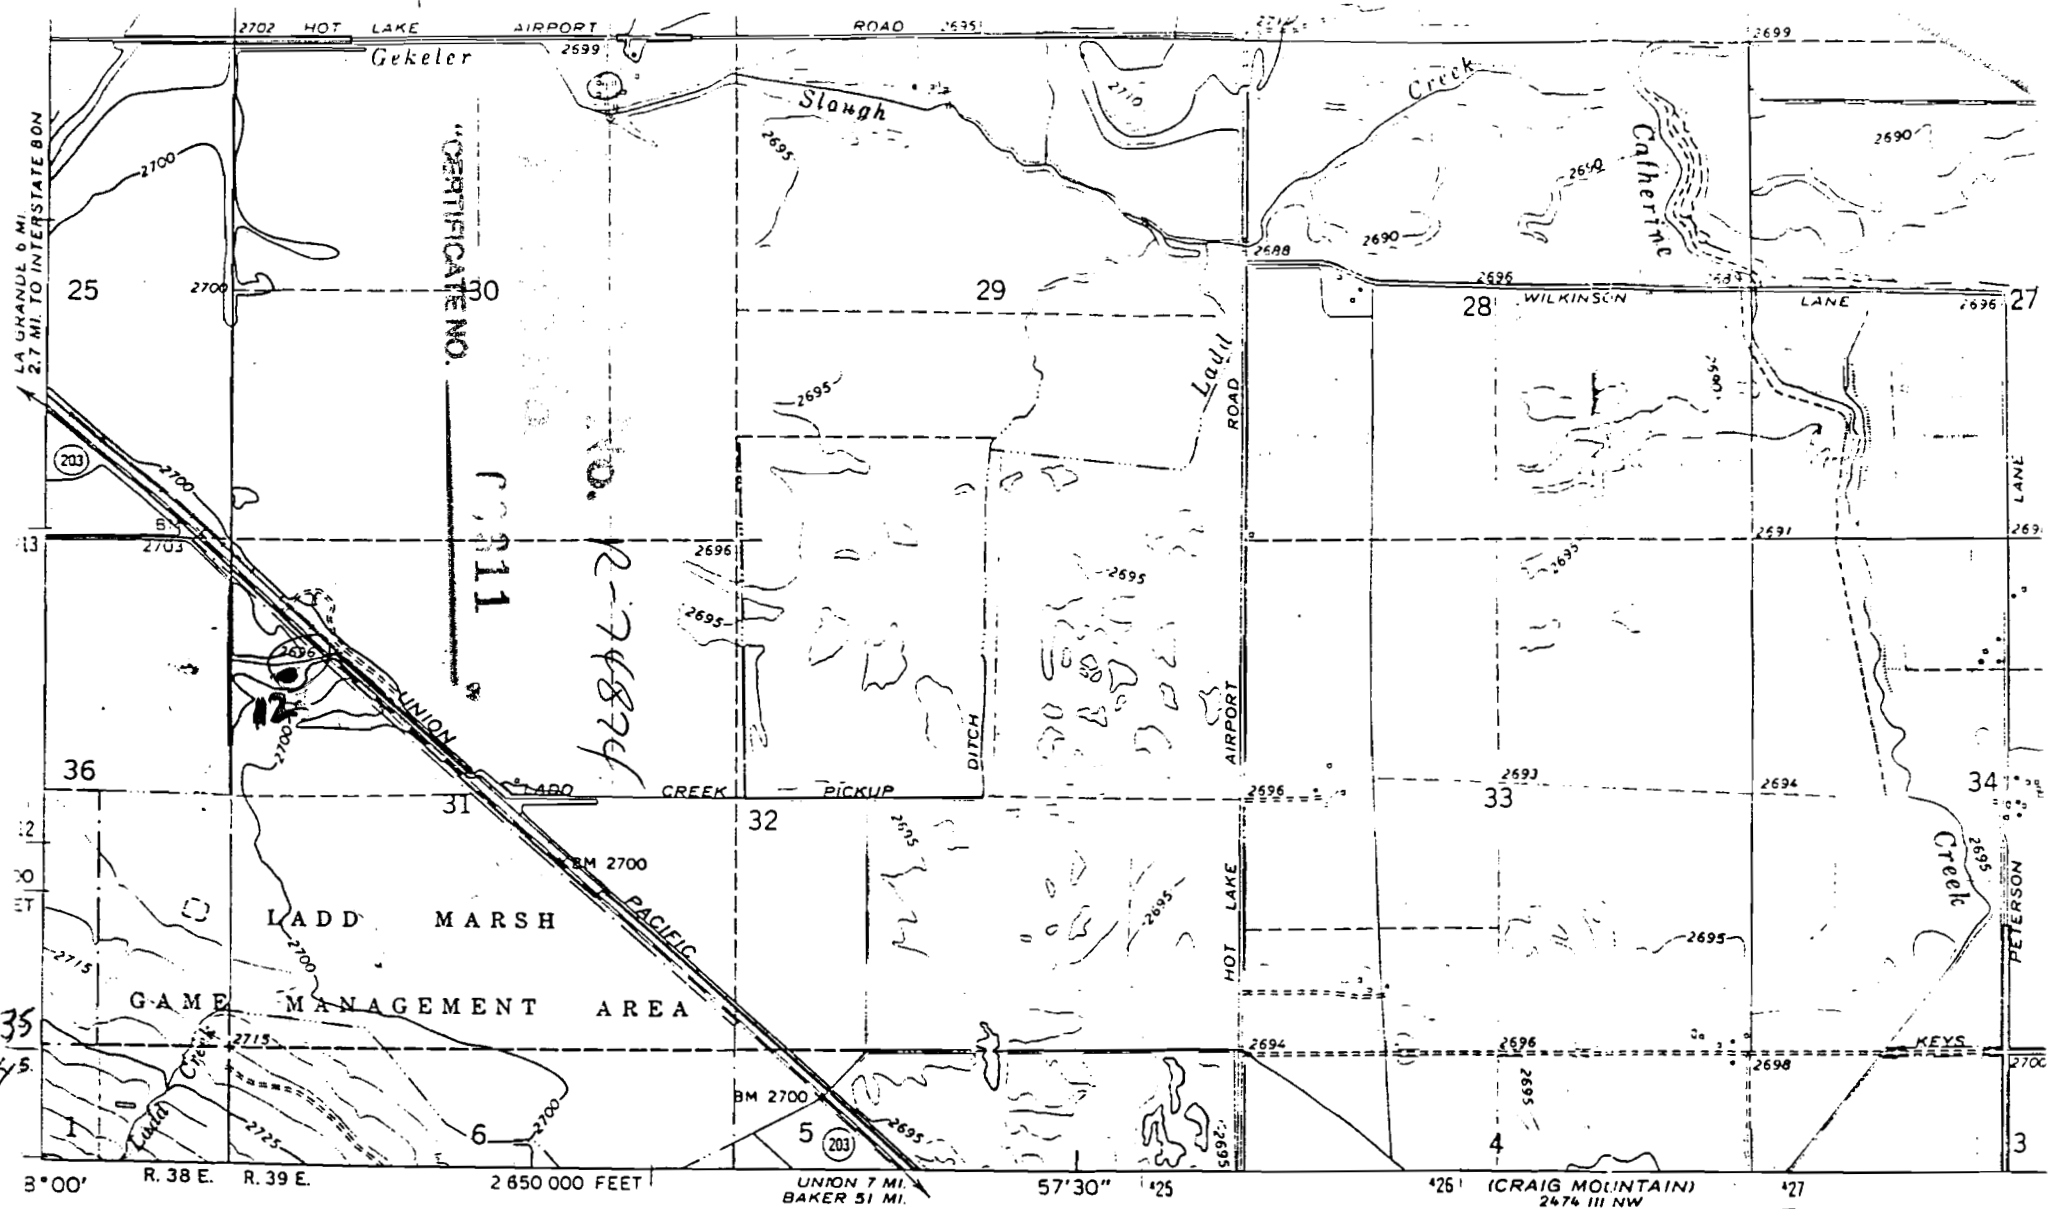

Mapped, edited, and published by the Geological Survey


Control by USGS and USC&GS

Topography by photogrammetric methods from aerial photographs taken 1963 and planetable surveys 1965

Polyconic projection. 1927 North American datum
10,000-foot grid based on Oregon coordinate system,
north zone


1000-meter Universal Transverse Mercator grid ticks,
zone 11, shown in blue

Finer red dashed lines indicate selected fence lines.

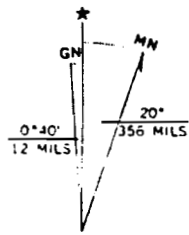

UTM GRID AND 1965 MAGNETIC NORTH DECLINATION AT CENTER OF SHEET

SCALE 1:24 000

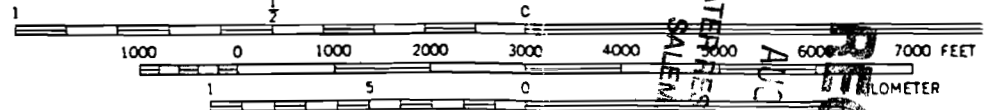

CONTOUR INTERVAL 5 FEET
DATUM IS MEAN SEA LEVEL

THIS MAP COMPLIES WITH NATIONAL MAP ACCURACY STANDARDS

REC'D
WATER RESOURCES DIVISION
SALEM DISTRICT