



Application No. R-74875
Permit No.

"CERTIFICATE NO. ~~10112~~

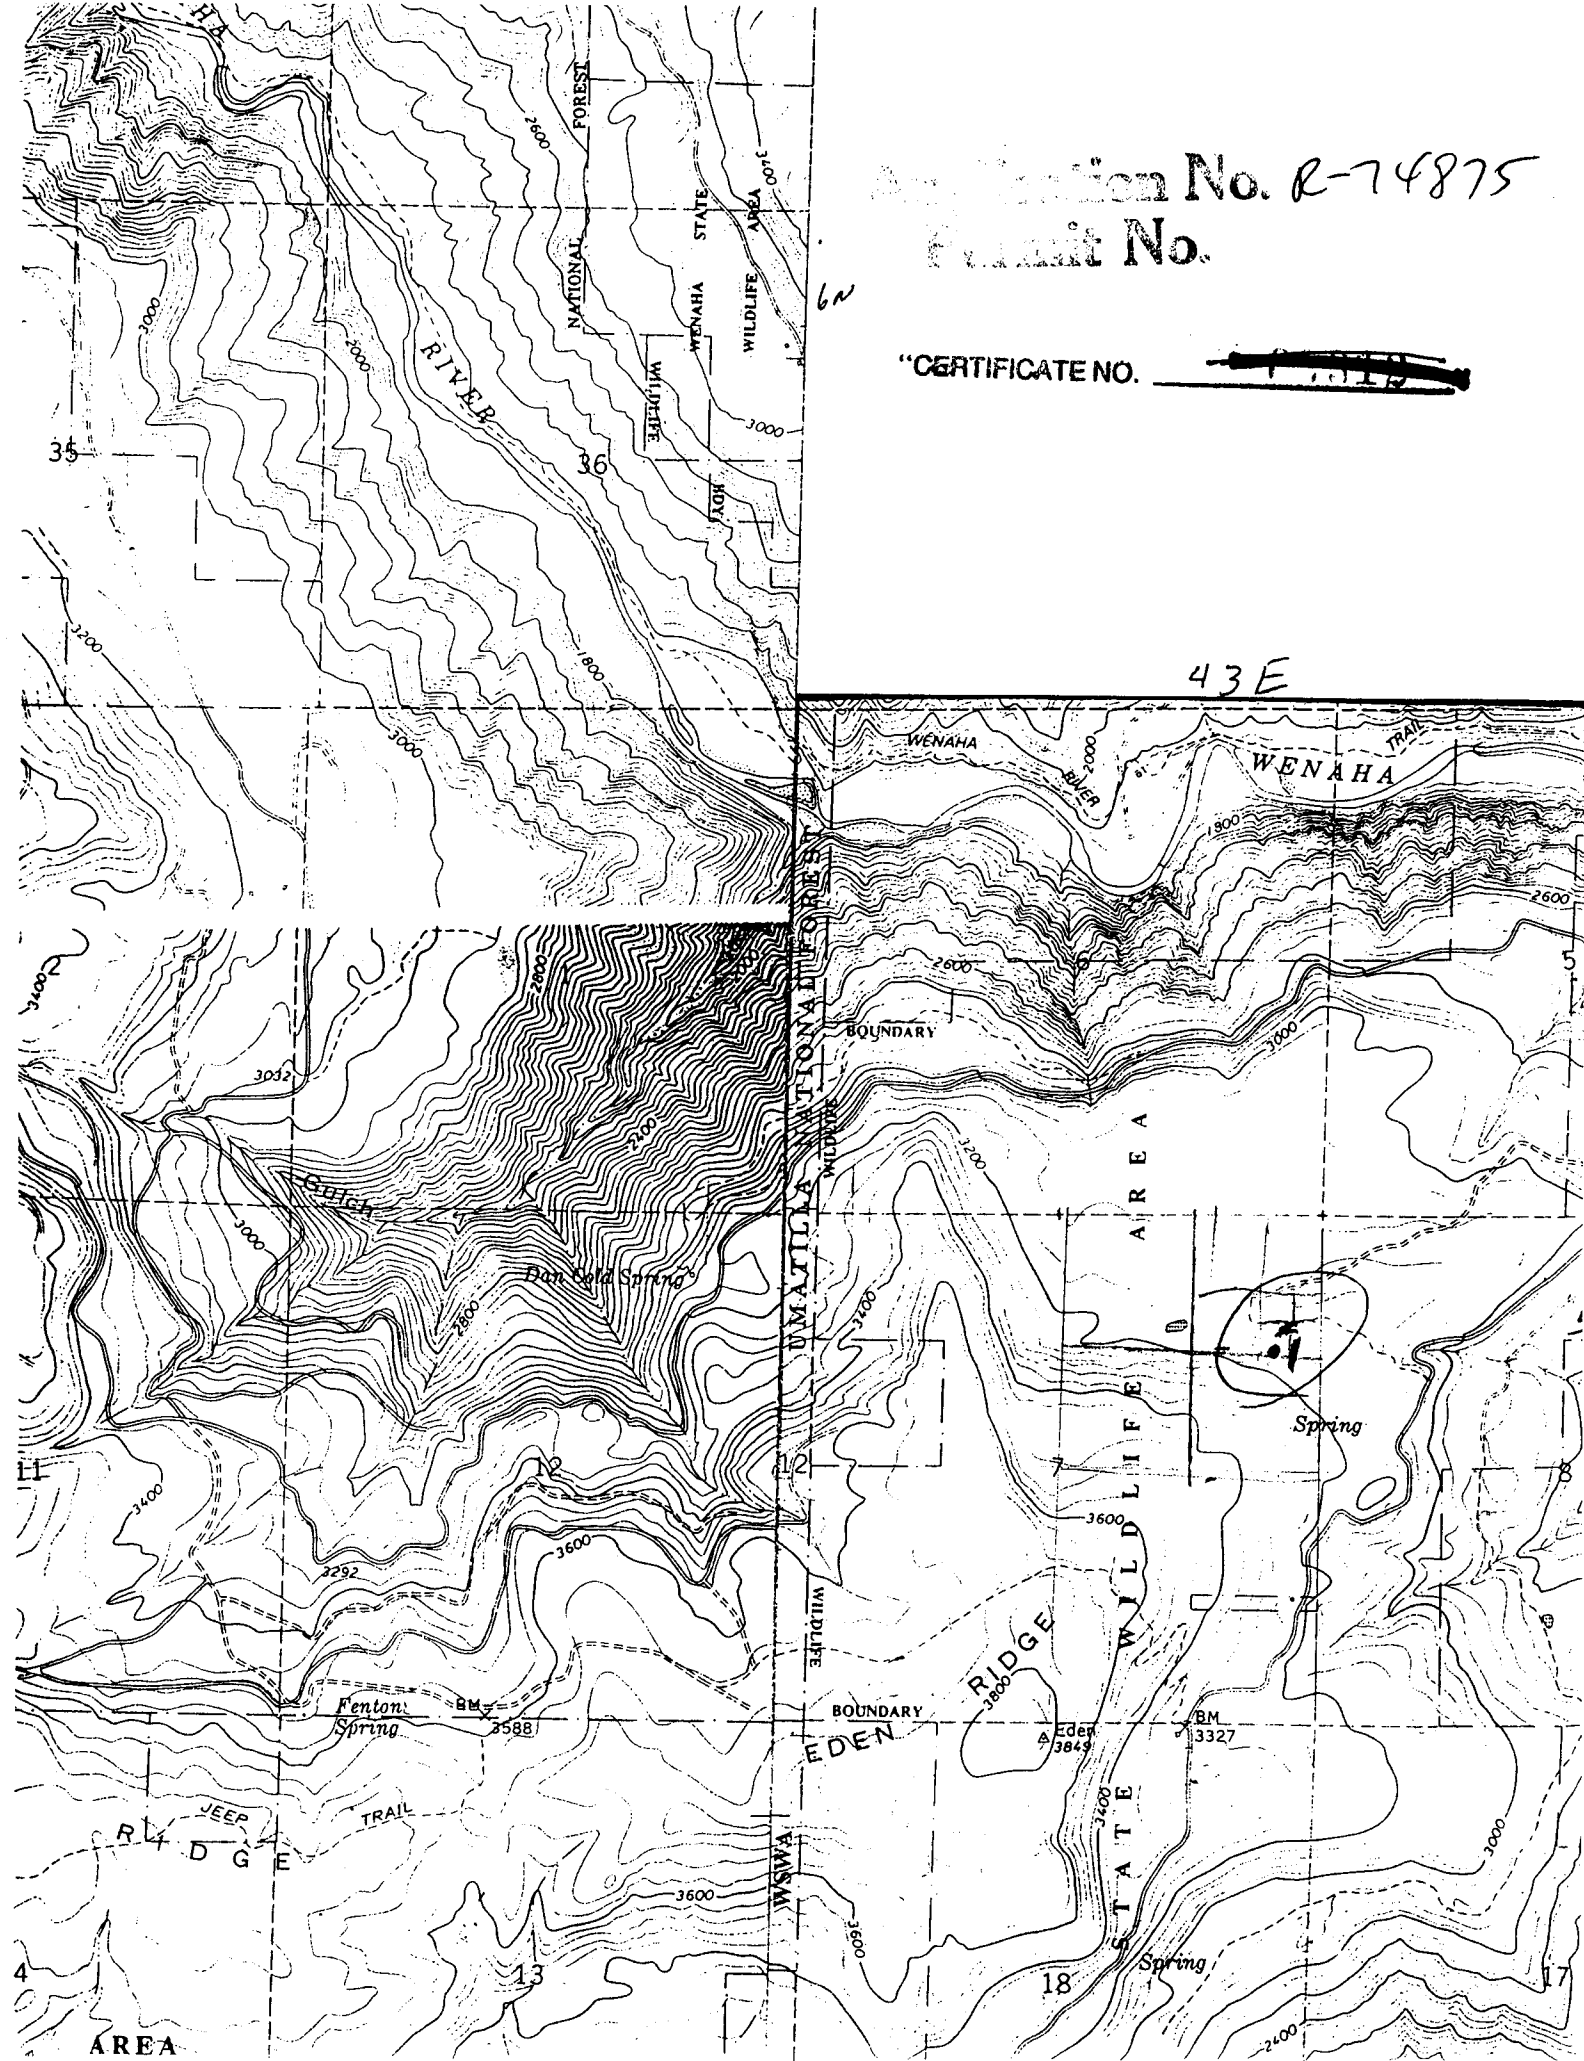

425

6 AL WRD

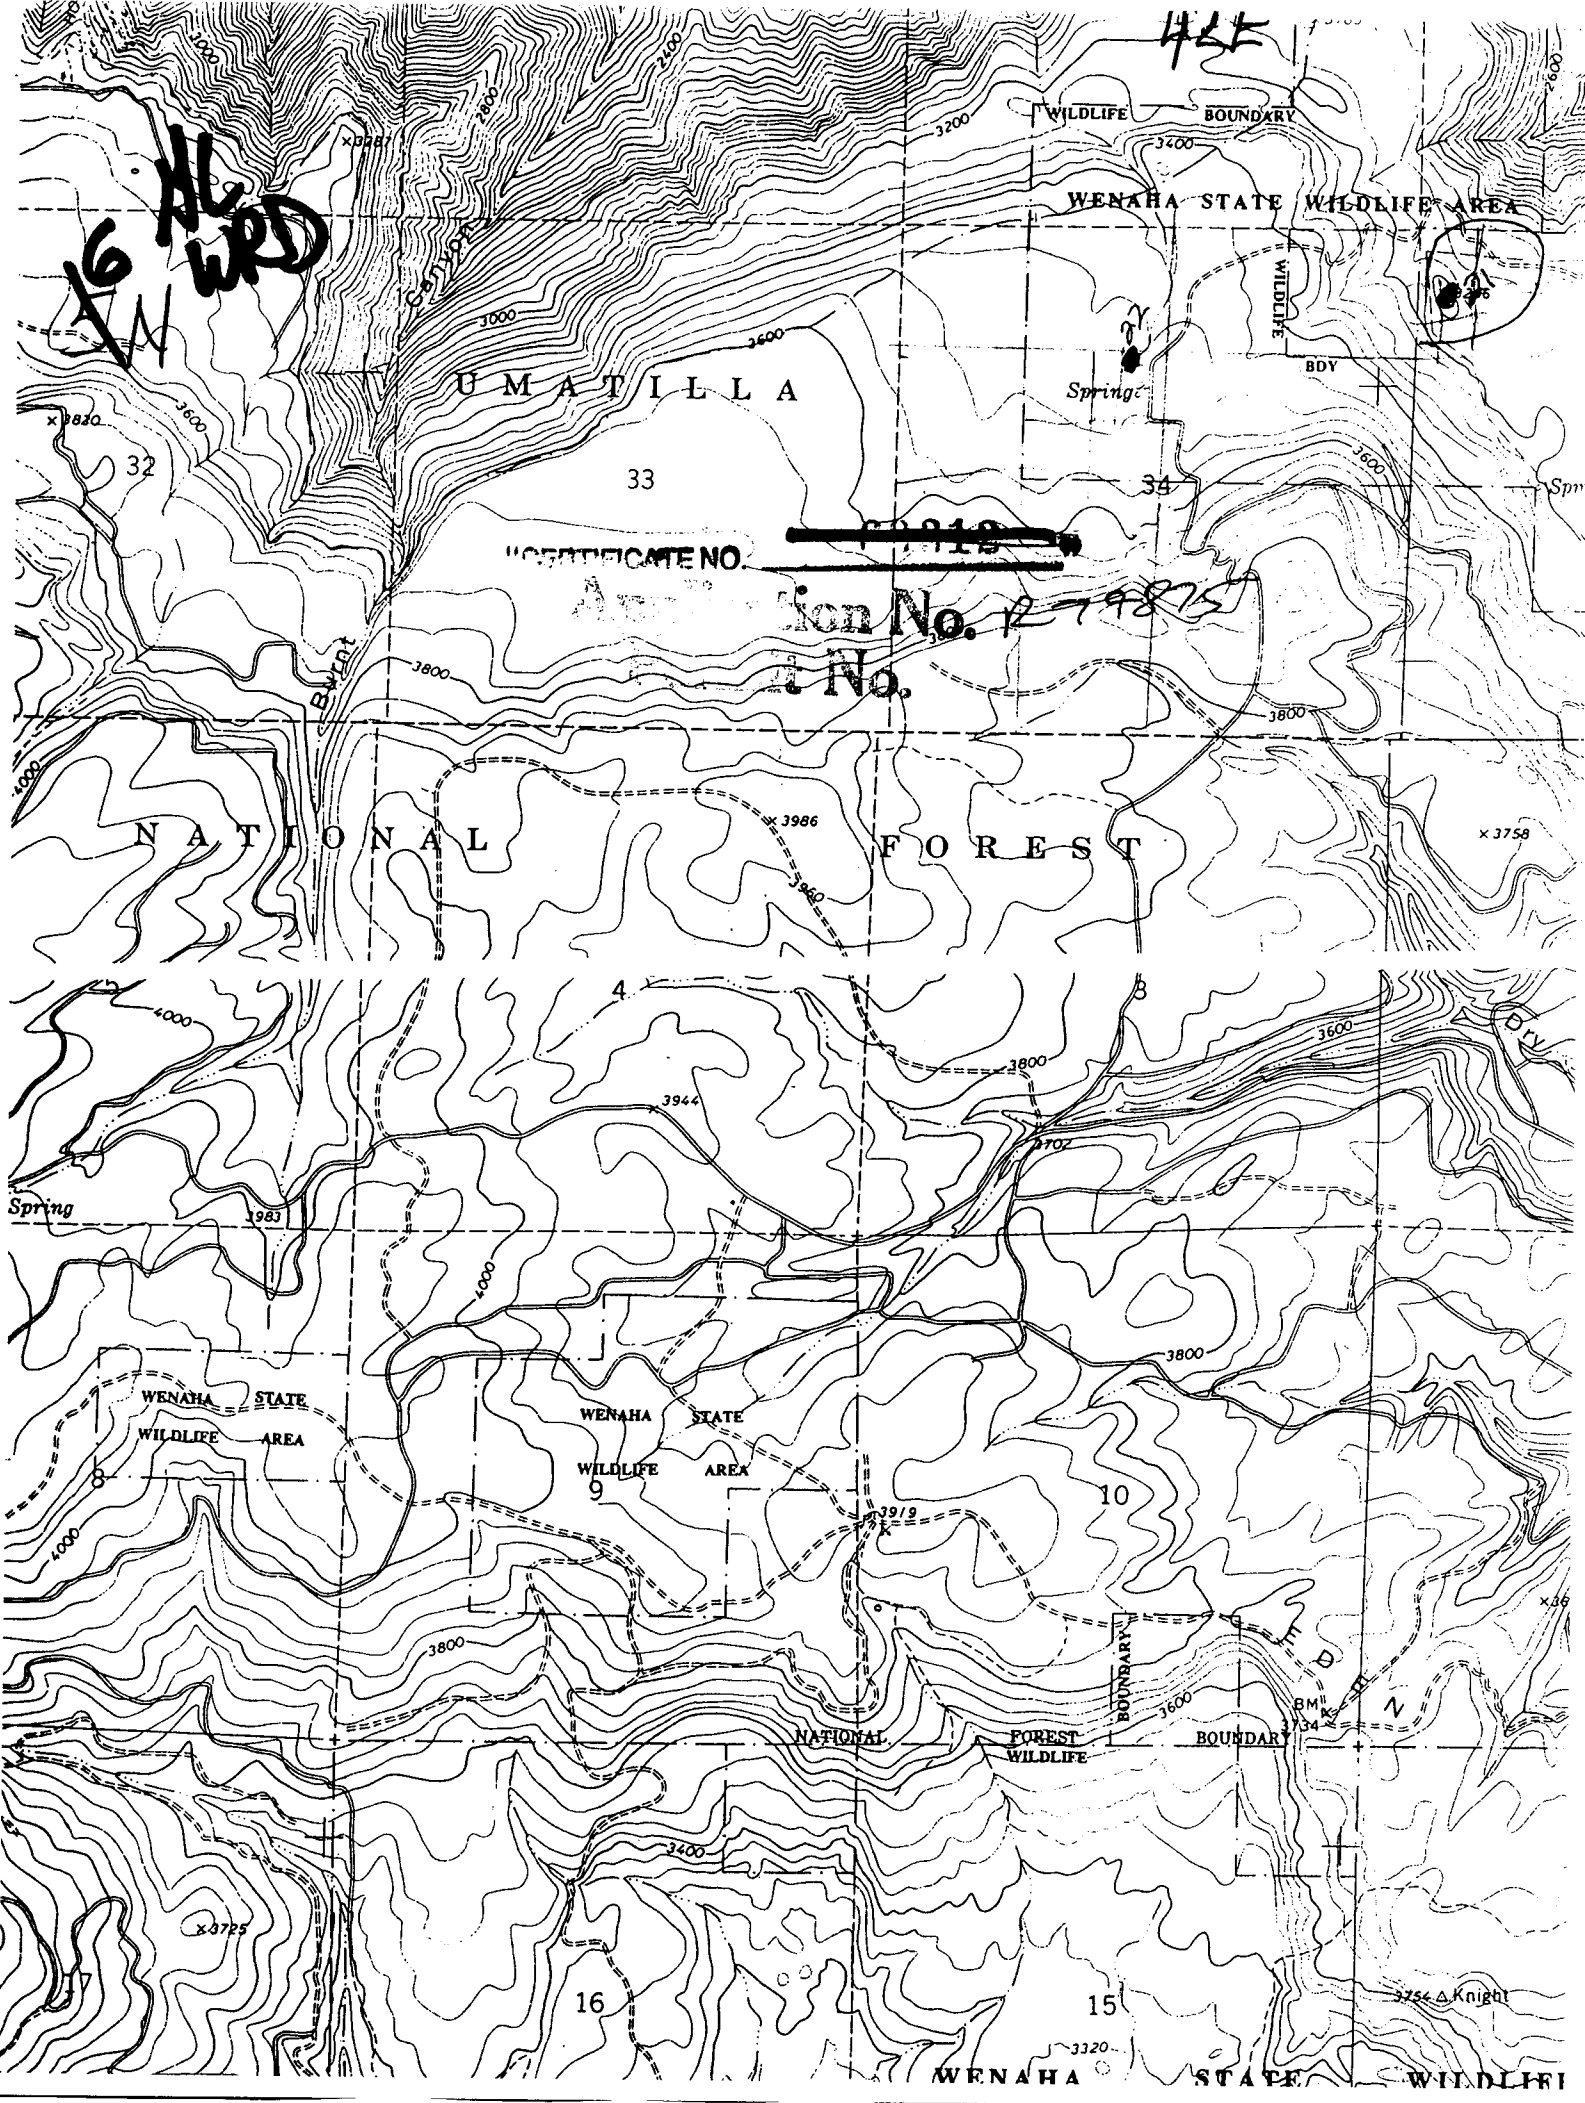

CERTIFICATE NO.

~~27918~~



NATIONAL

FOREST

WENAH STATE
WILDLIFE AREA

WENAH STATE
WILDLIFE AREA

NATIONAL

FOREST

WILDLIFE


WENAH

STATE

WILDLIFE

6 AC
N WRD

42E

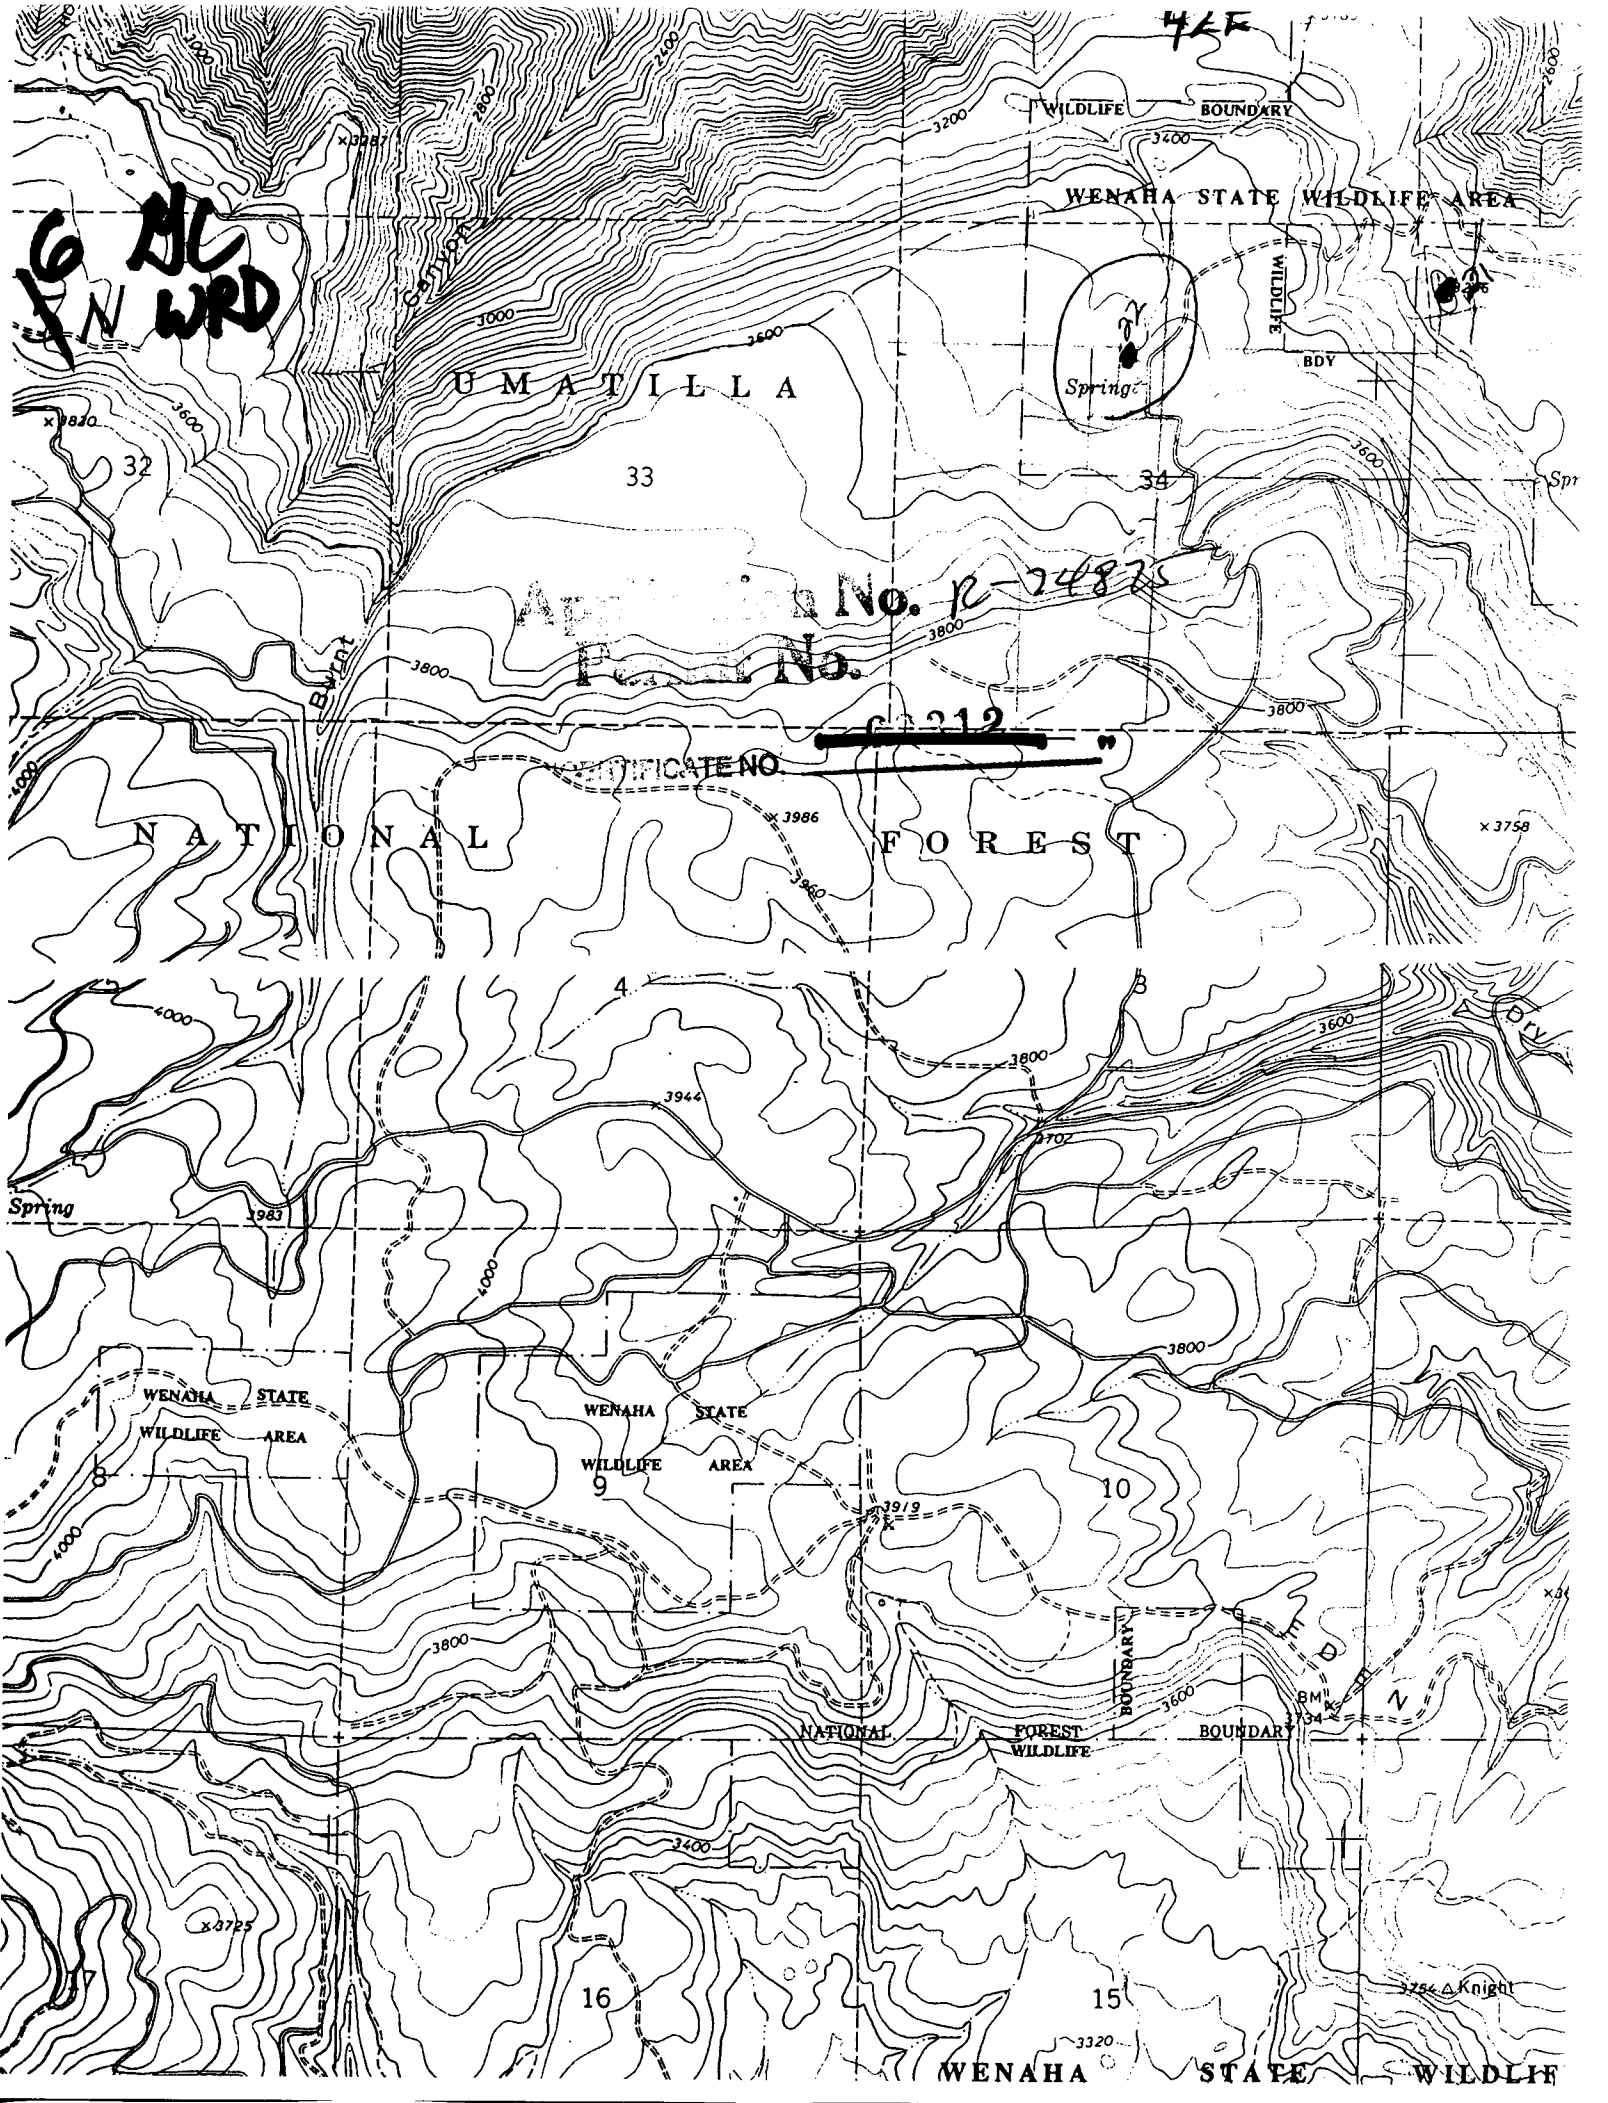

UMATILLA

WILDLIFE

BOUNDARY

WENAH STATE WILDLIFE AREA

Spring

BDV

33

34

Spr

No. R-24875

No.

212


NATIONAL

FOREST

x 3758

4

8

Spring

3983

3944

3702

3600

WENAH STATE WILDLIFE AREA

WENAH STATE WILDLIFE AREA

9

10

3919

NATIONAL

FOREST

BOUNDARY

x 3725

16

15

3754 Knight

WENAH

STATE

WILDLIFE