



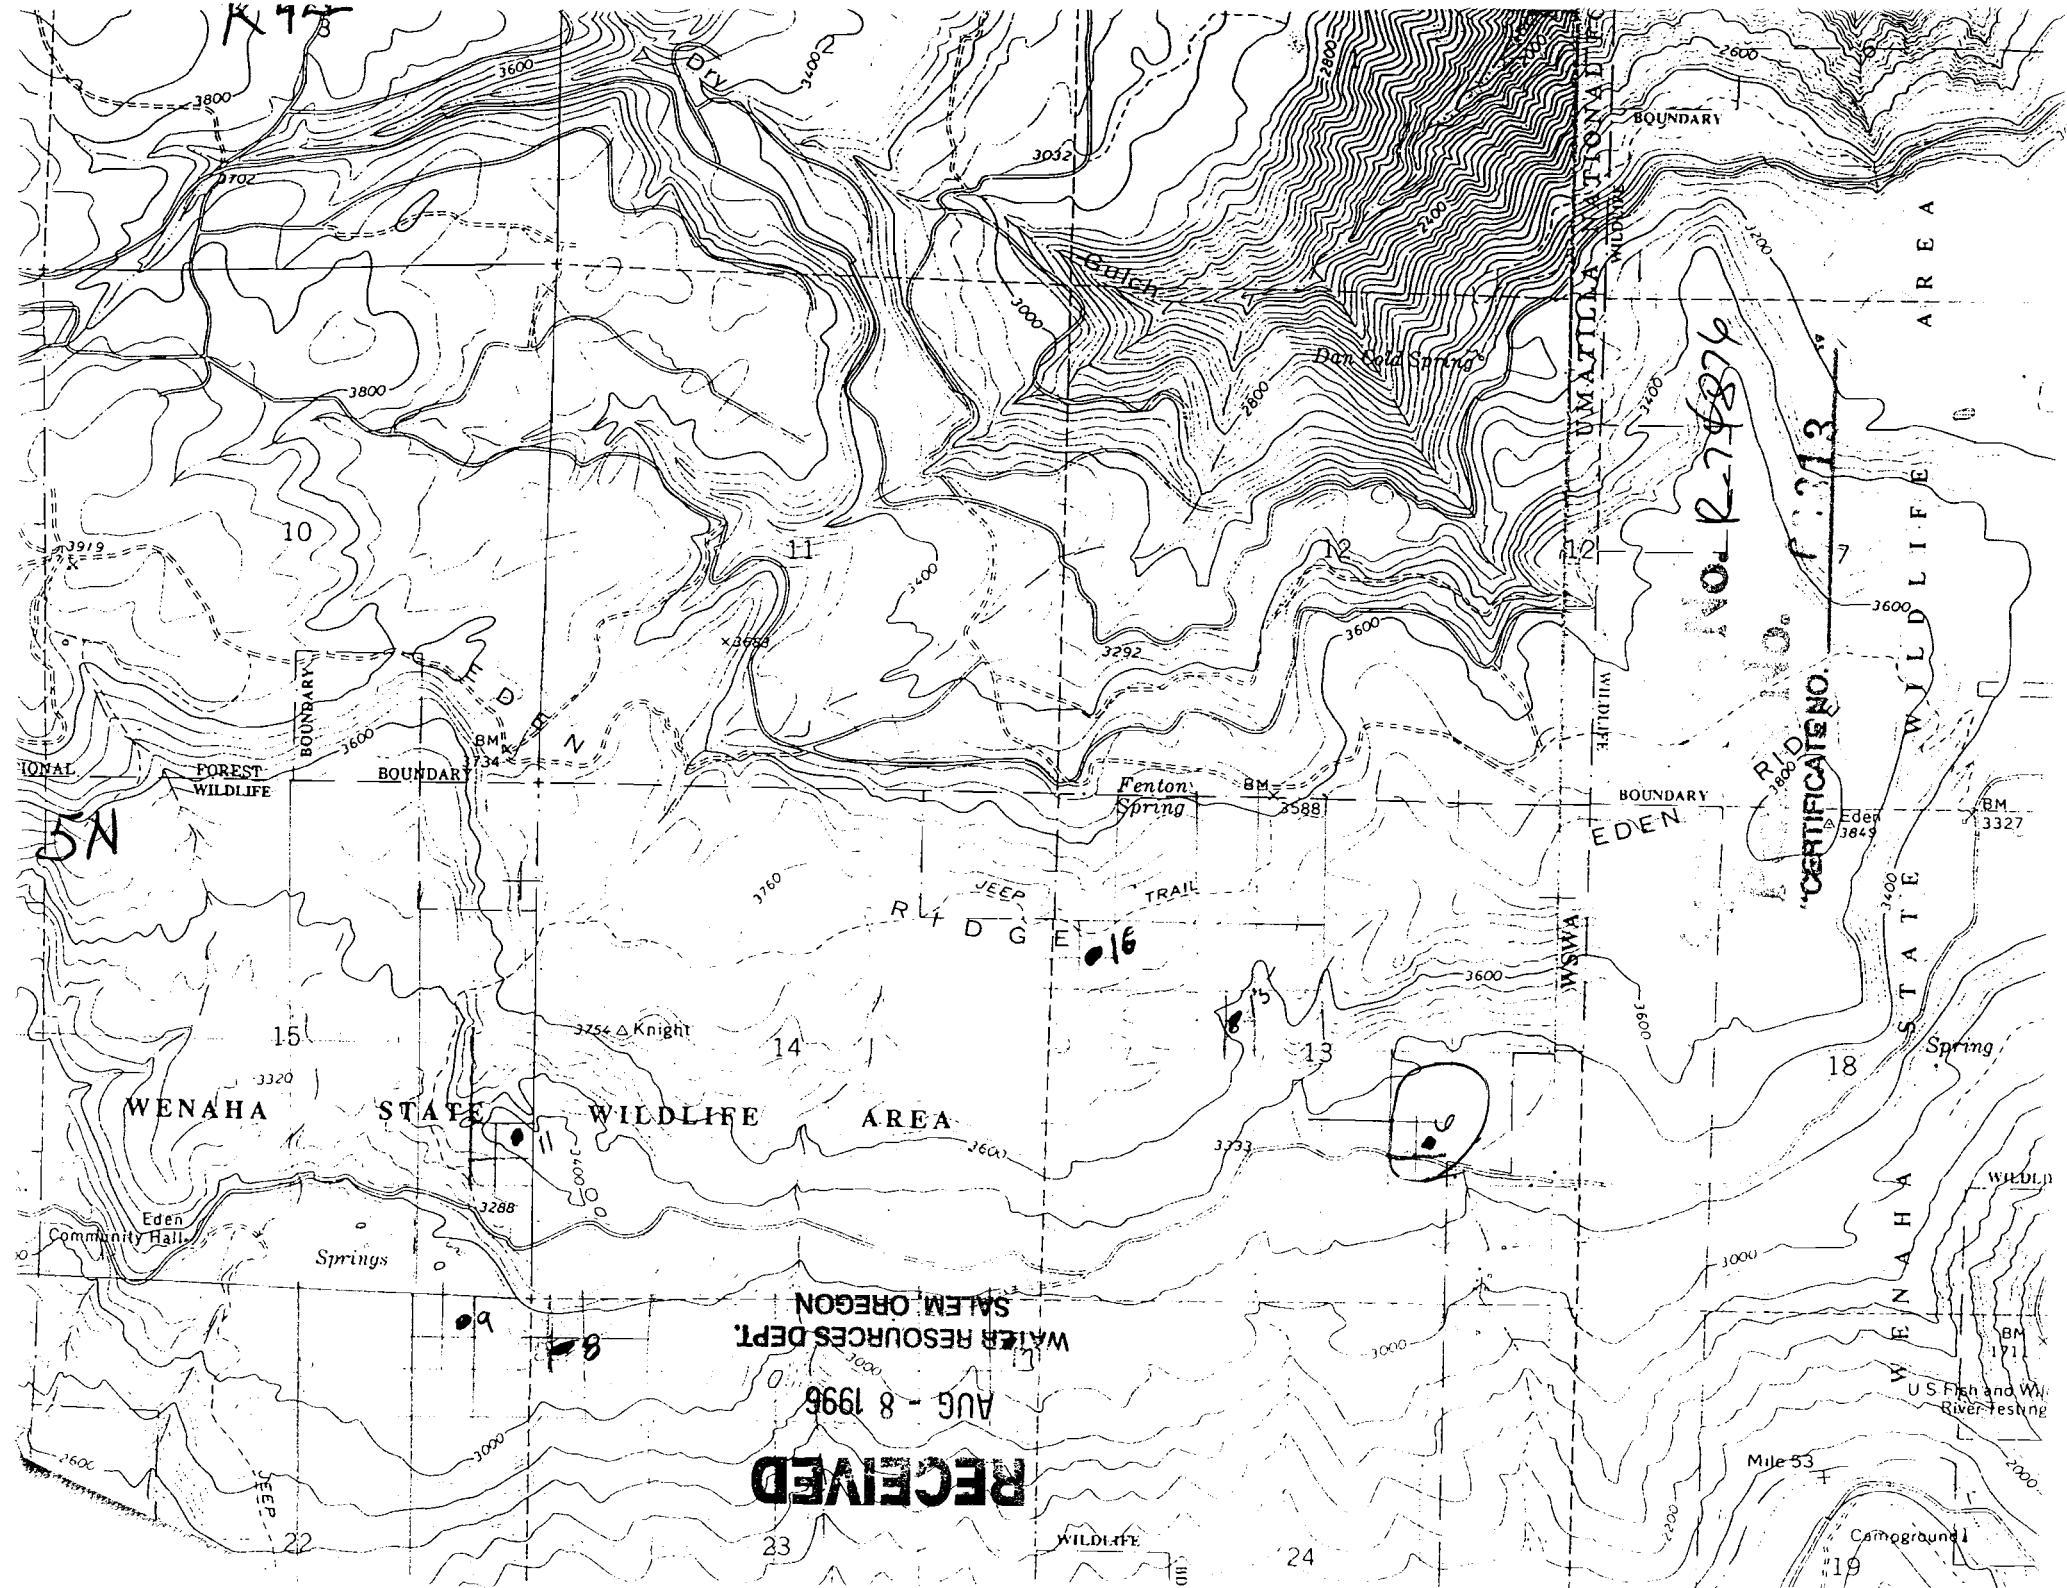

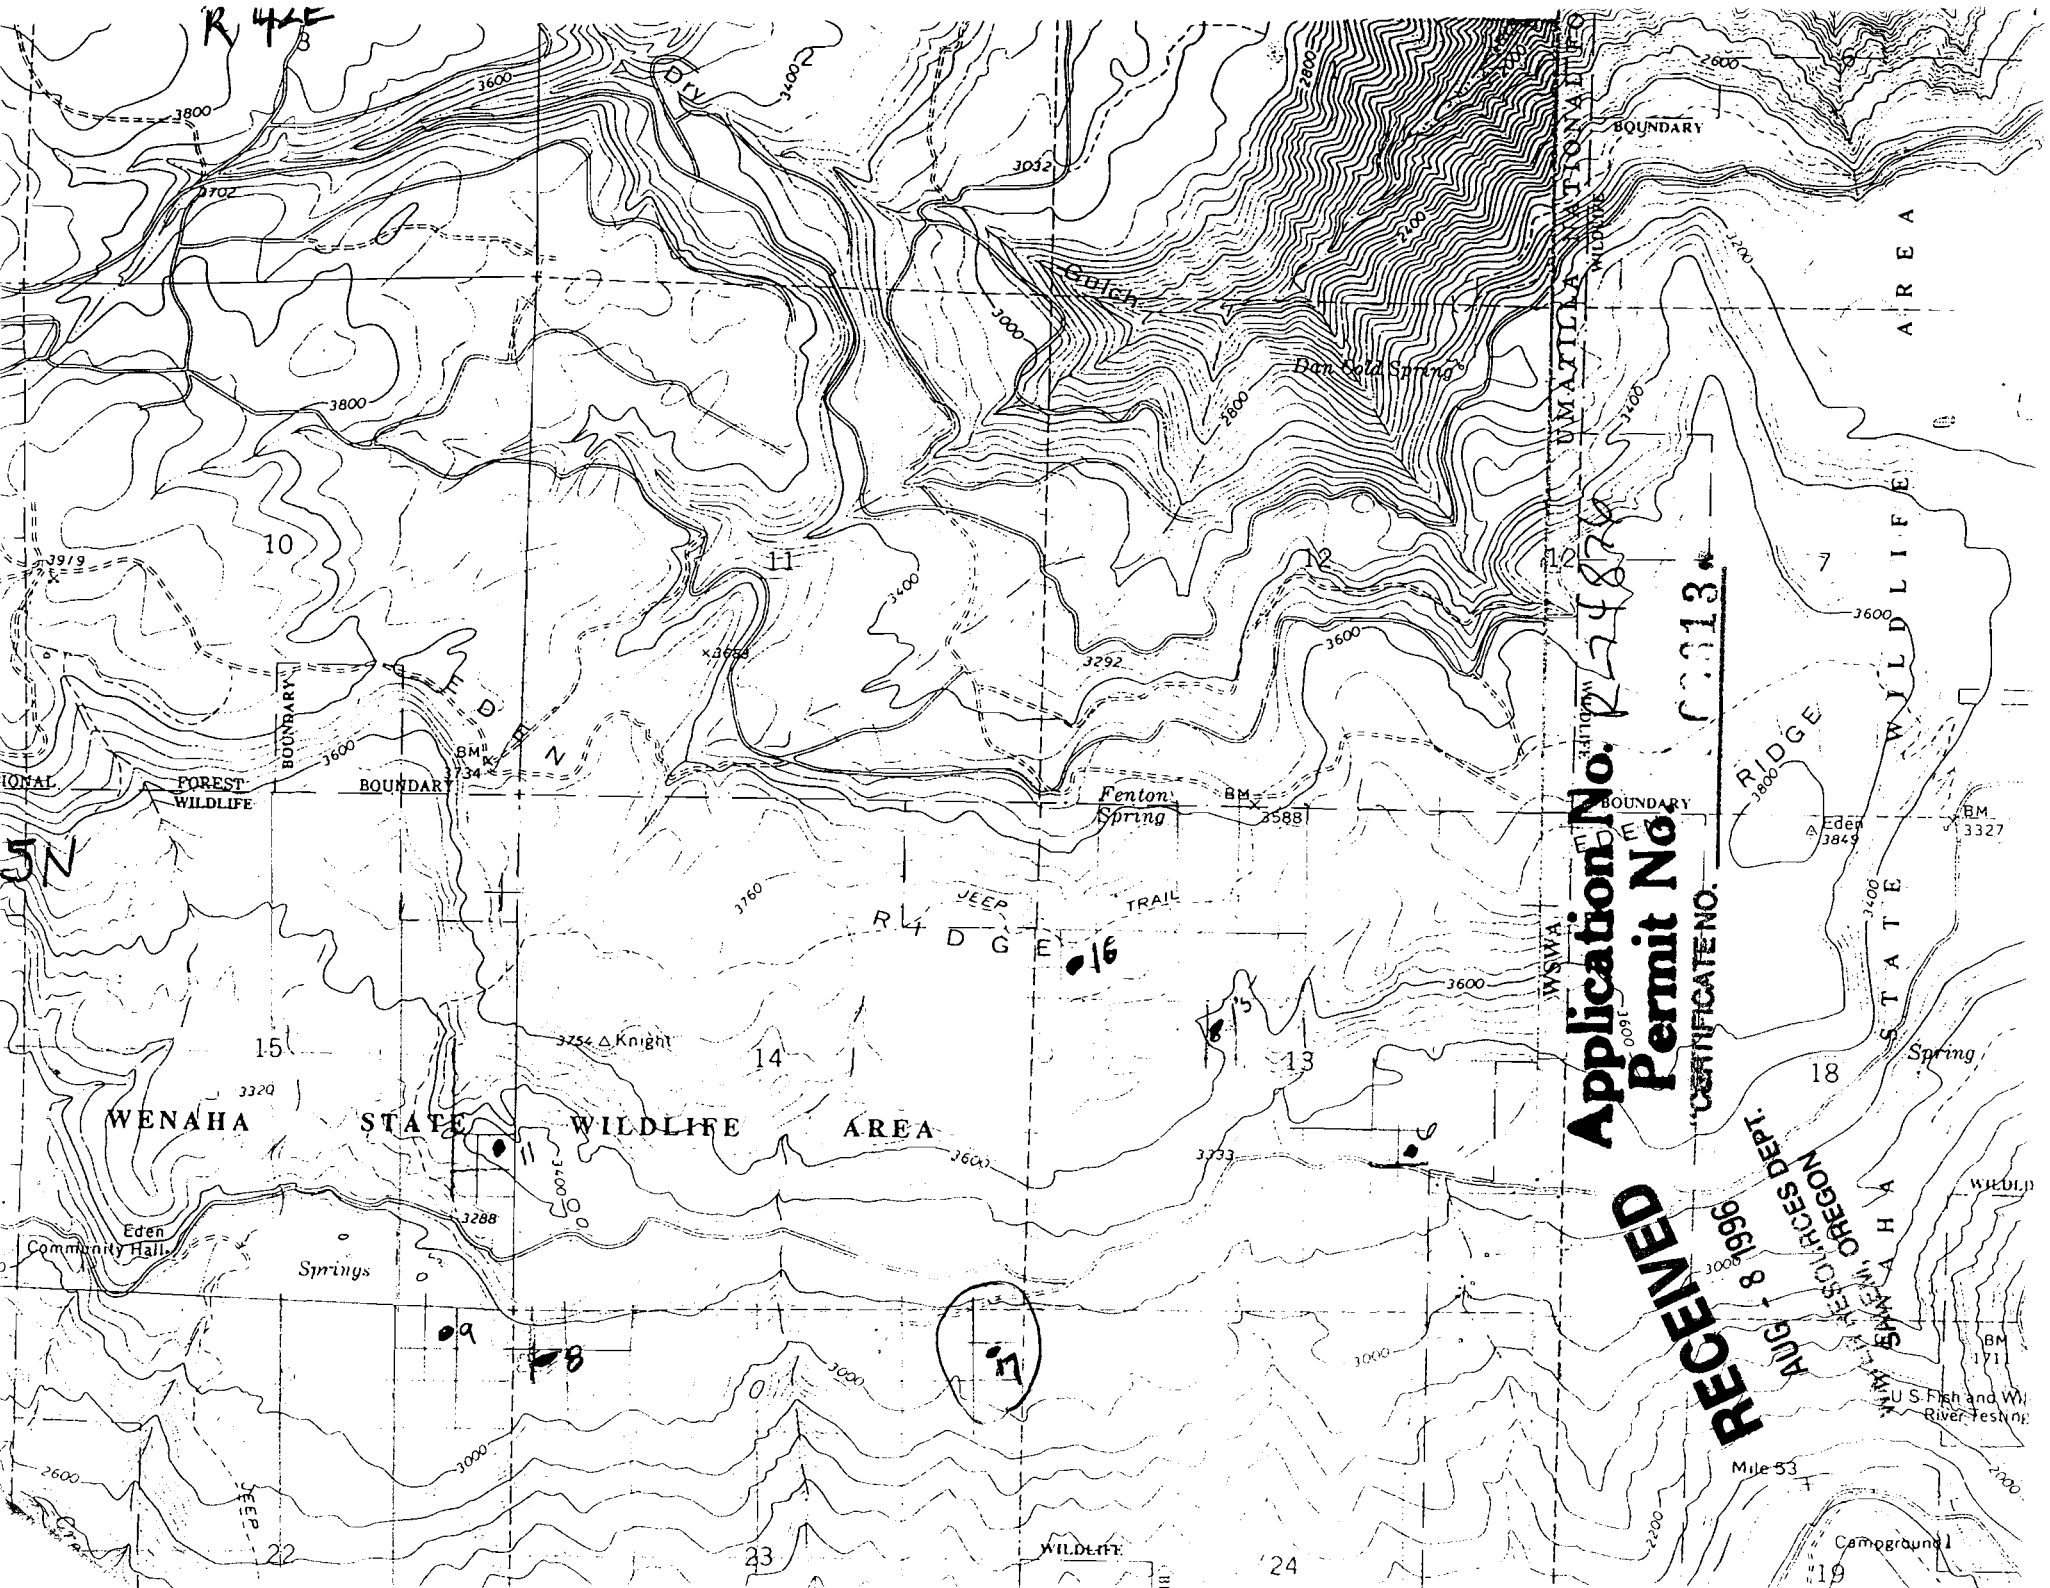



RECEIVED
DEPT.
OREGON


Mile 53

Campground

AREA

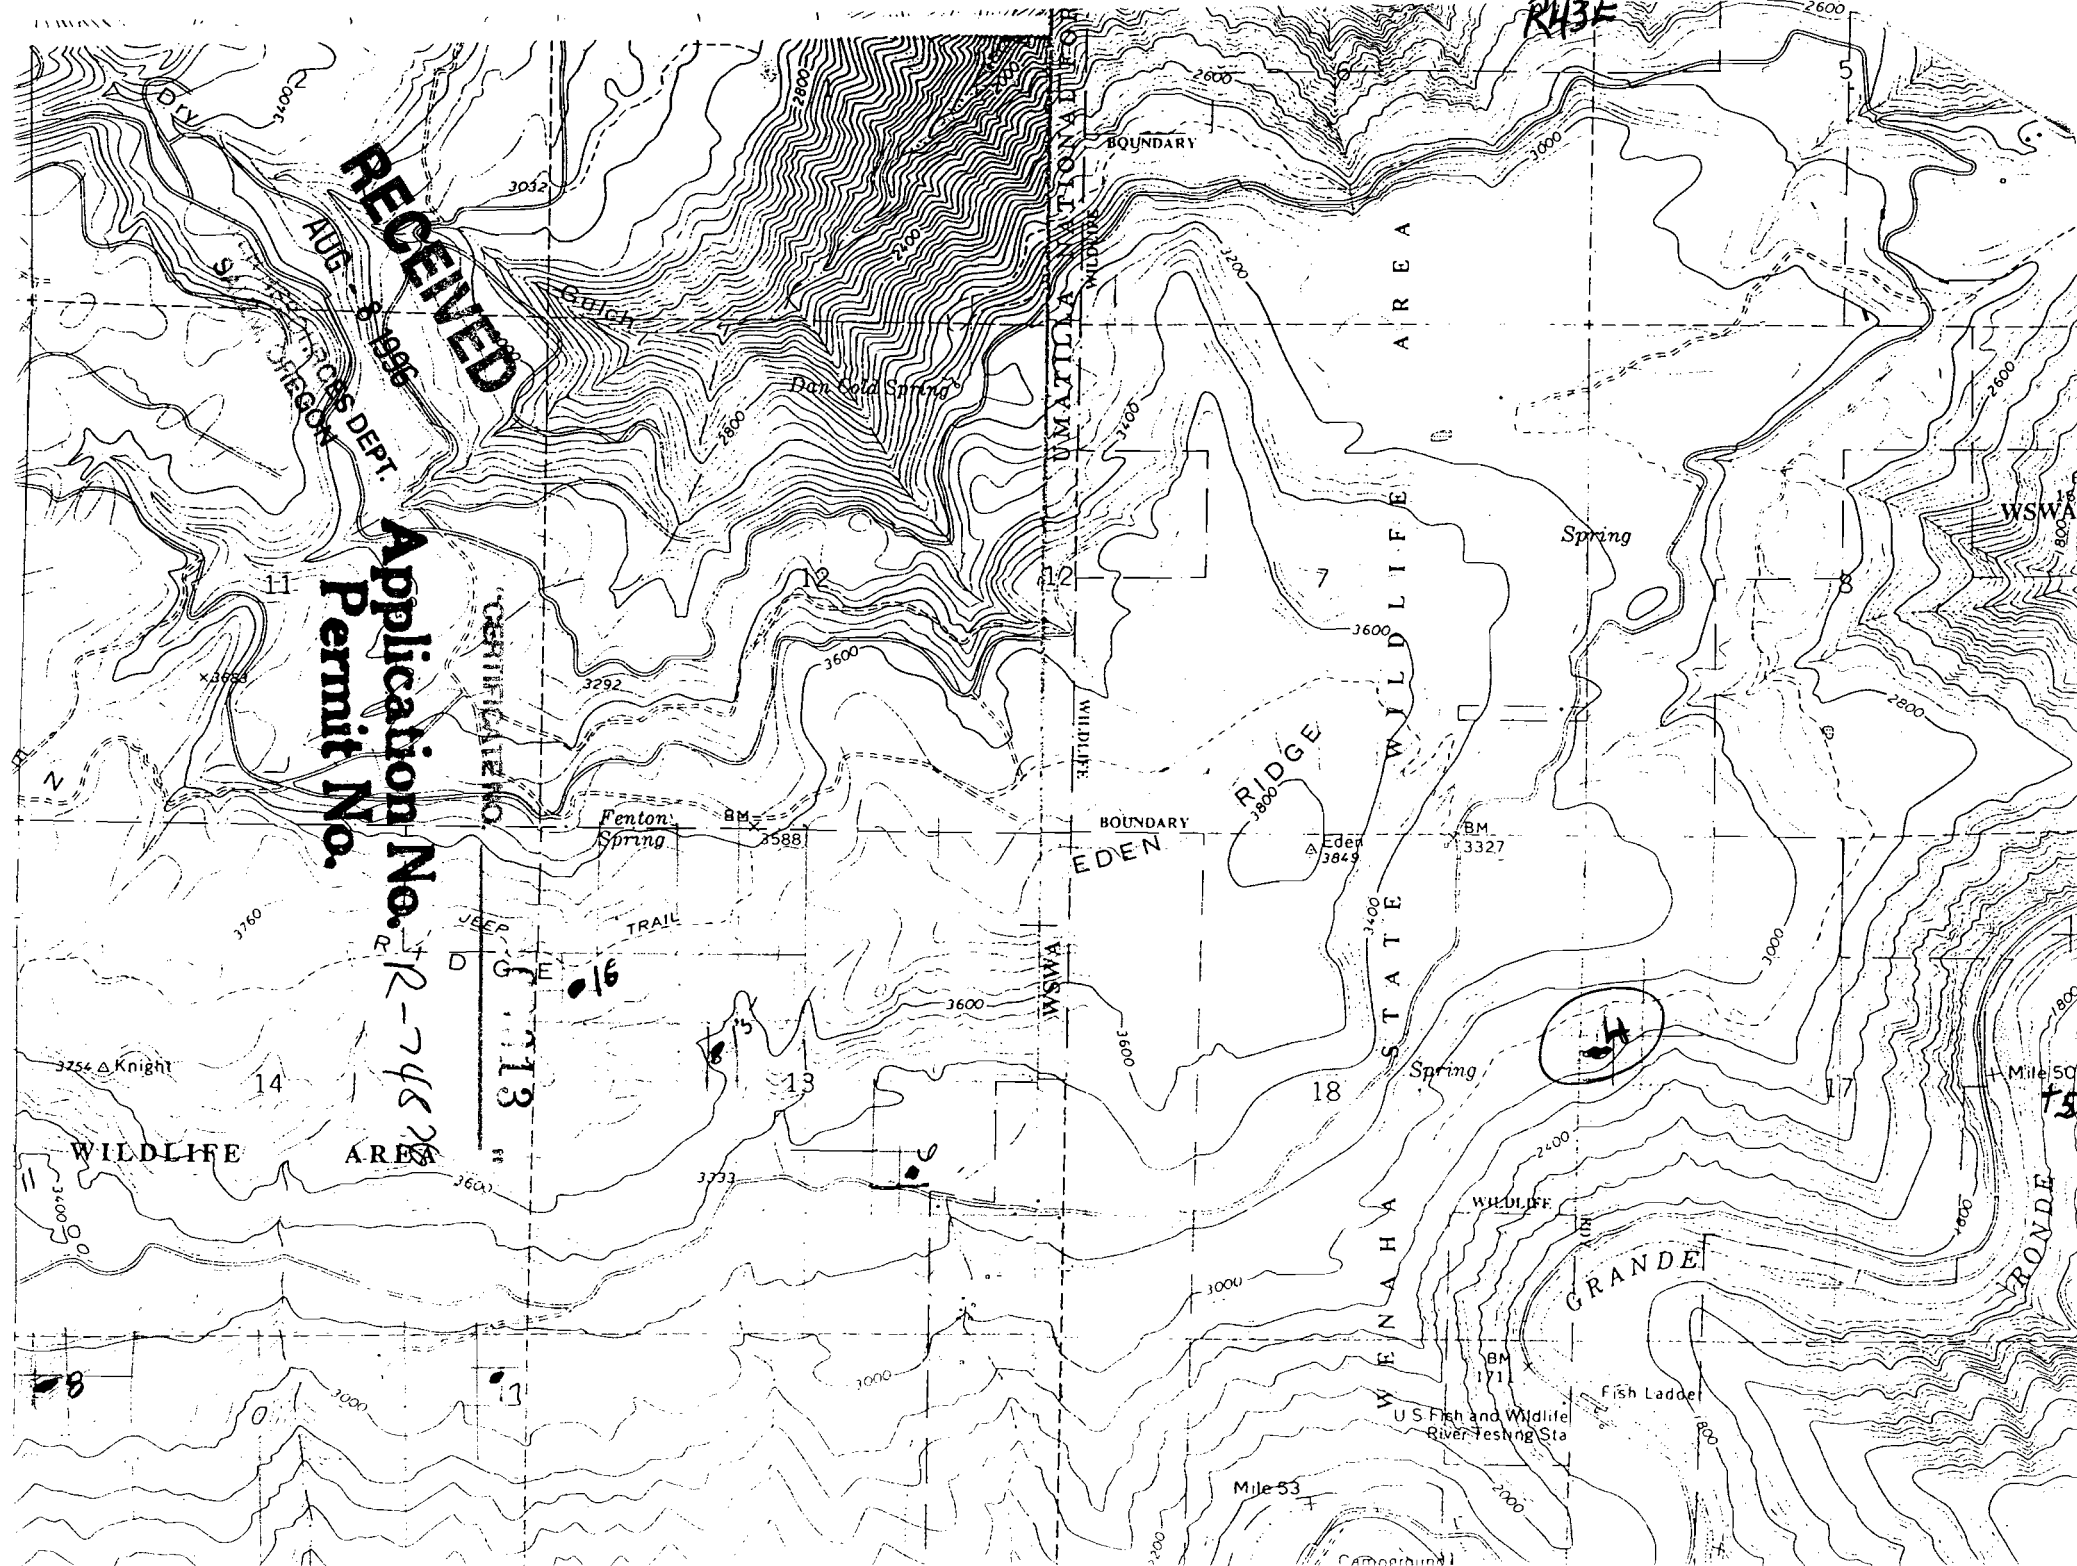

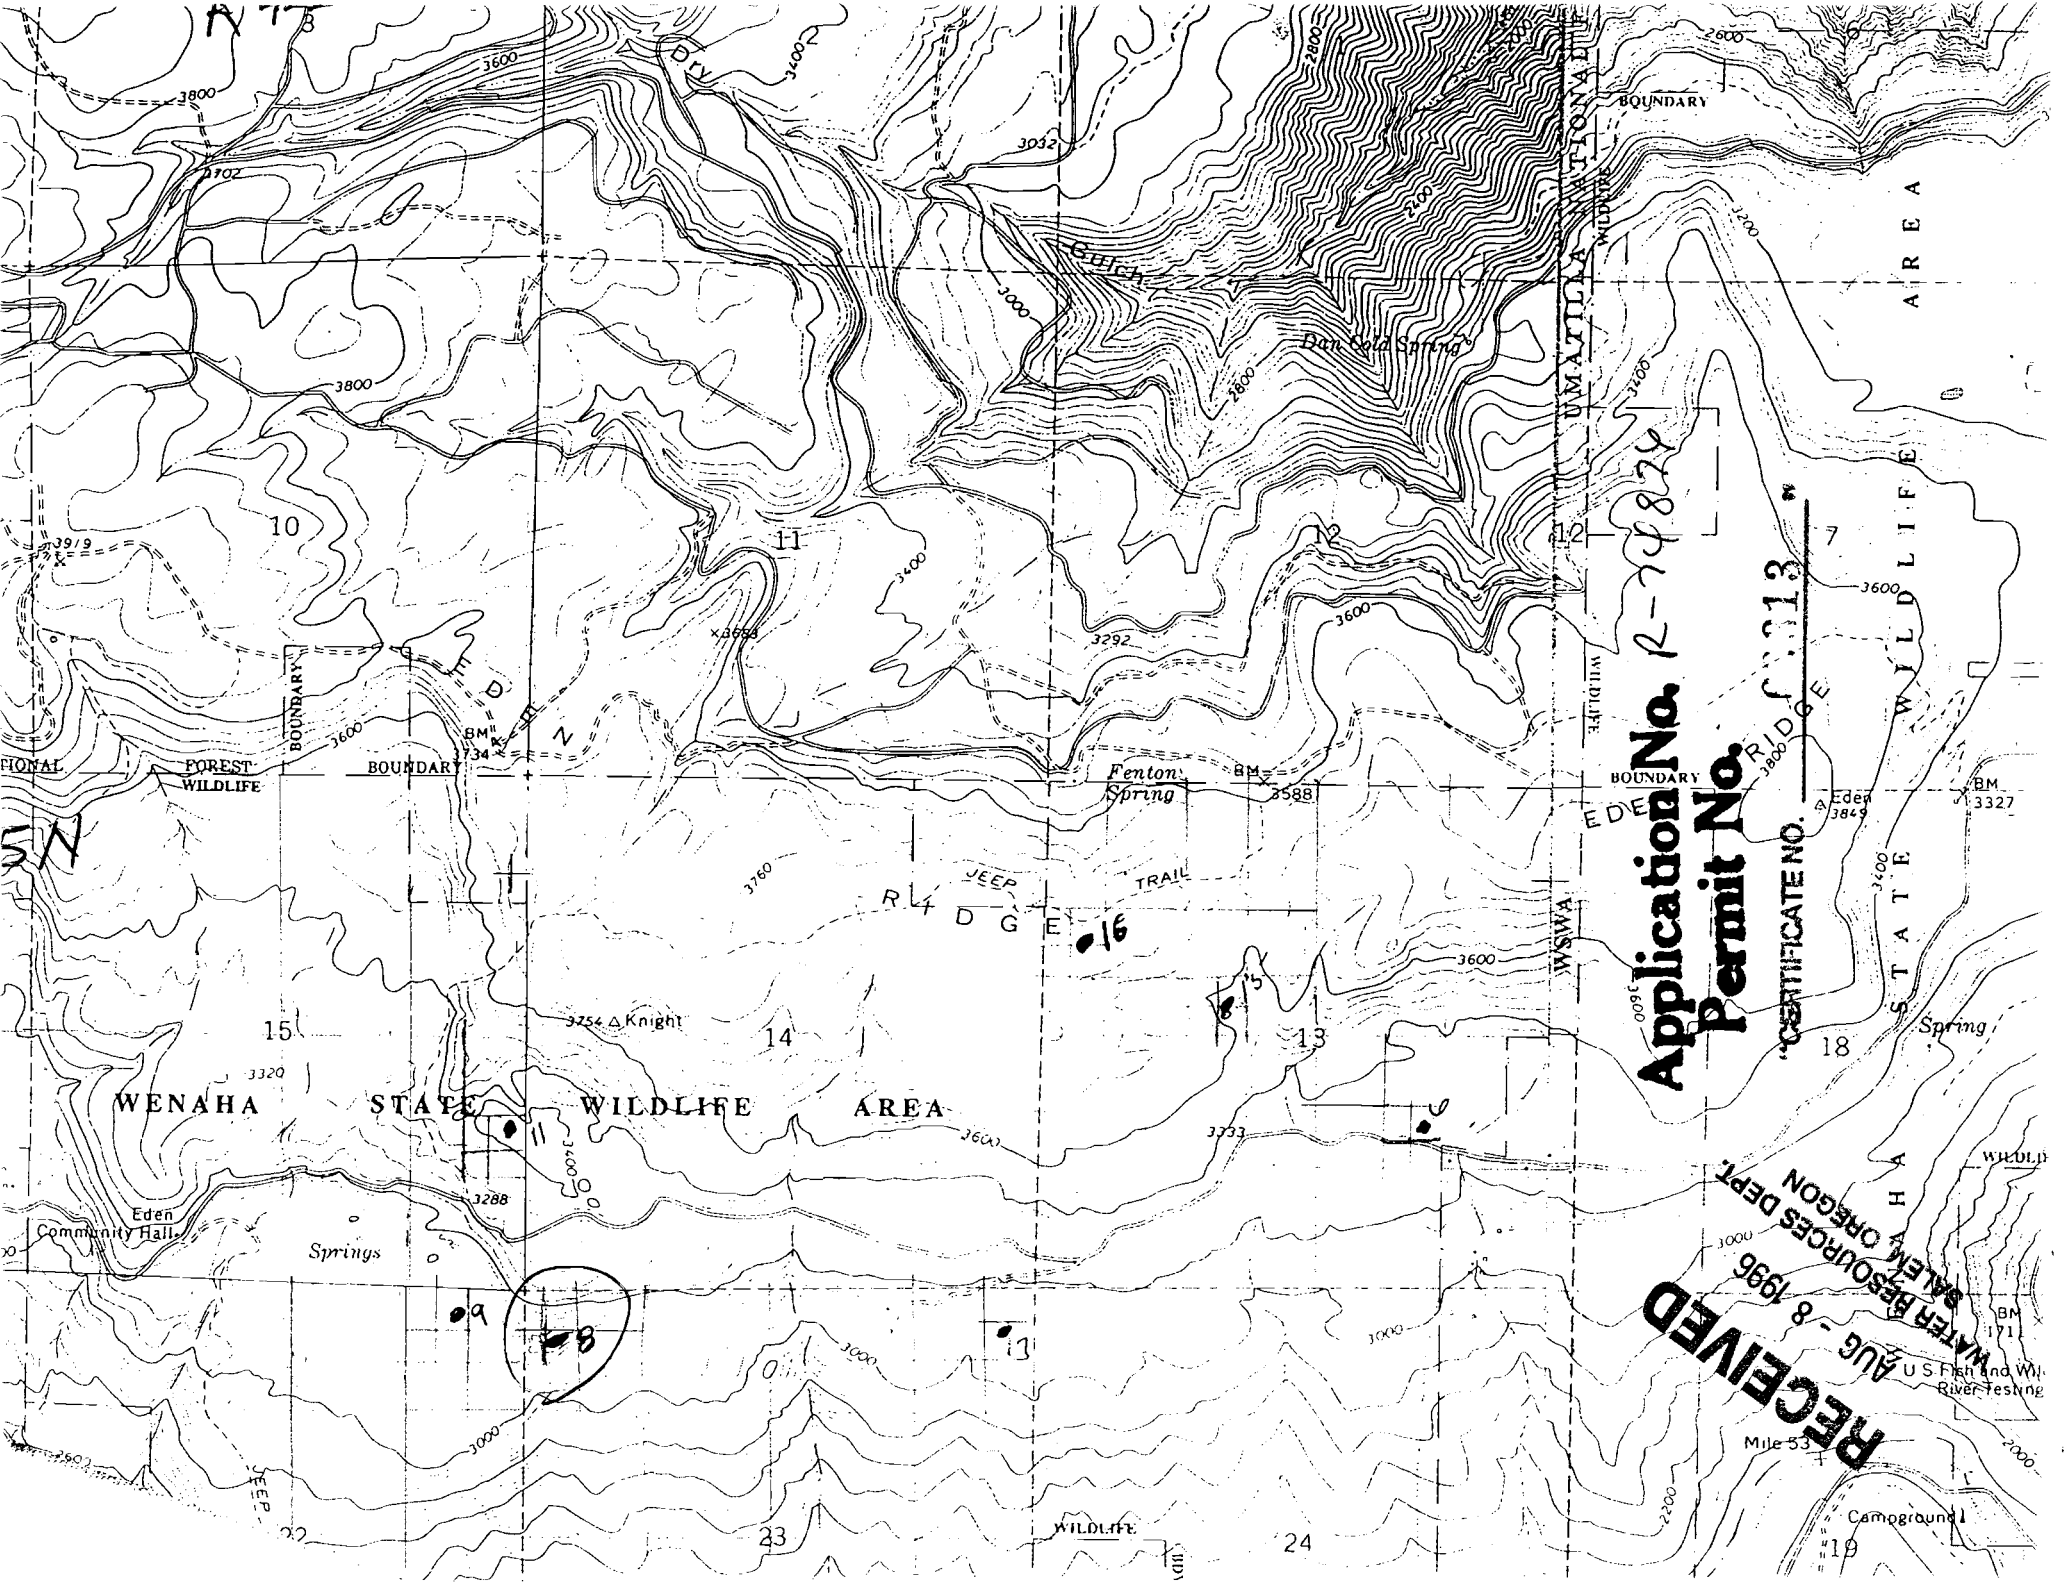

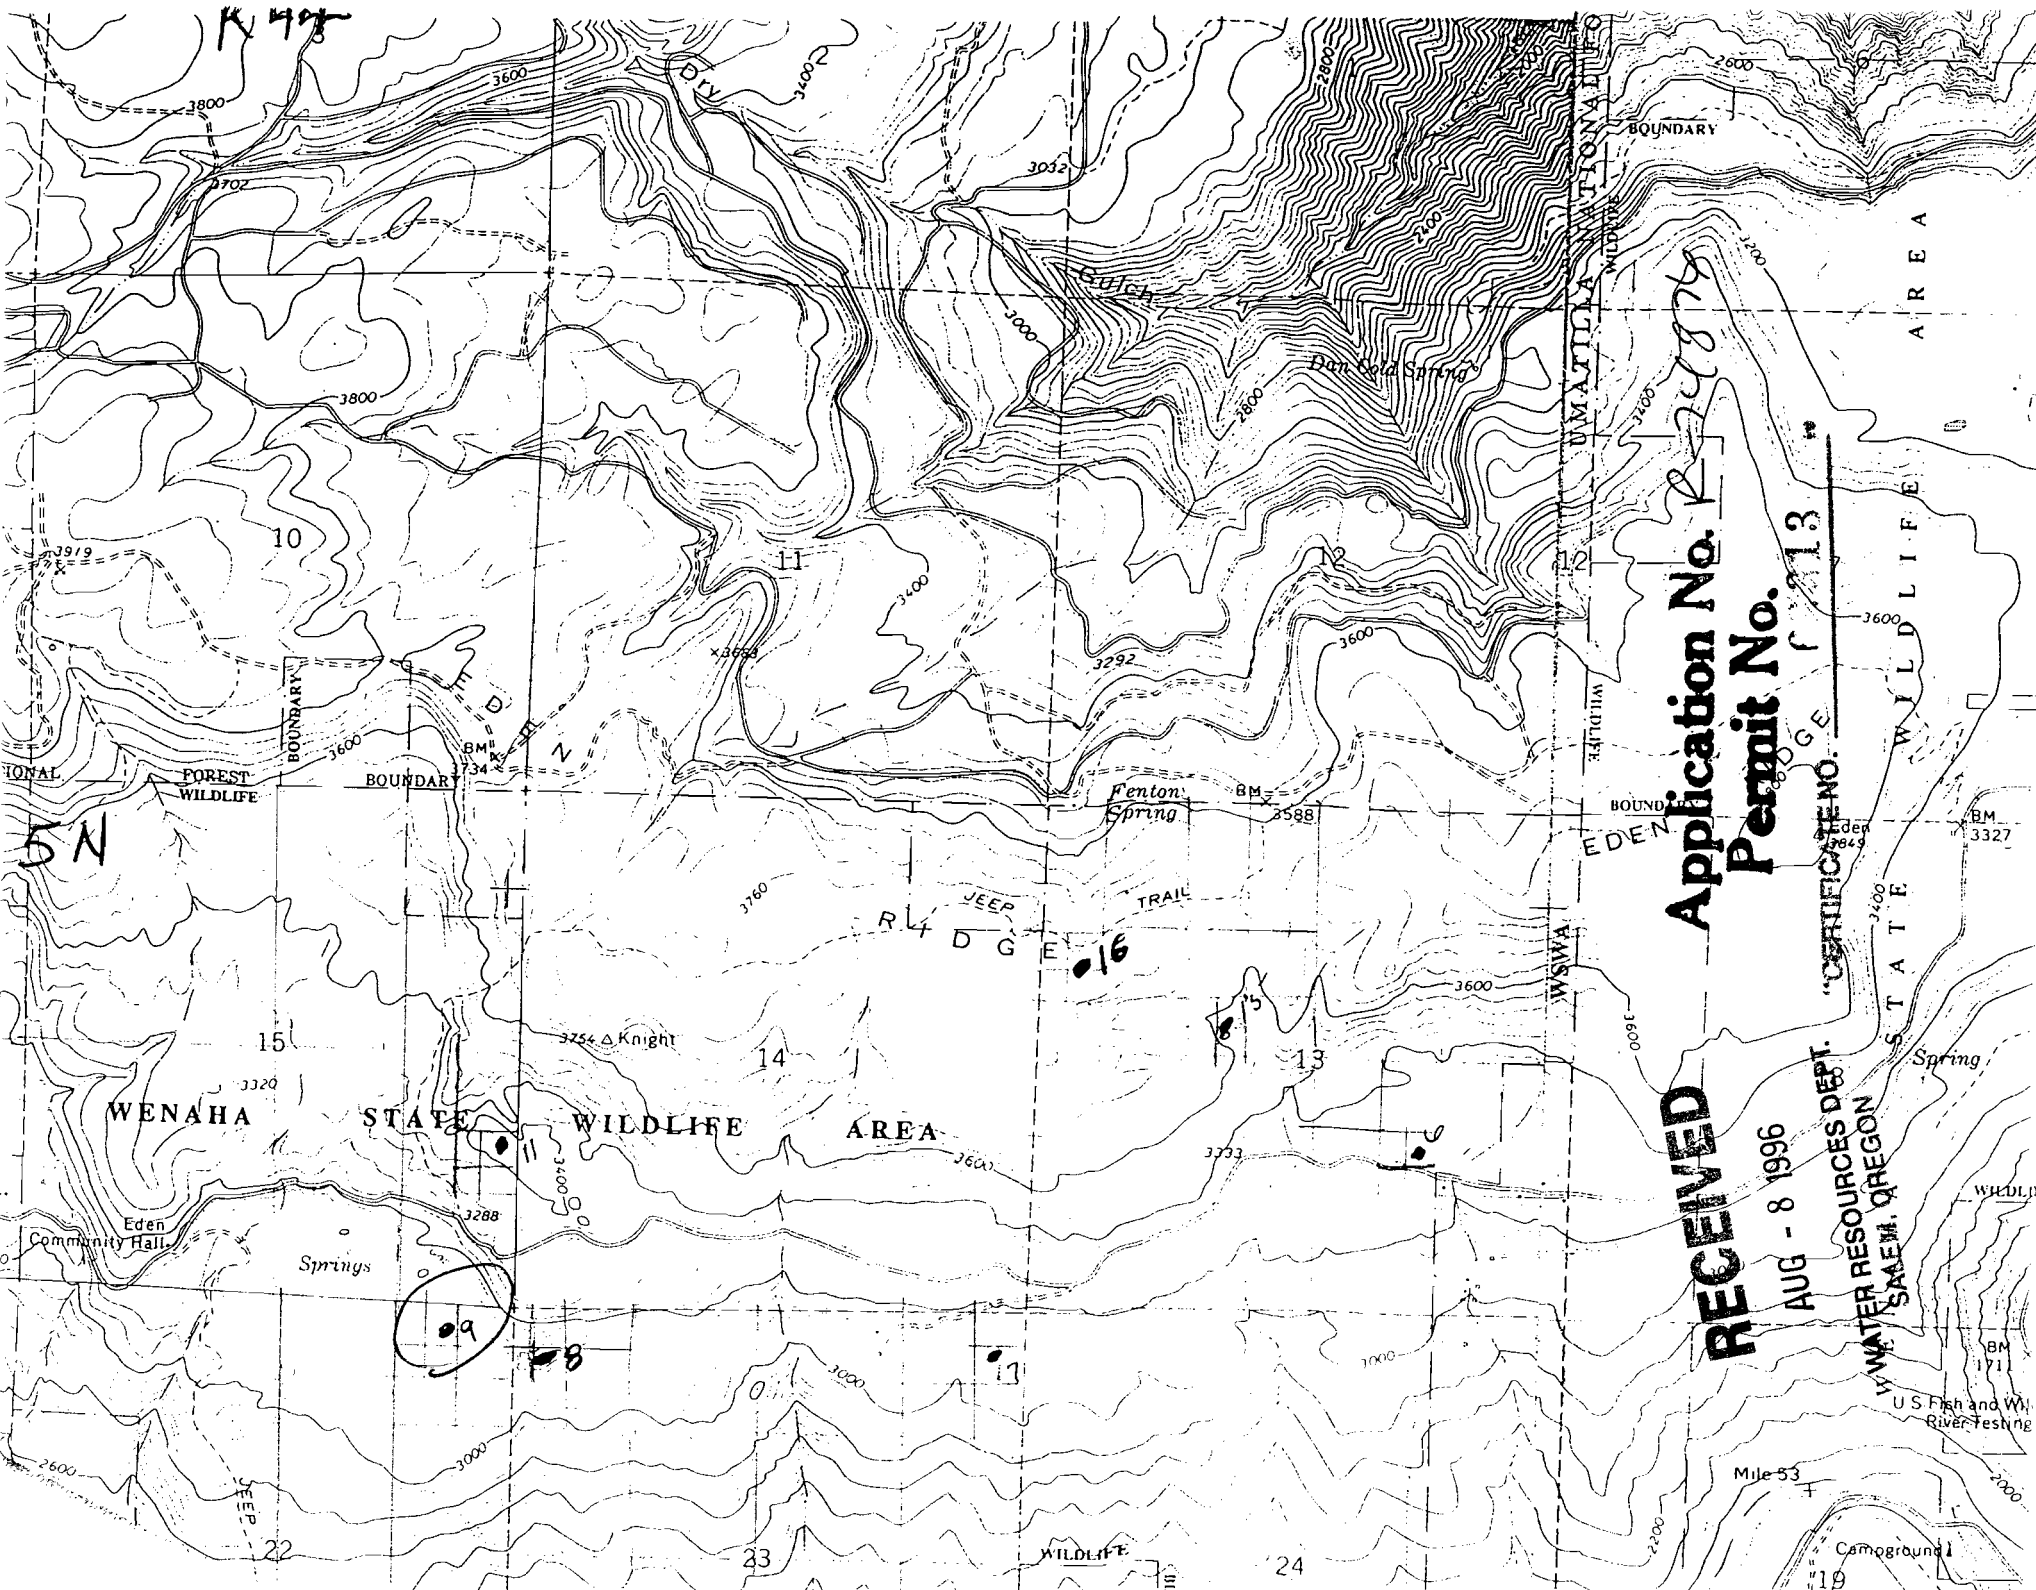

RECEIVED
Application No. **R-24878**
Permit No. **C-113**


AUG - 8 1996
WATER RESOURCES DEPT.
SALEM, OREGON

CERTIFICATE NO. **113**

U.S. Fish and Wildlife
River Testing

Mile 53

Campground

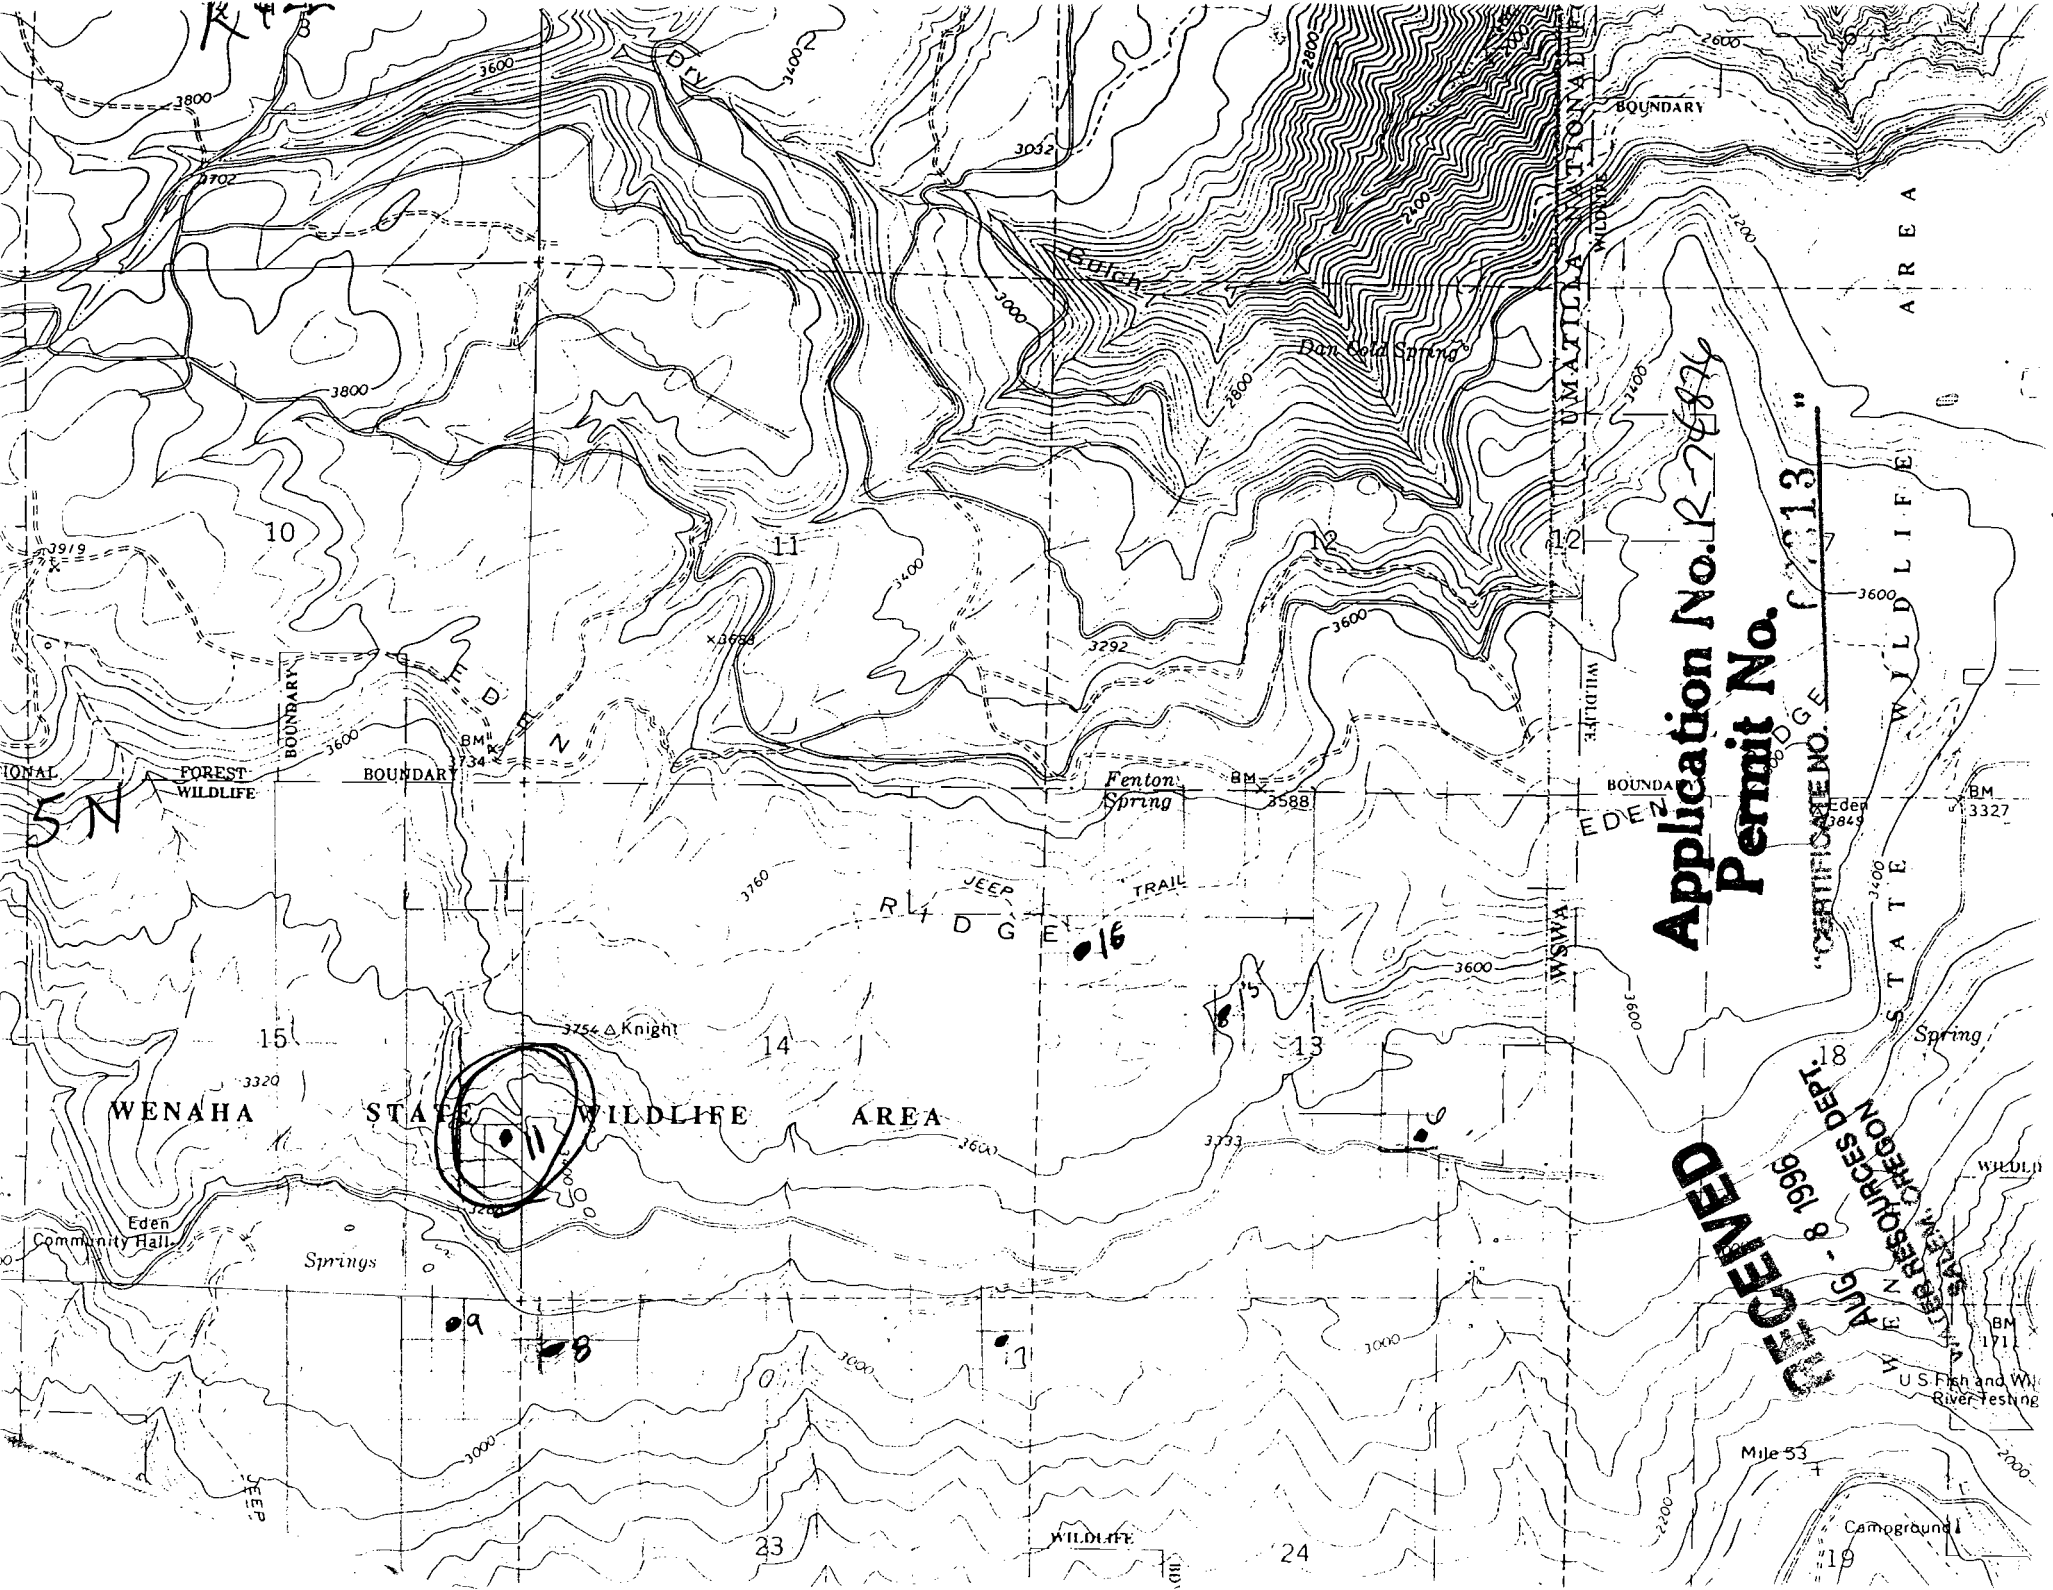

Application No. R-74876
Permit No.



8 1996

18
ES DEPT.

Mile 53

~~Campground~~

"19

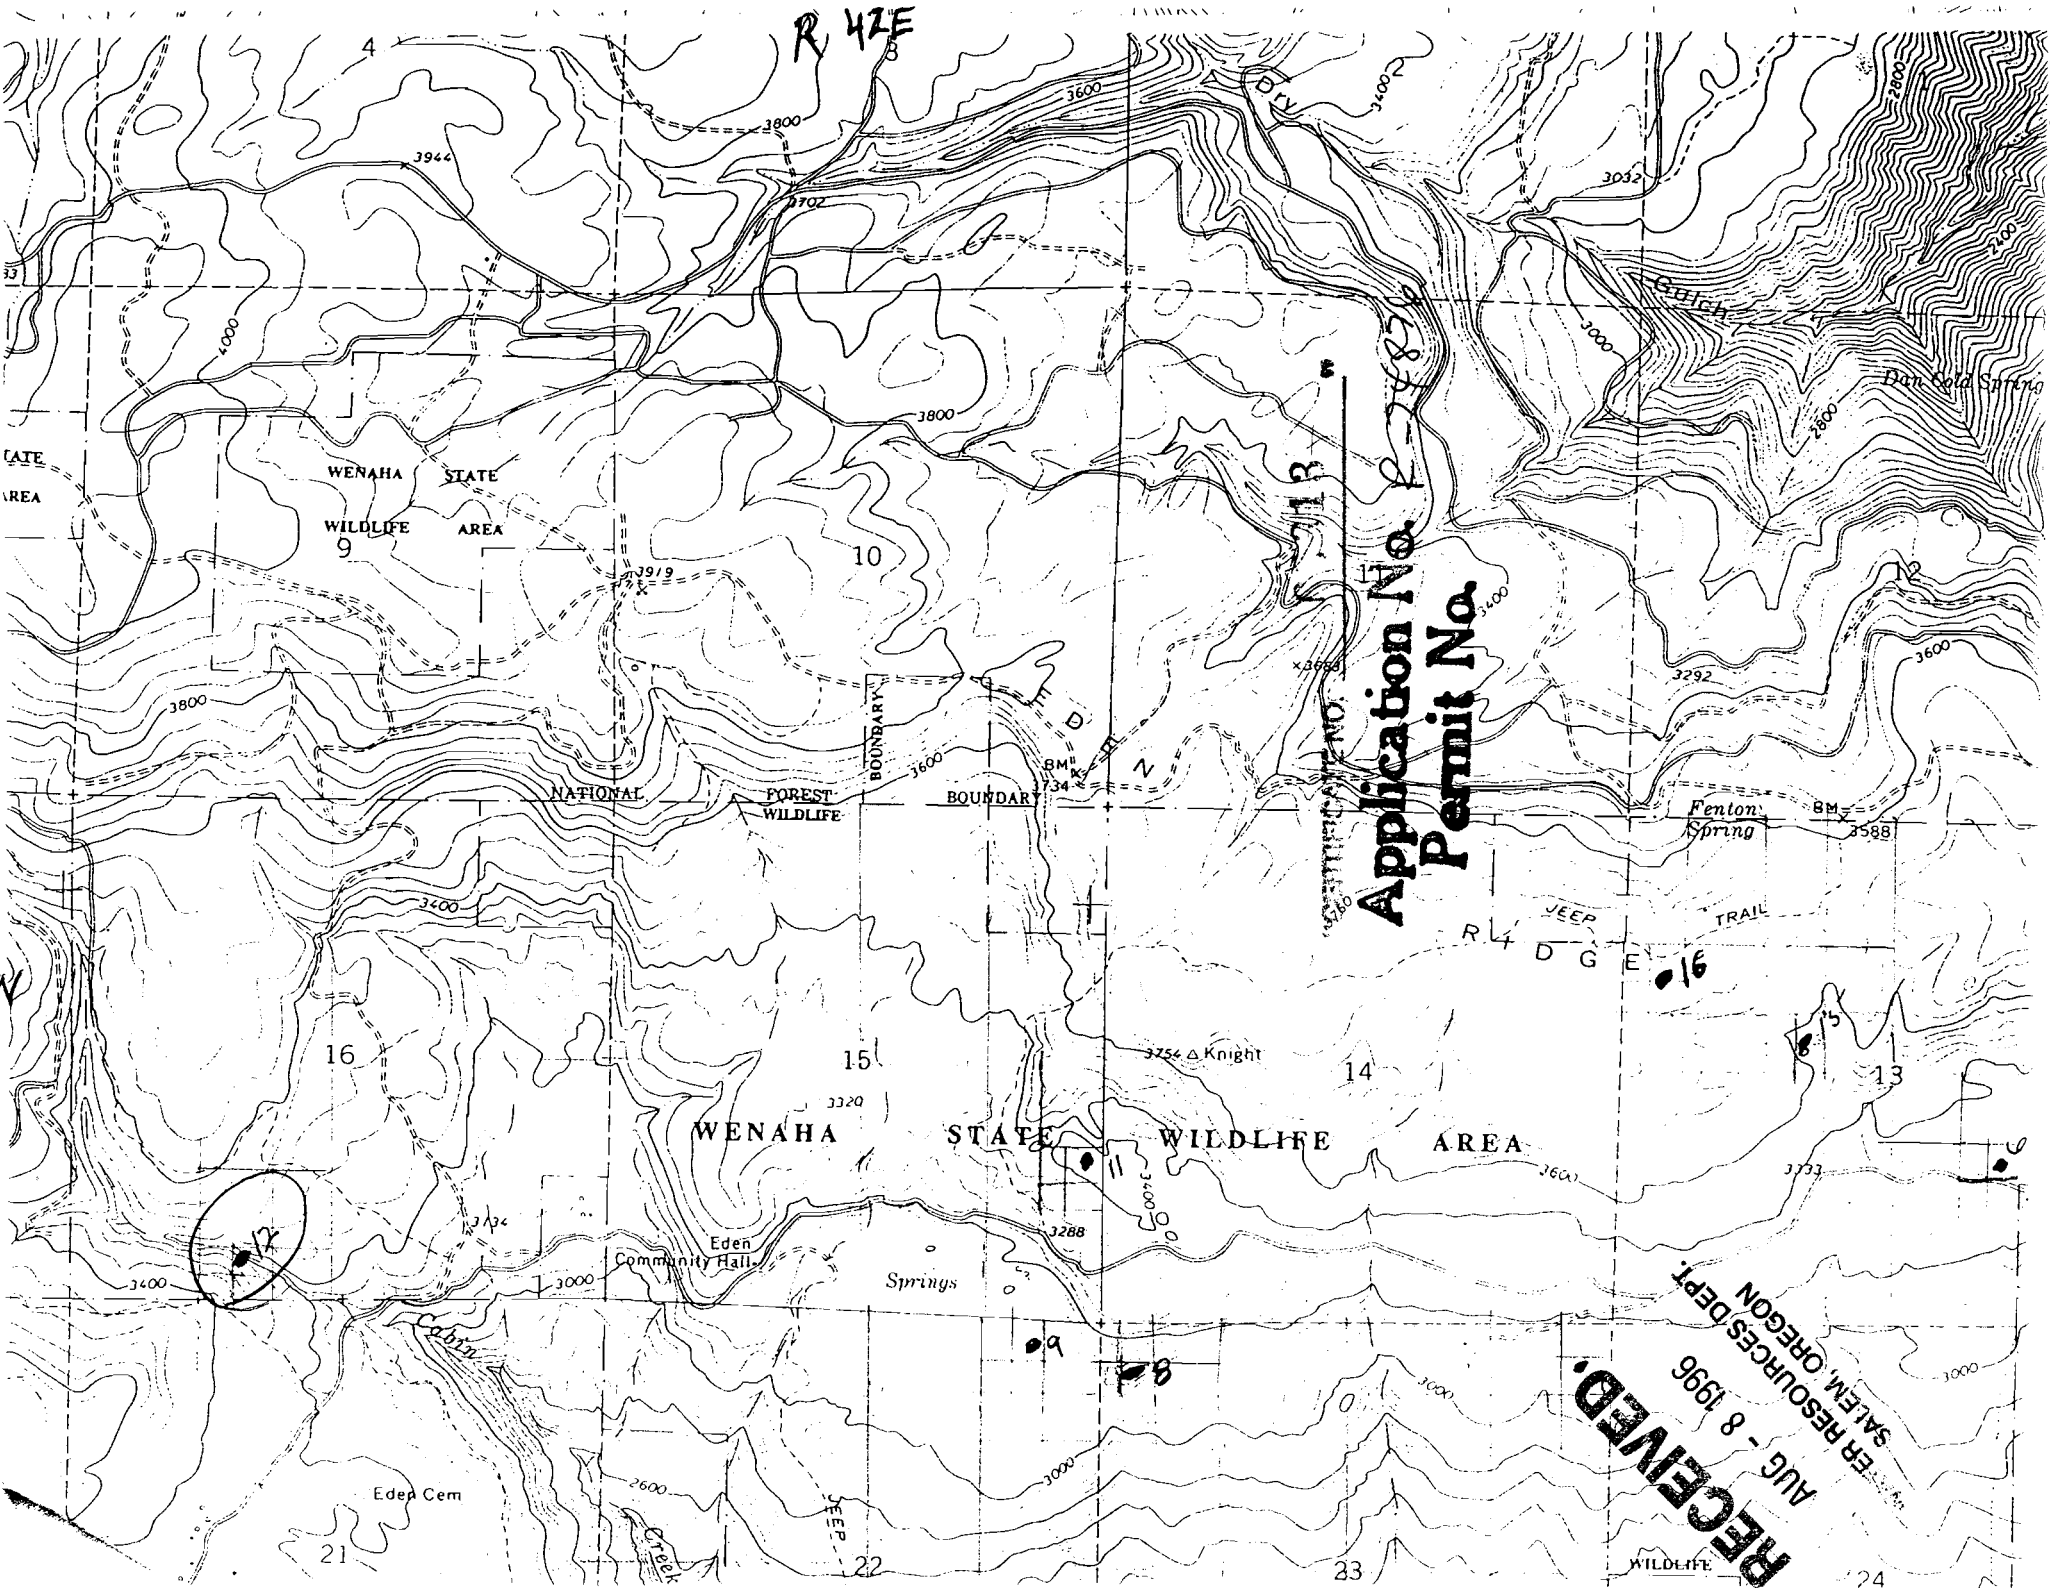

R 42E

Application No. R-24886

RECEIVED
AUG - 8 1996
WILDLIFE
ER RESOURCES DEPT.

WENAH
STATE
WILDLIFE
AREA

NATIONAL
FOREST
WILDLIFE

WENAH
STATE
WILDLIFE
AREA

Eden Cem

Eden
Community Hall

Springs

Fenton
Spring

Dan Gold Spring

