


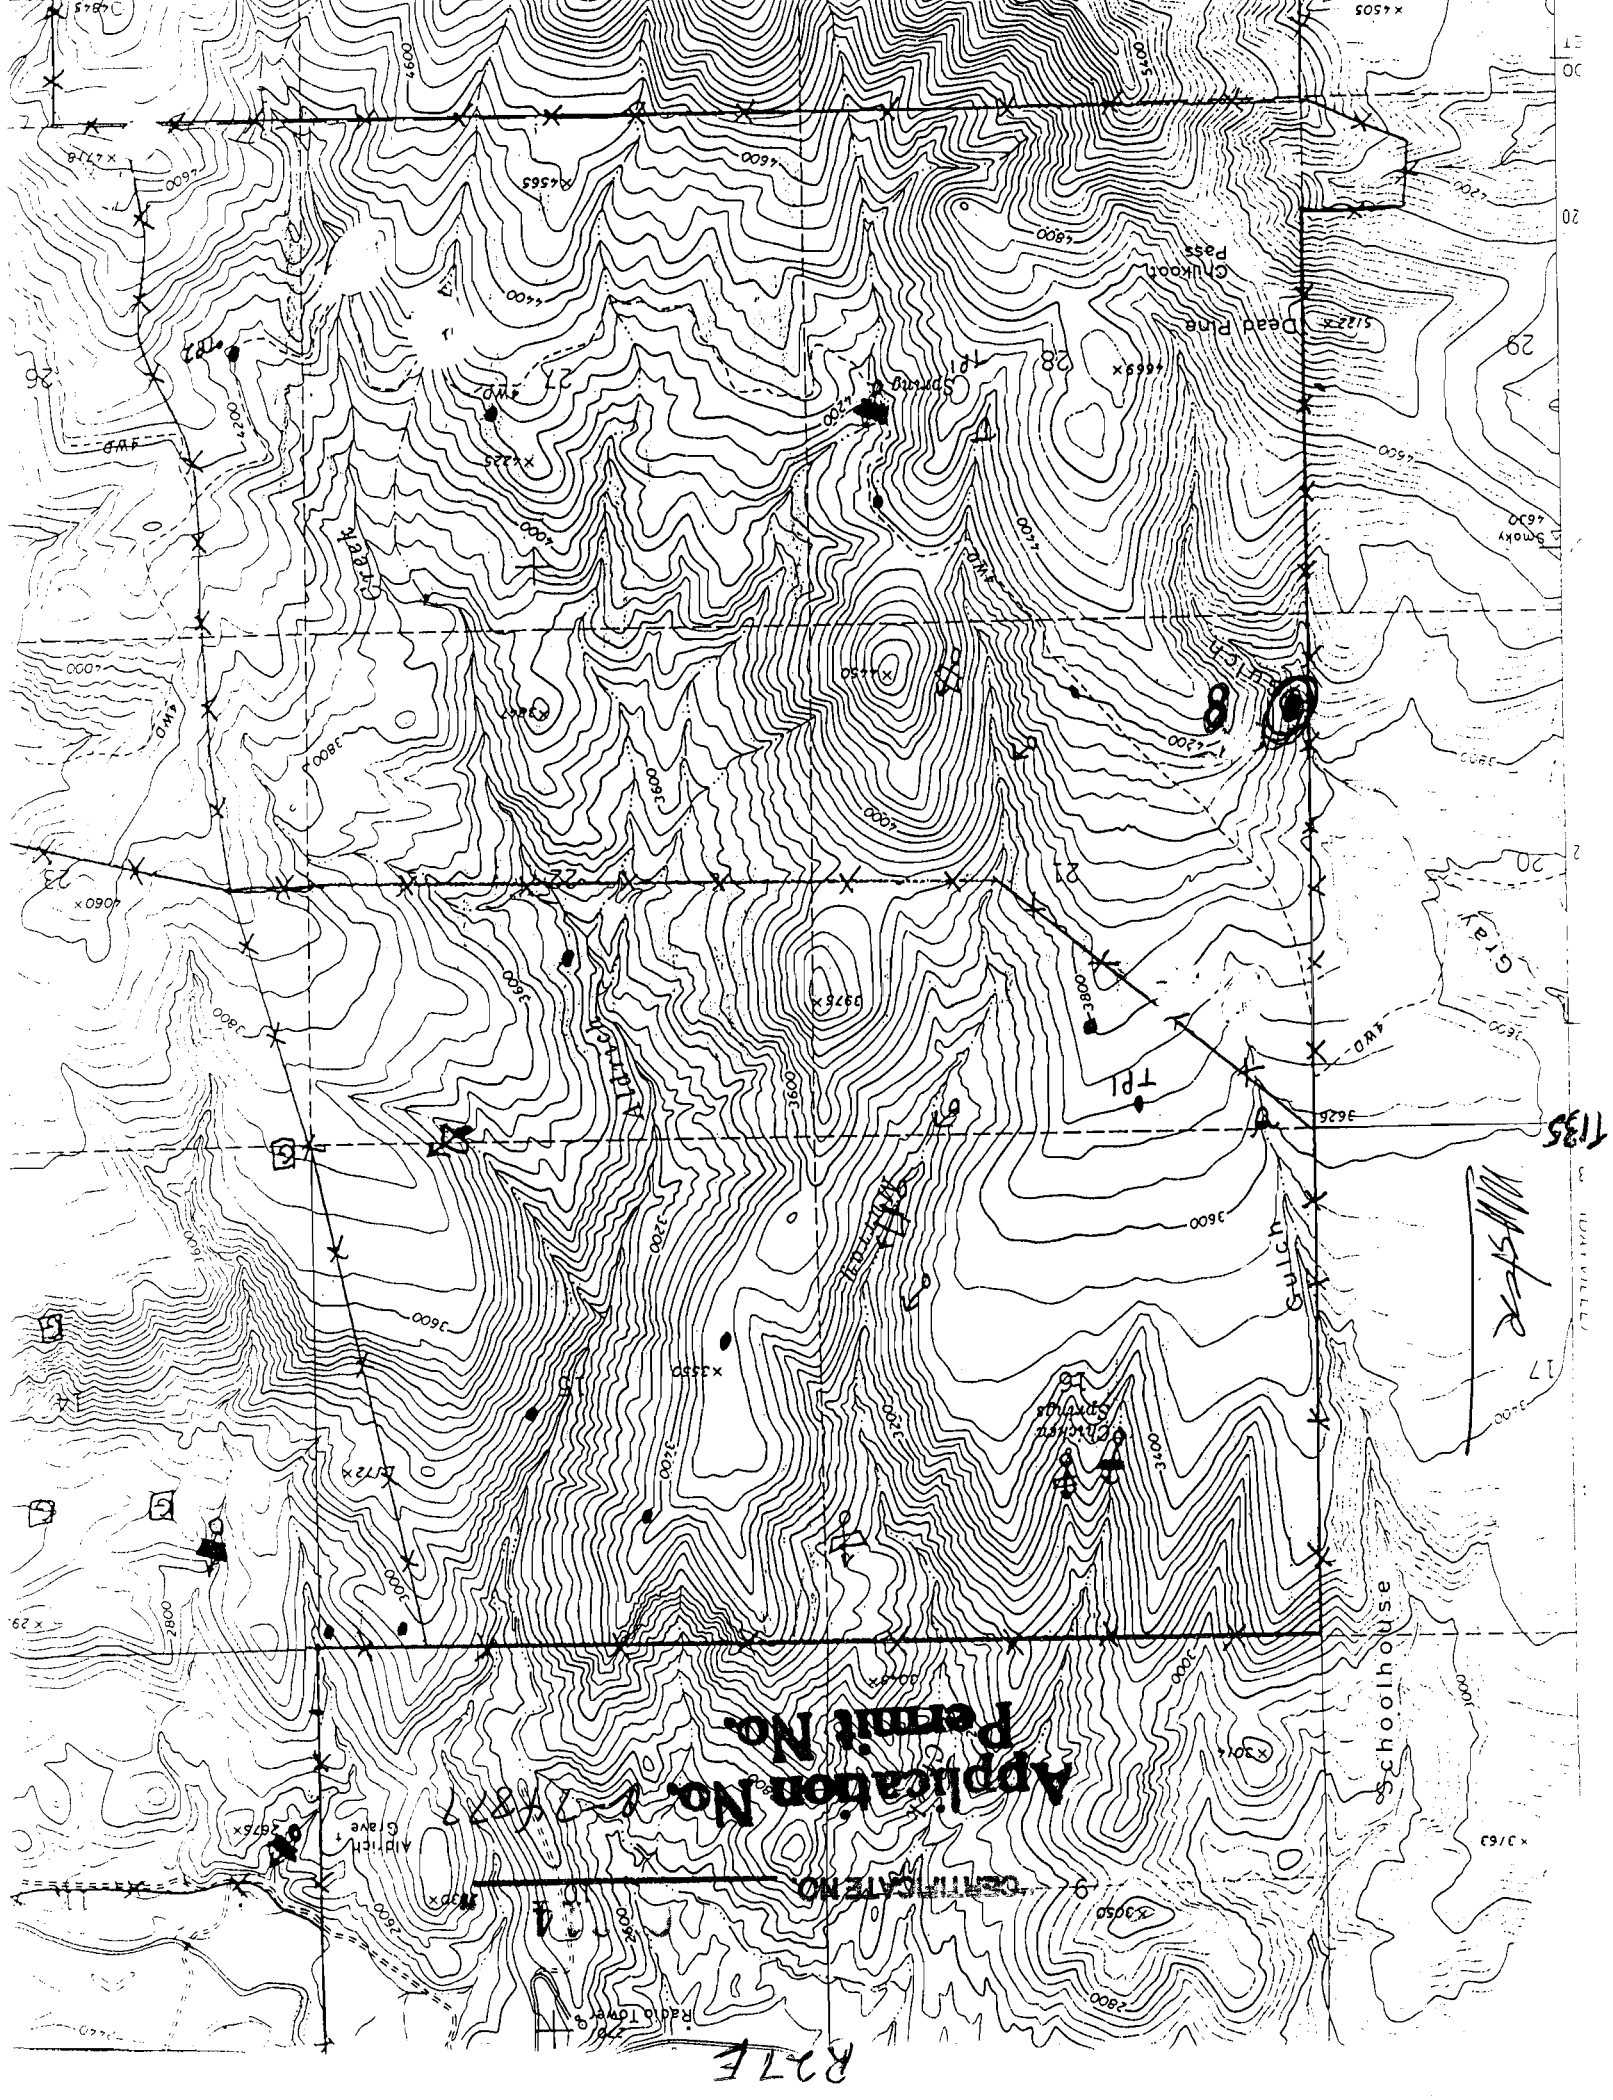

Application No. 17879
Permit No.

R27E

Master

1135


20


29

28

27

26

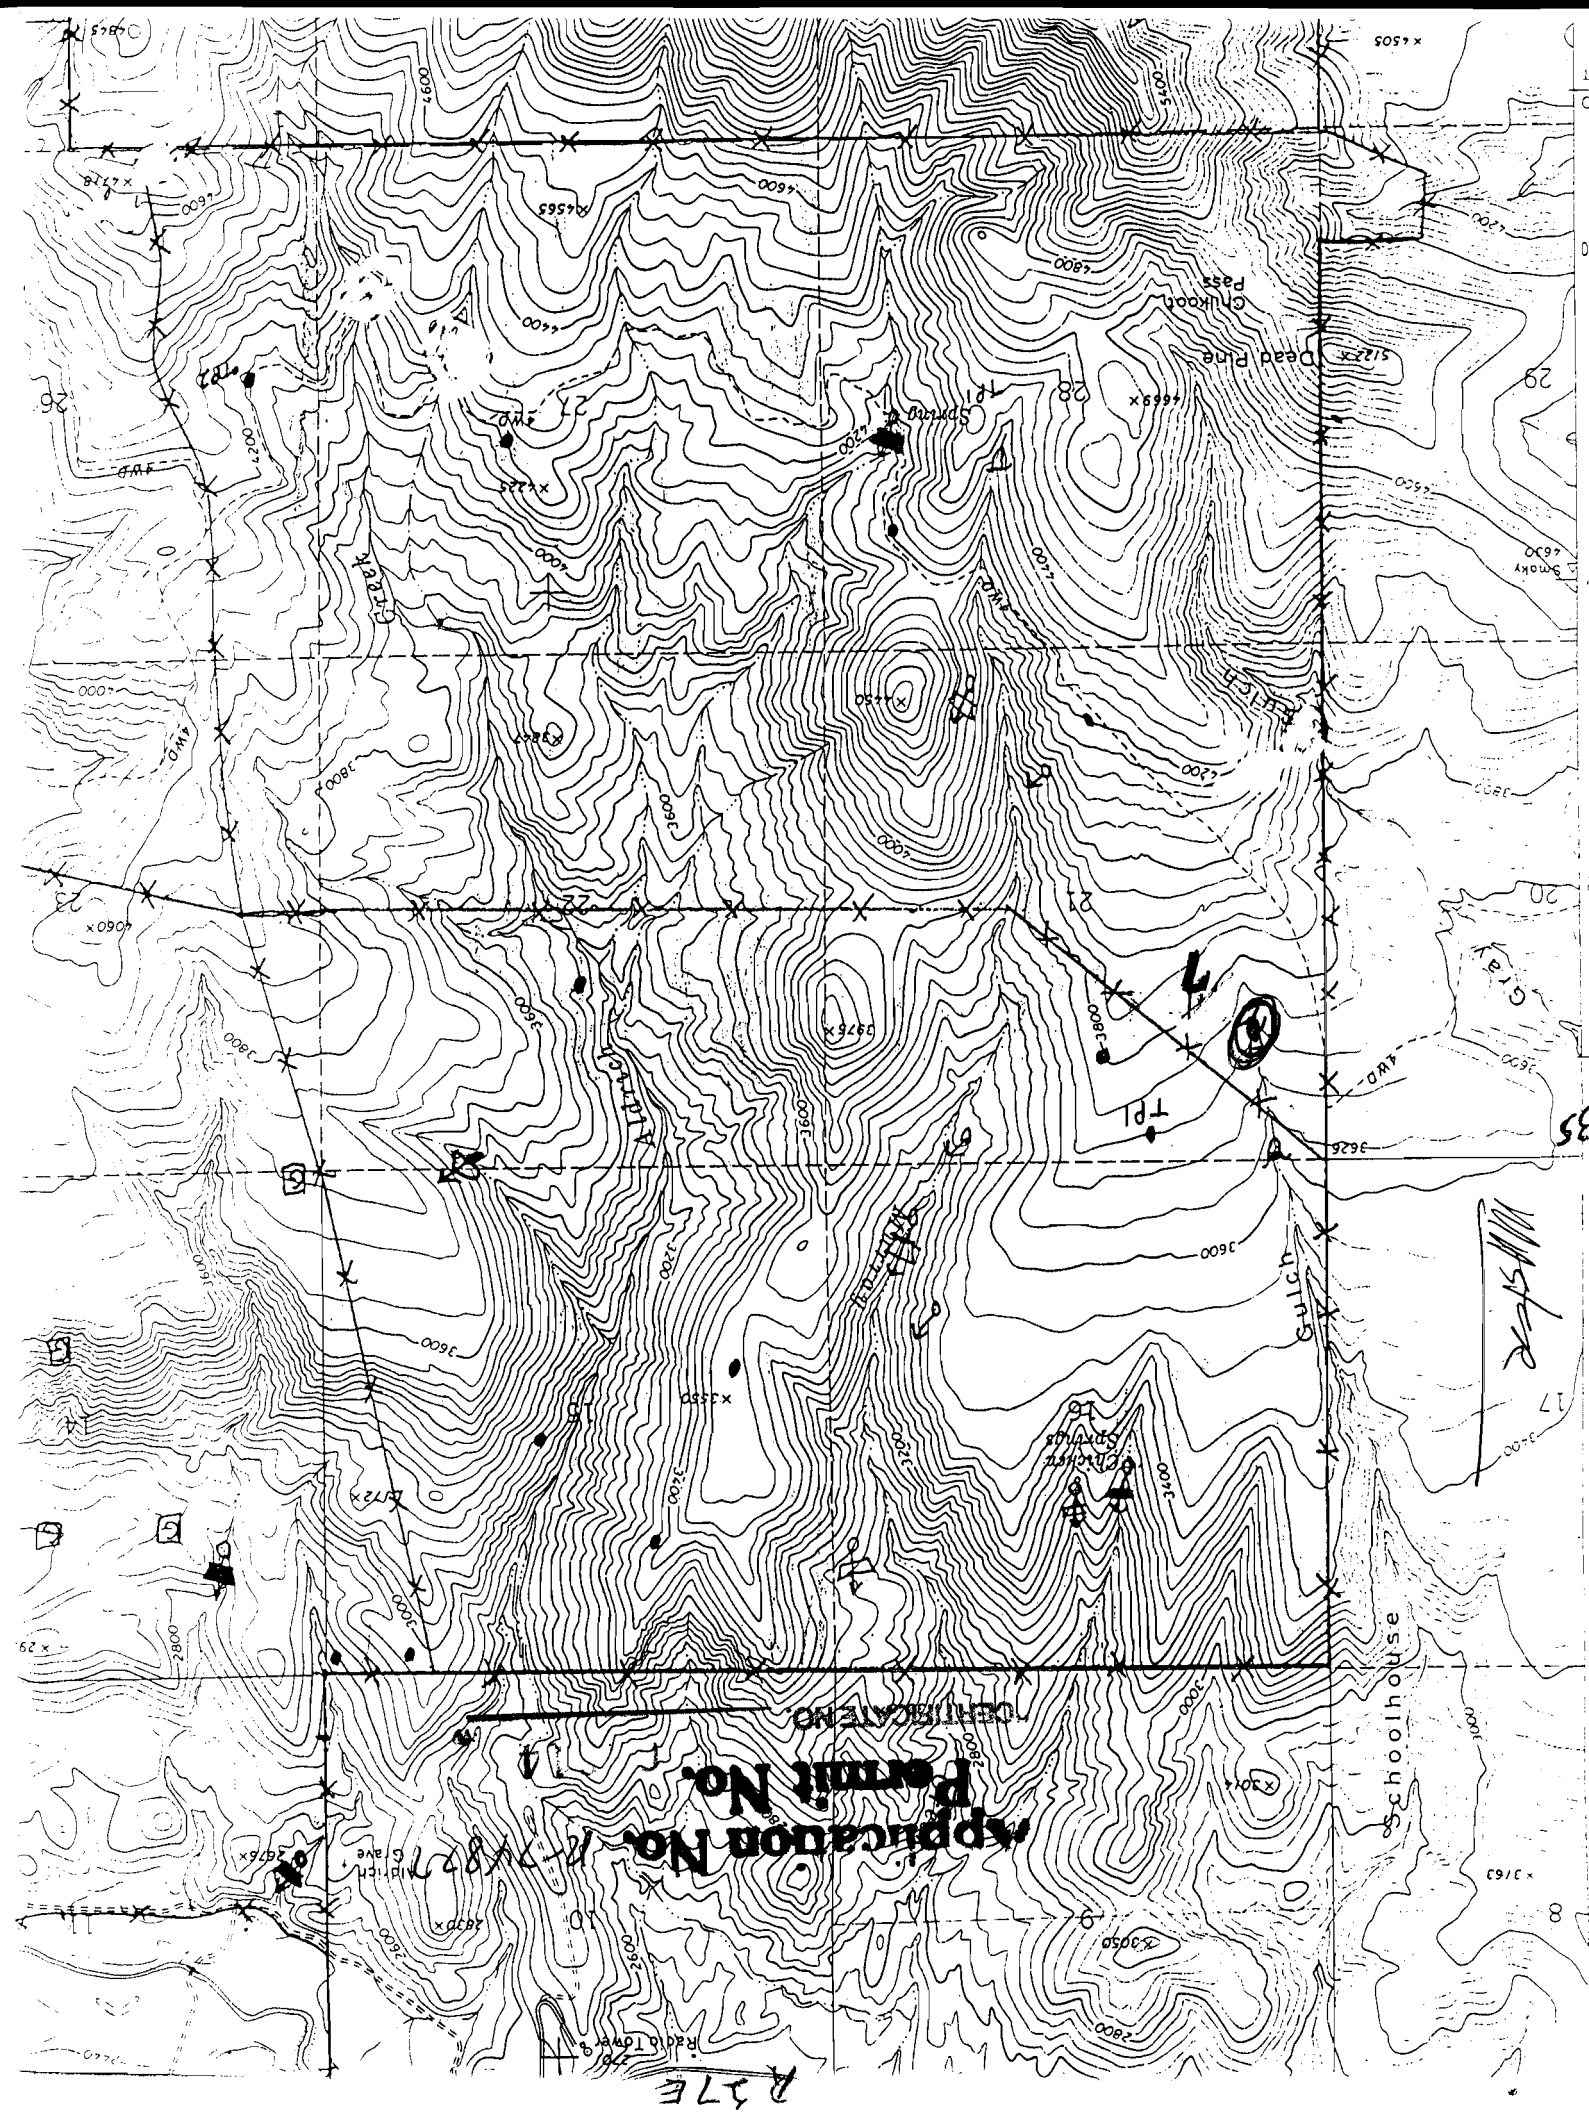

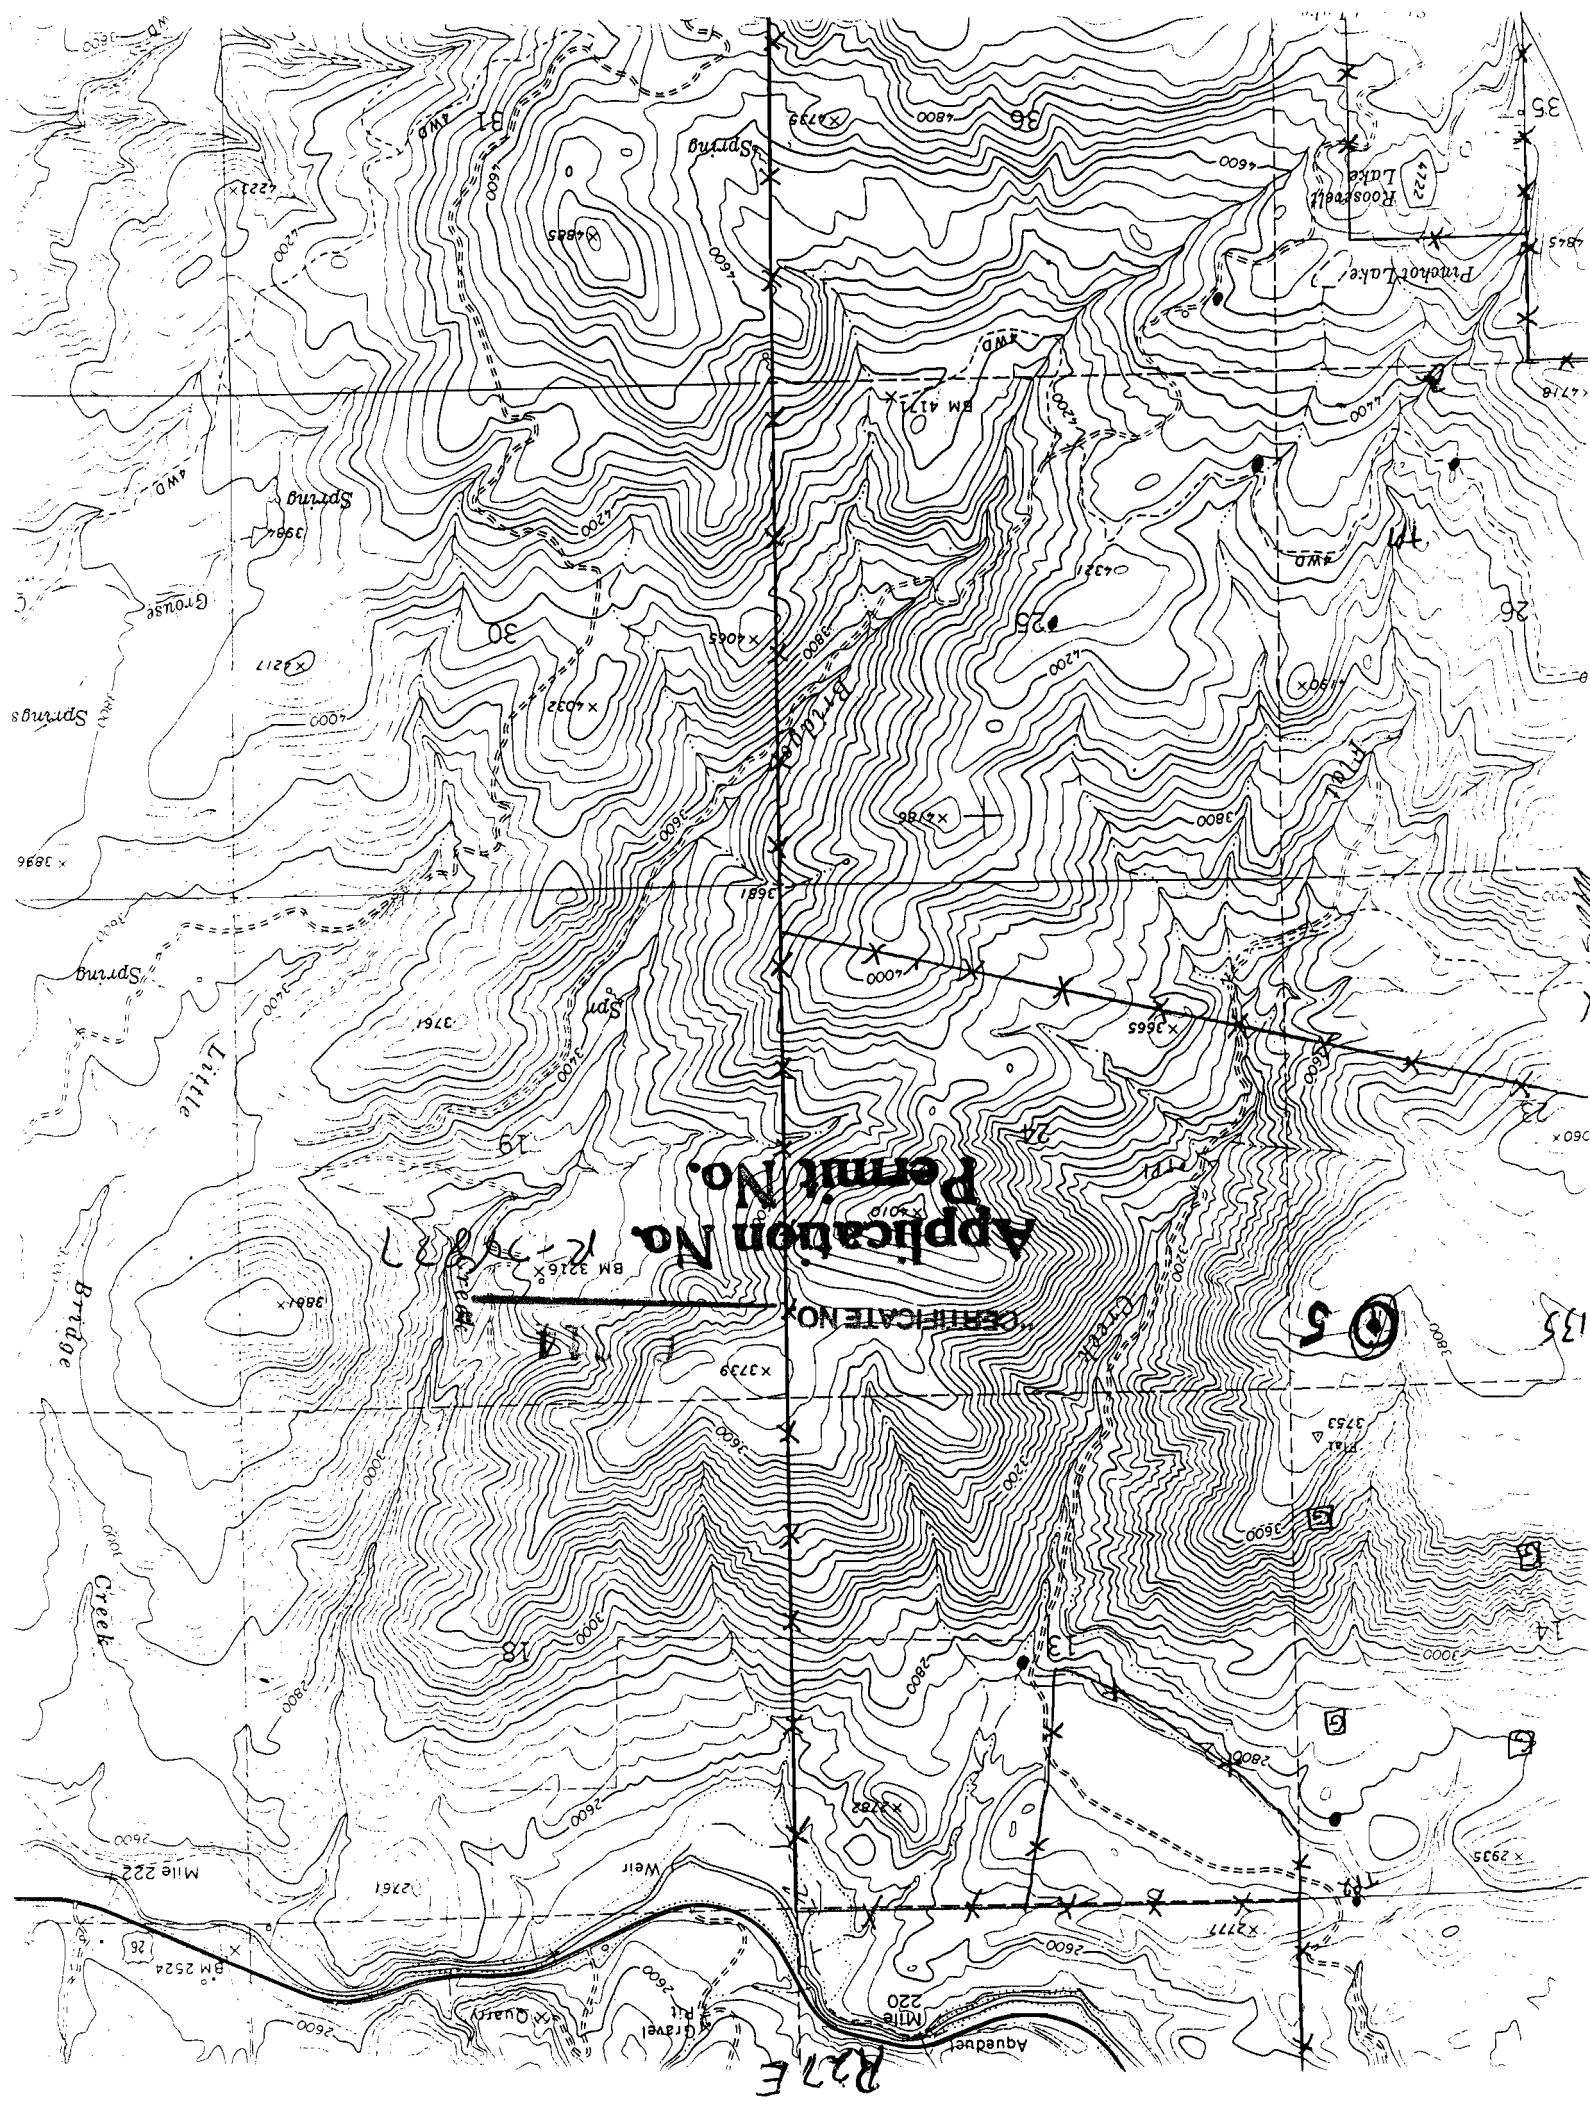


Application No. 12-34827
Permit No.

CERTIFICATE NO.

5

R27E

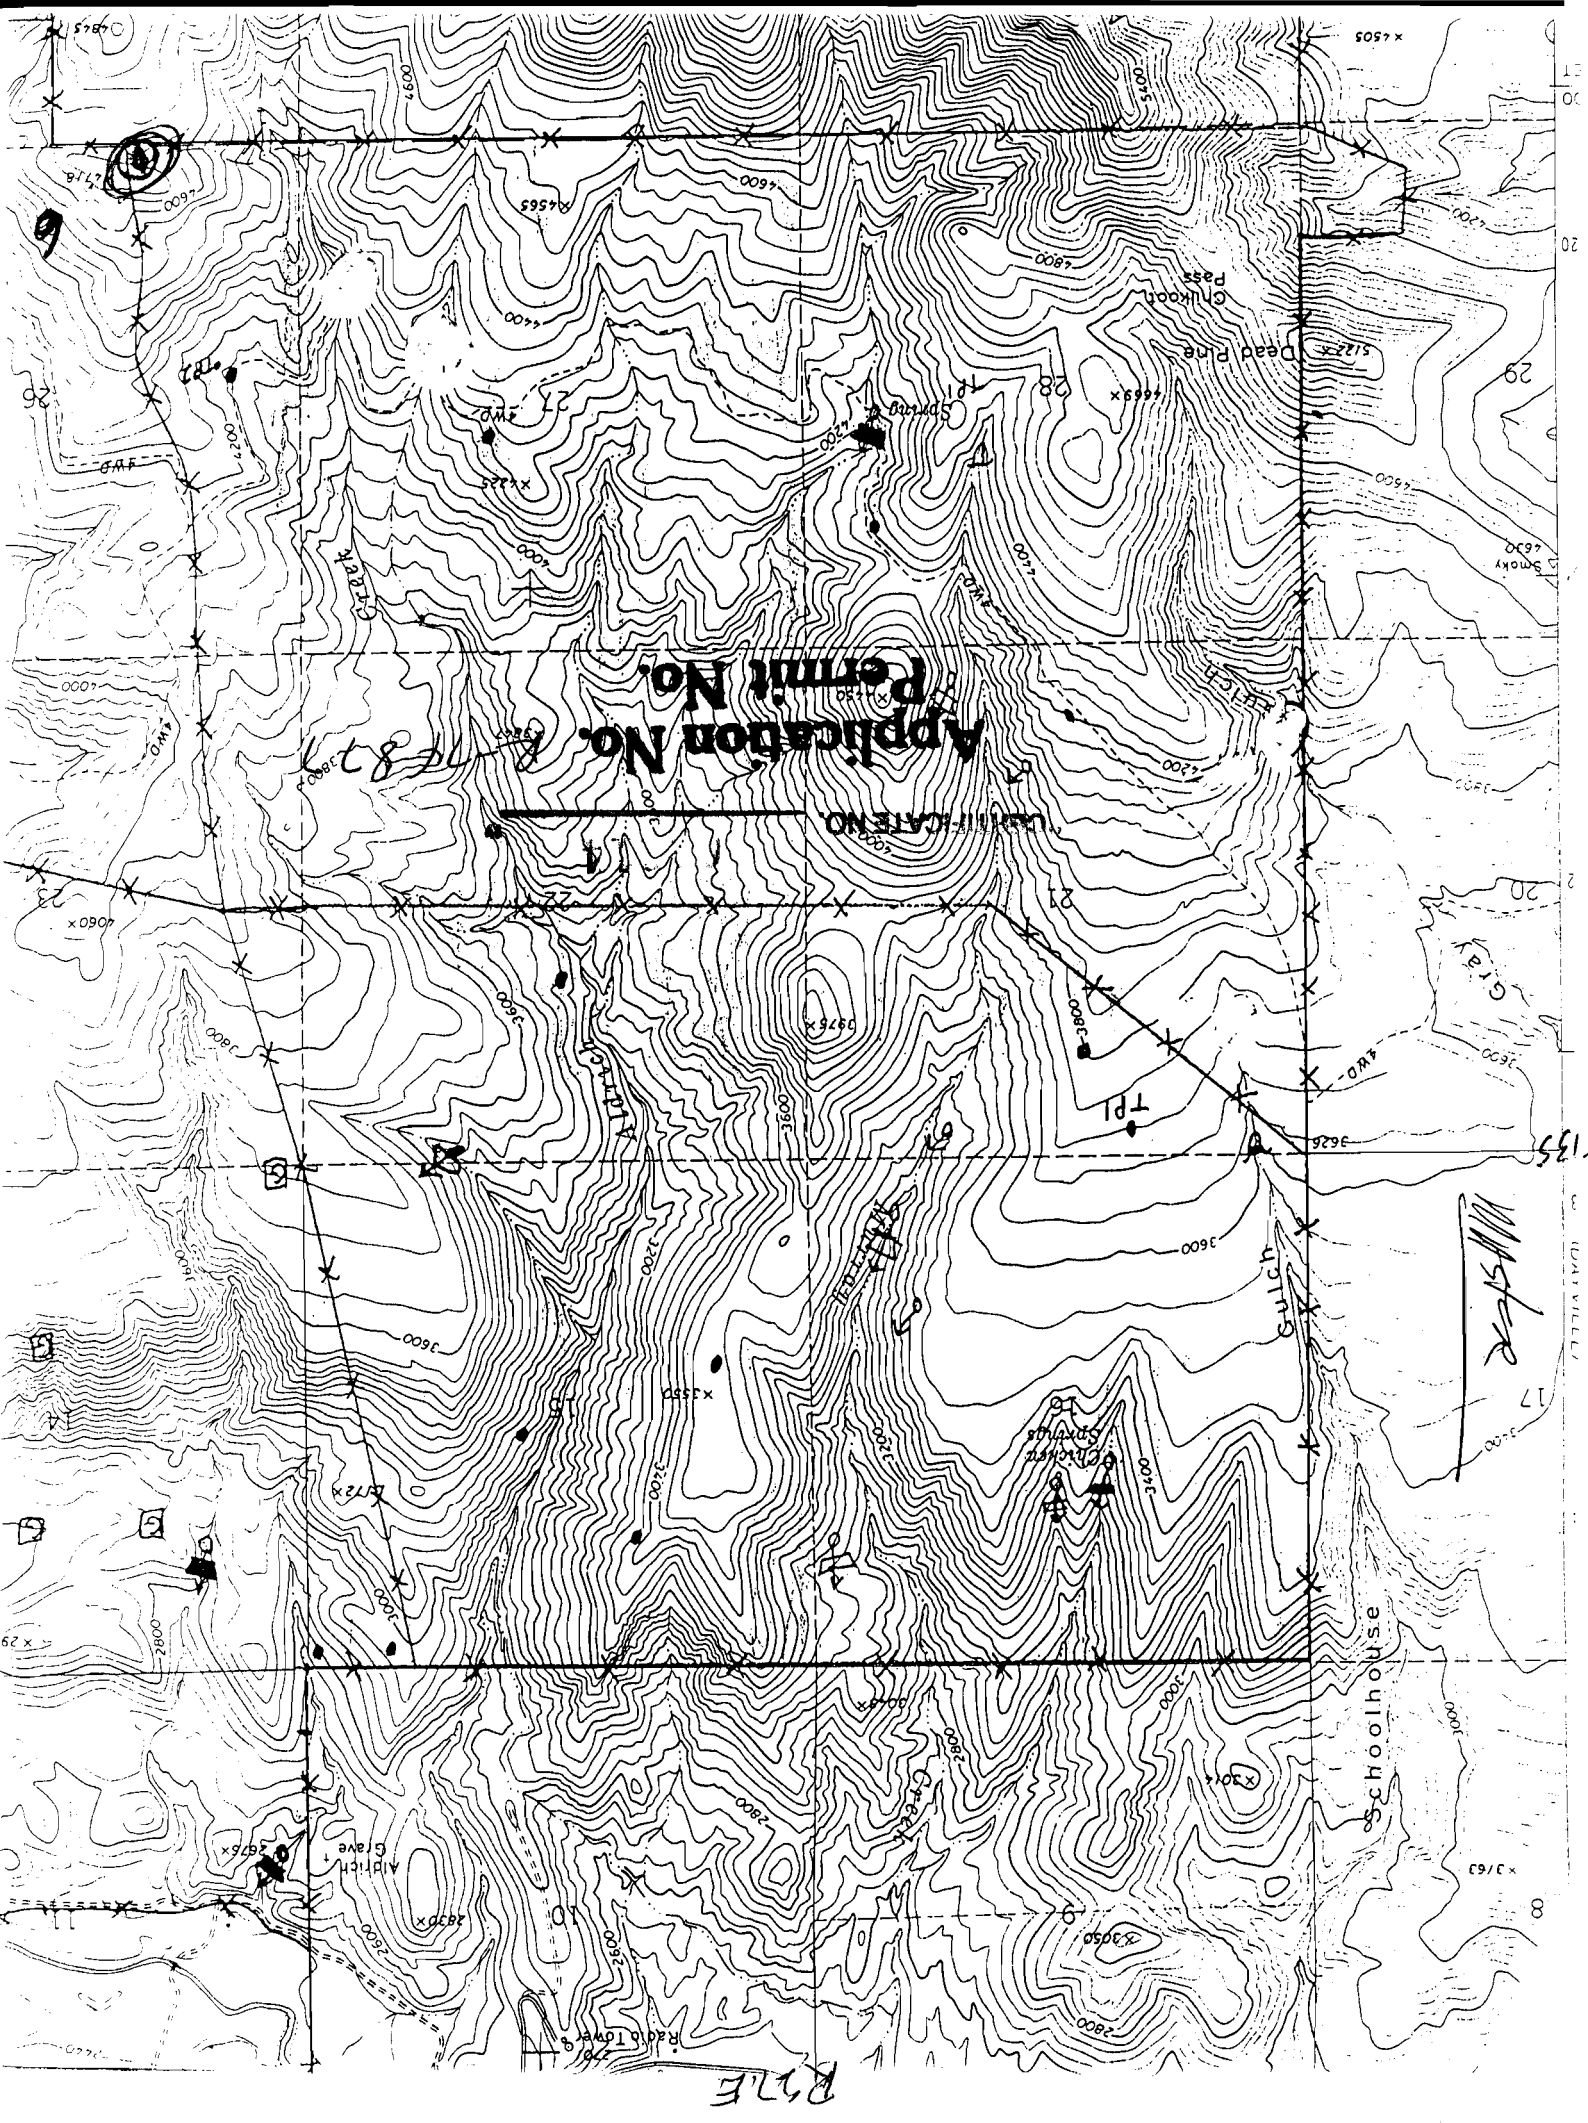

Application No. 17827

Master

R27E

No Final Proof Map available

No Permit Map available