


UNITED STATES
DEPARTMENT OF THE INTERIOR
GEOLOGICAL SURVEY

R 27 E

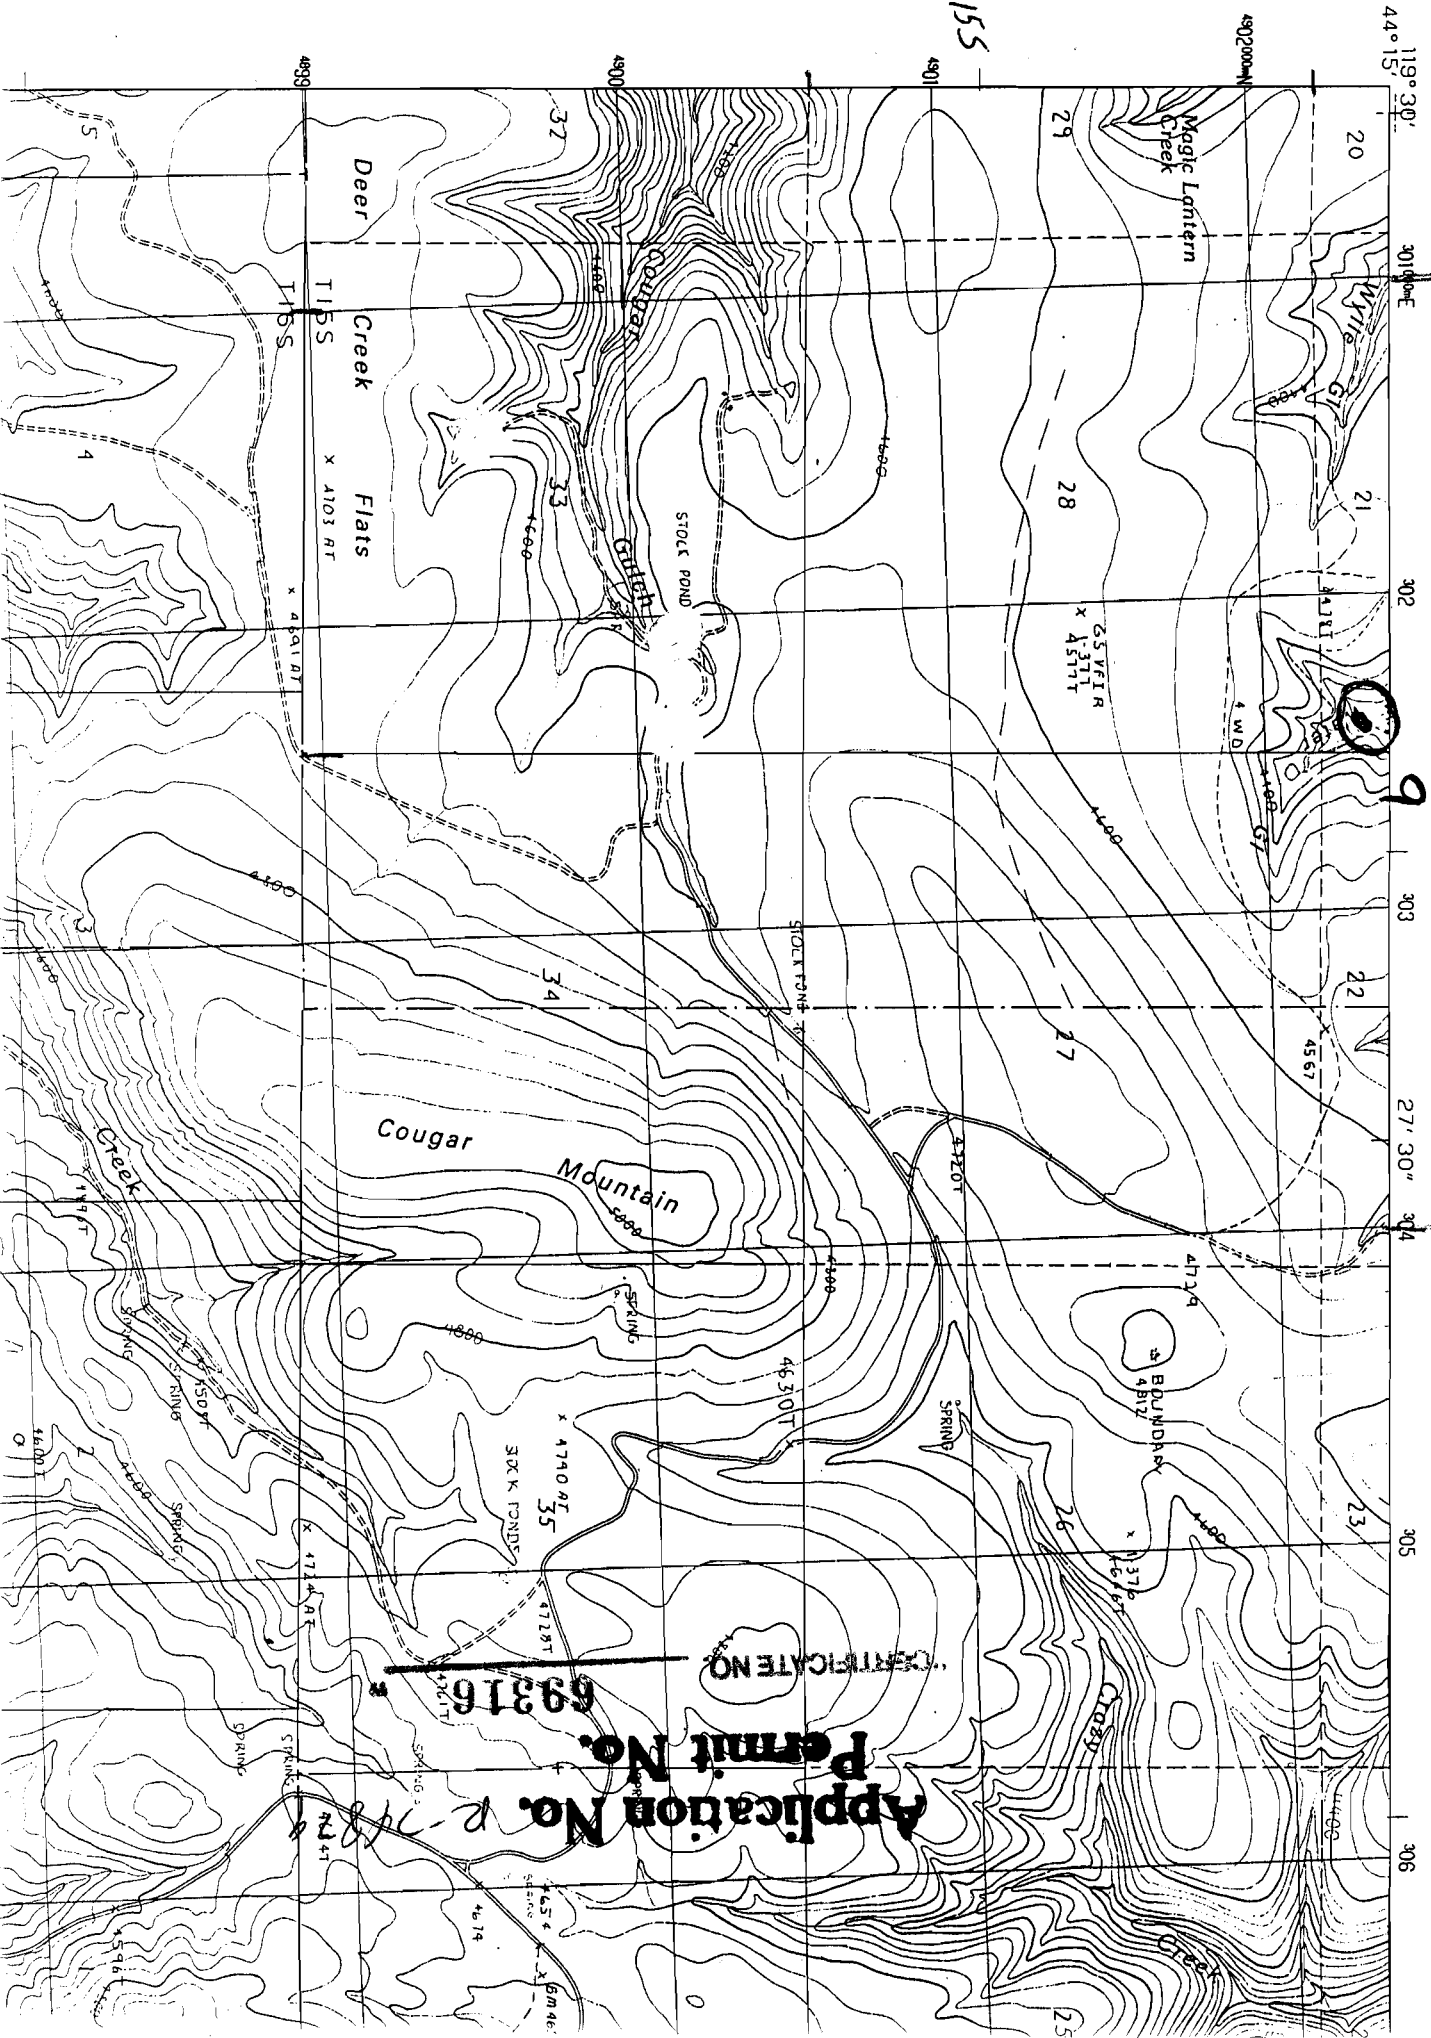



Permit No.

69316

CERTIFICATE NO.

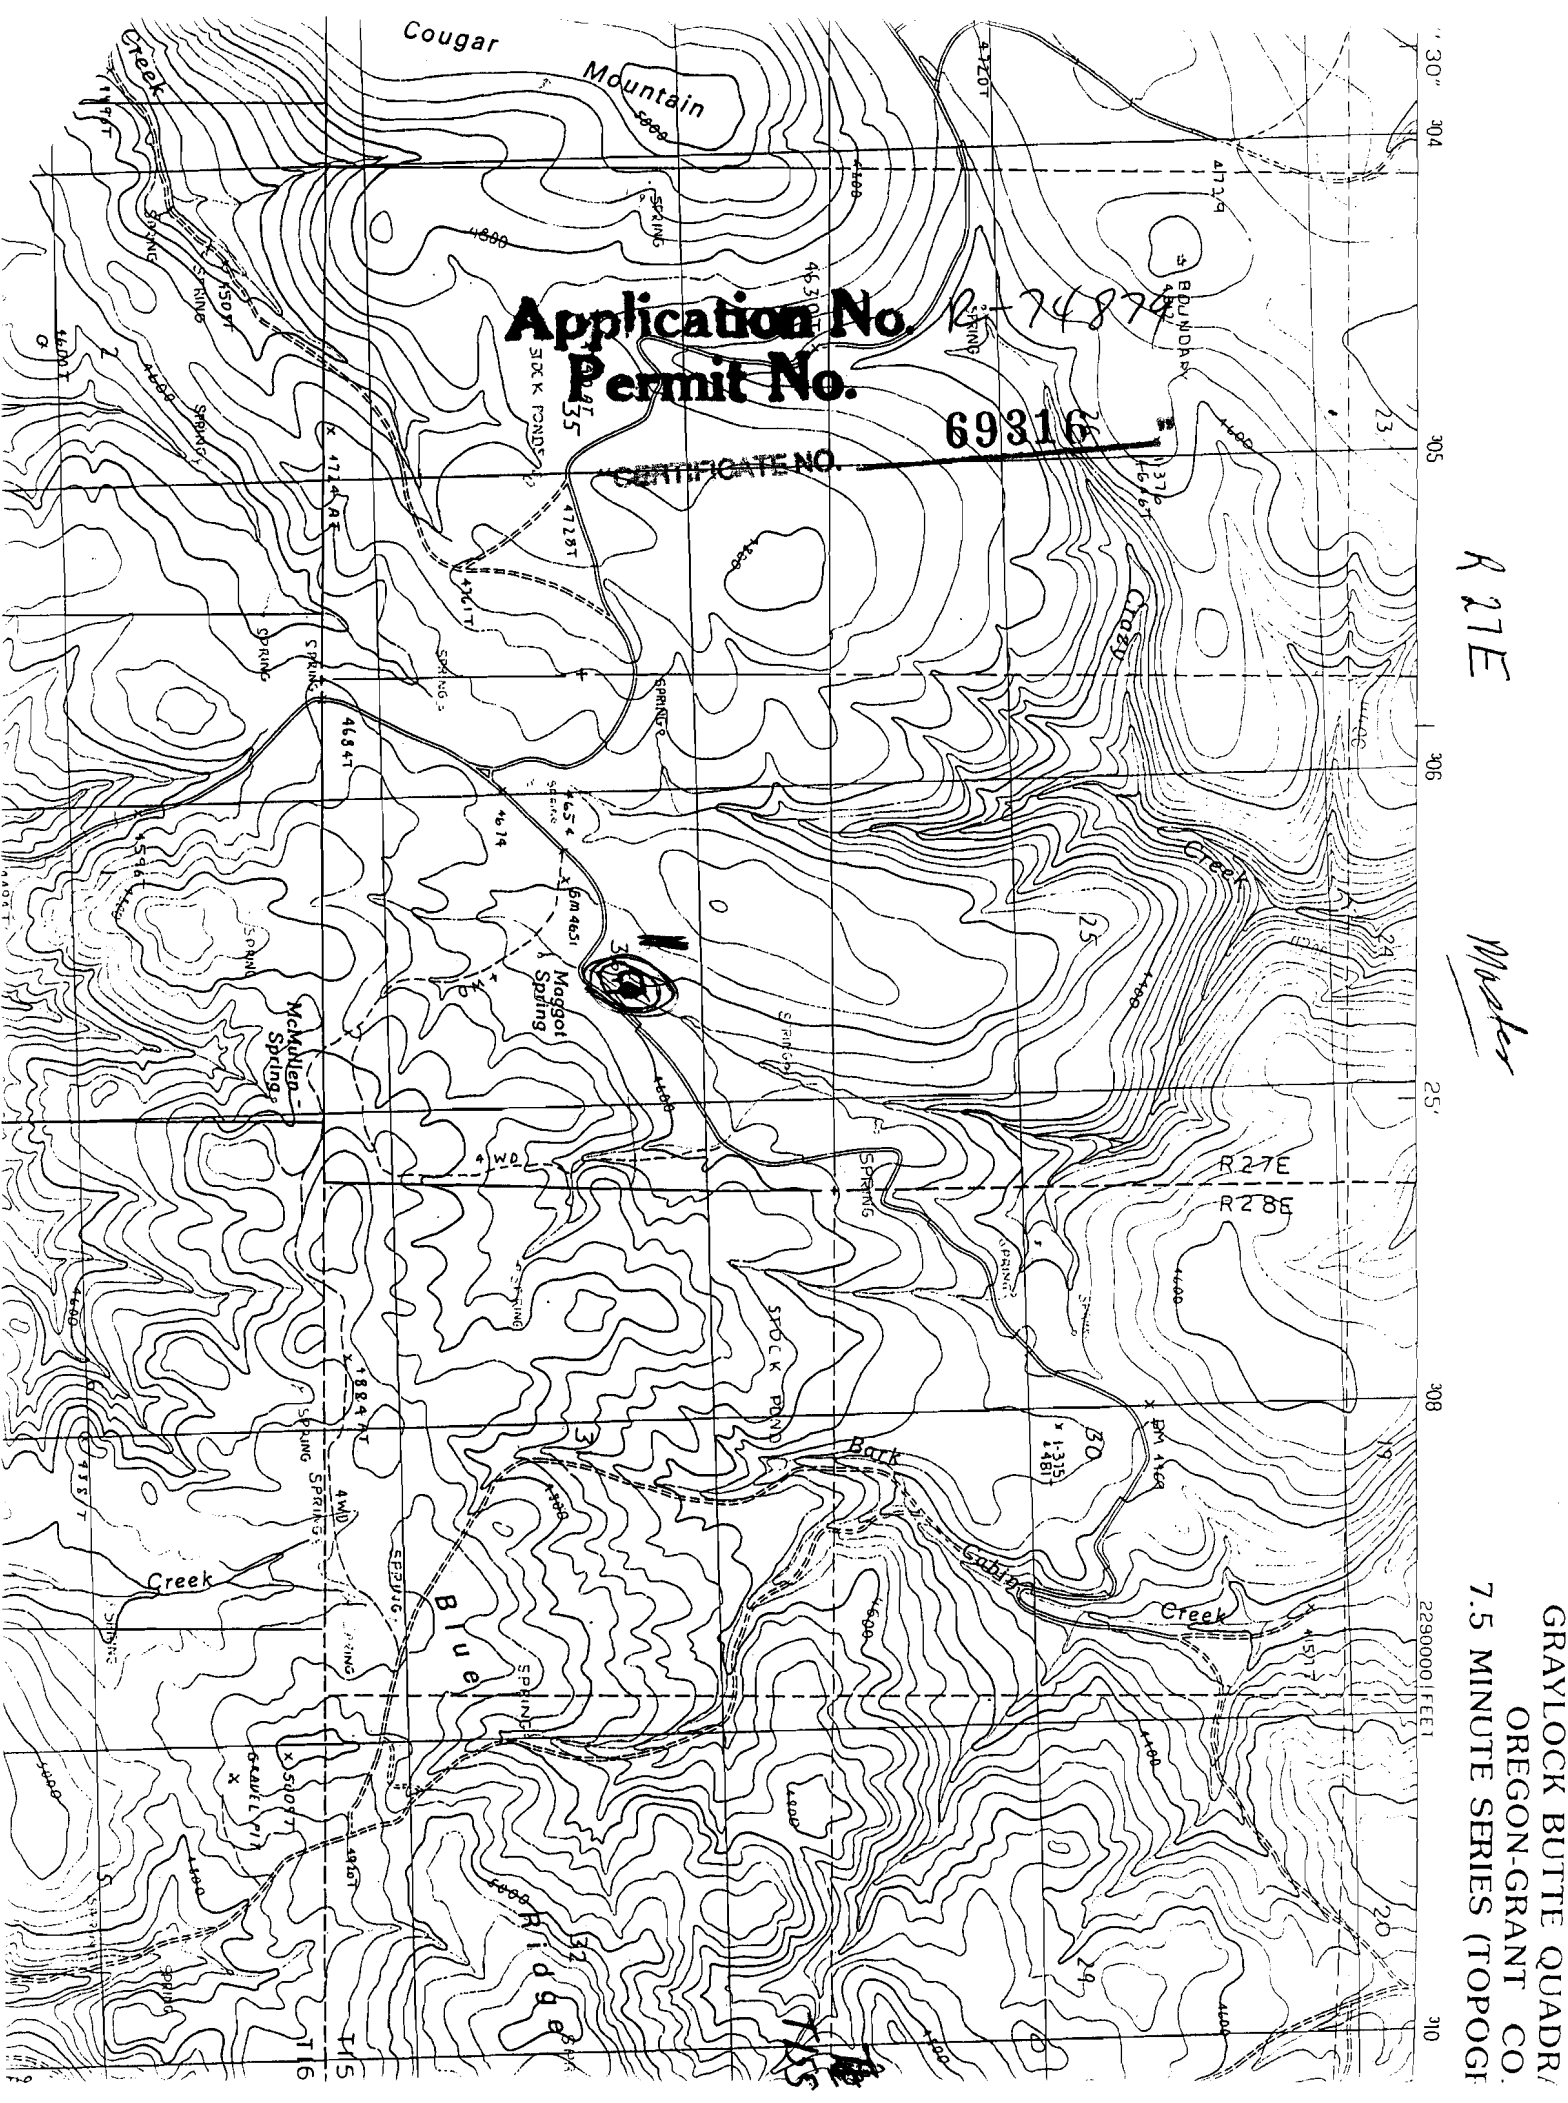

Application No. R-74879
Permit No. 69316

CERTIFICATE NO.

R 27E

Master

R 27E
R 28E

GRAYLOCK BUTTE QUADRANGLE
OREGON-GRANT CO.
7.5 MINUTE SERIES (TOPOG)

No Final Proof available

No Permit Map available