


13 31
& INDEX
CANYON CITY
JOHN DAY

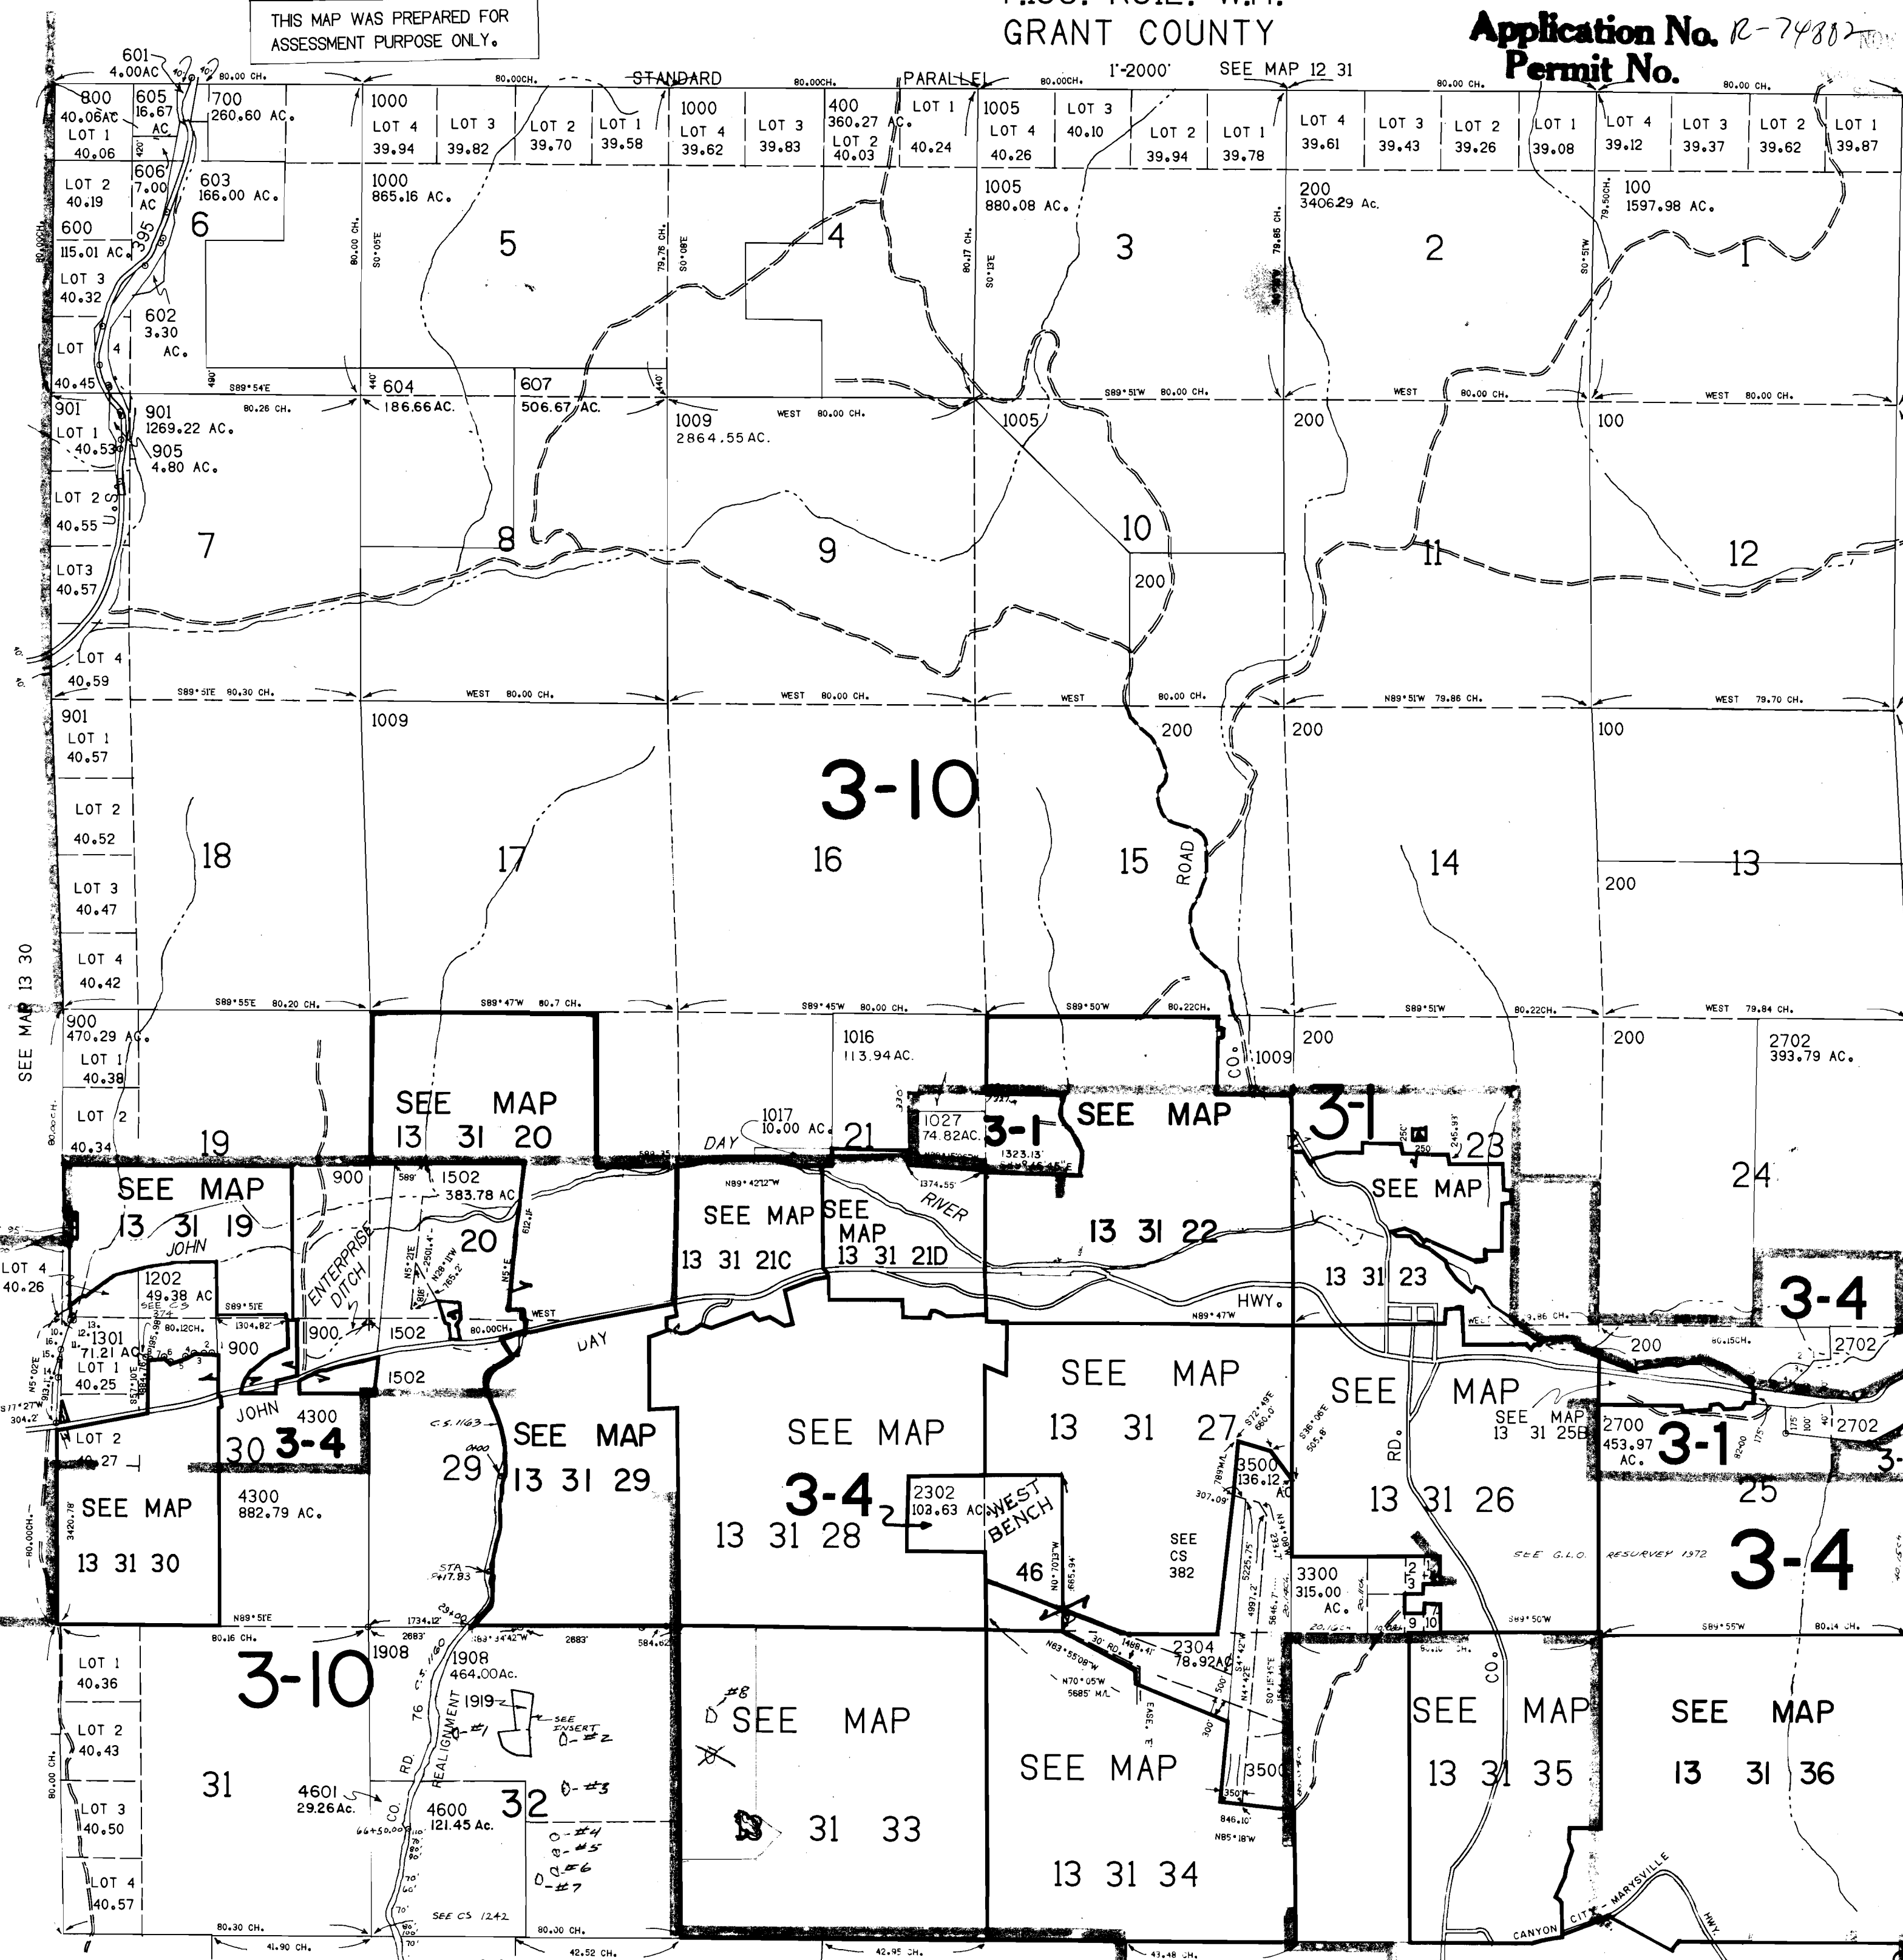

69318

Note Highlighted SEE
Ponds # 1 through E

SEE MAP 14 31

No Final Proof Map available

No Permit Map available