


THIS MAP WAS PREPARED FOR
ASSESSMENT PURPOSE ONLY.

SECTION 2 T.23S. R.4 W. W.M.
DOUGLAS COUNTY

1" = 400'

23 4 2

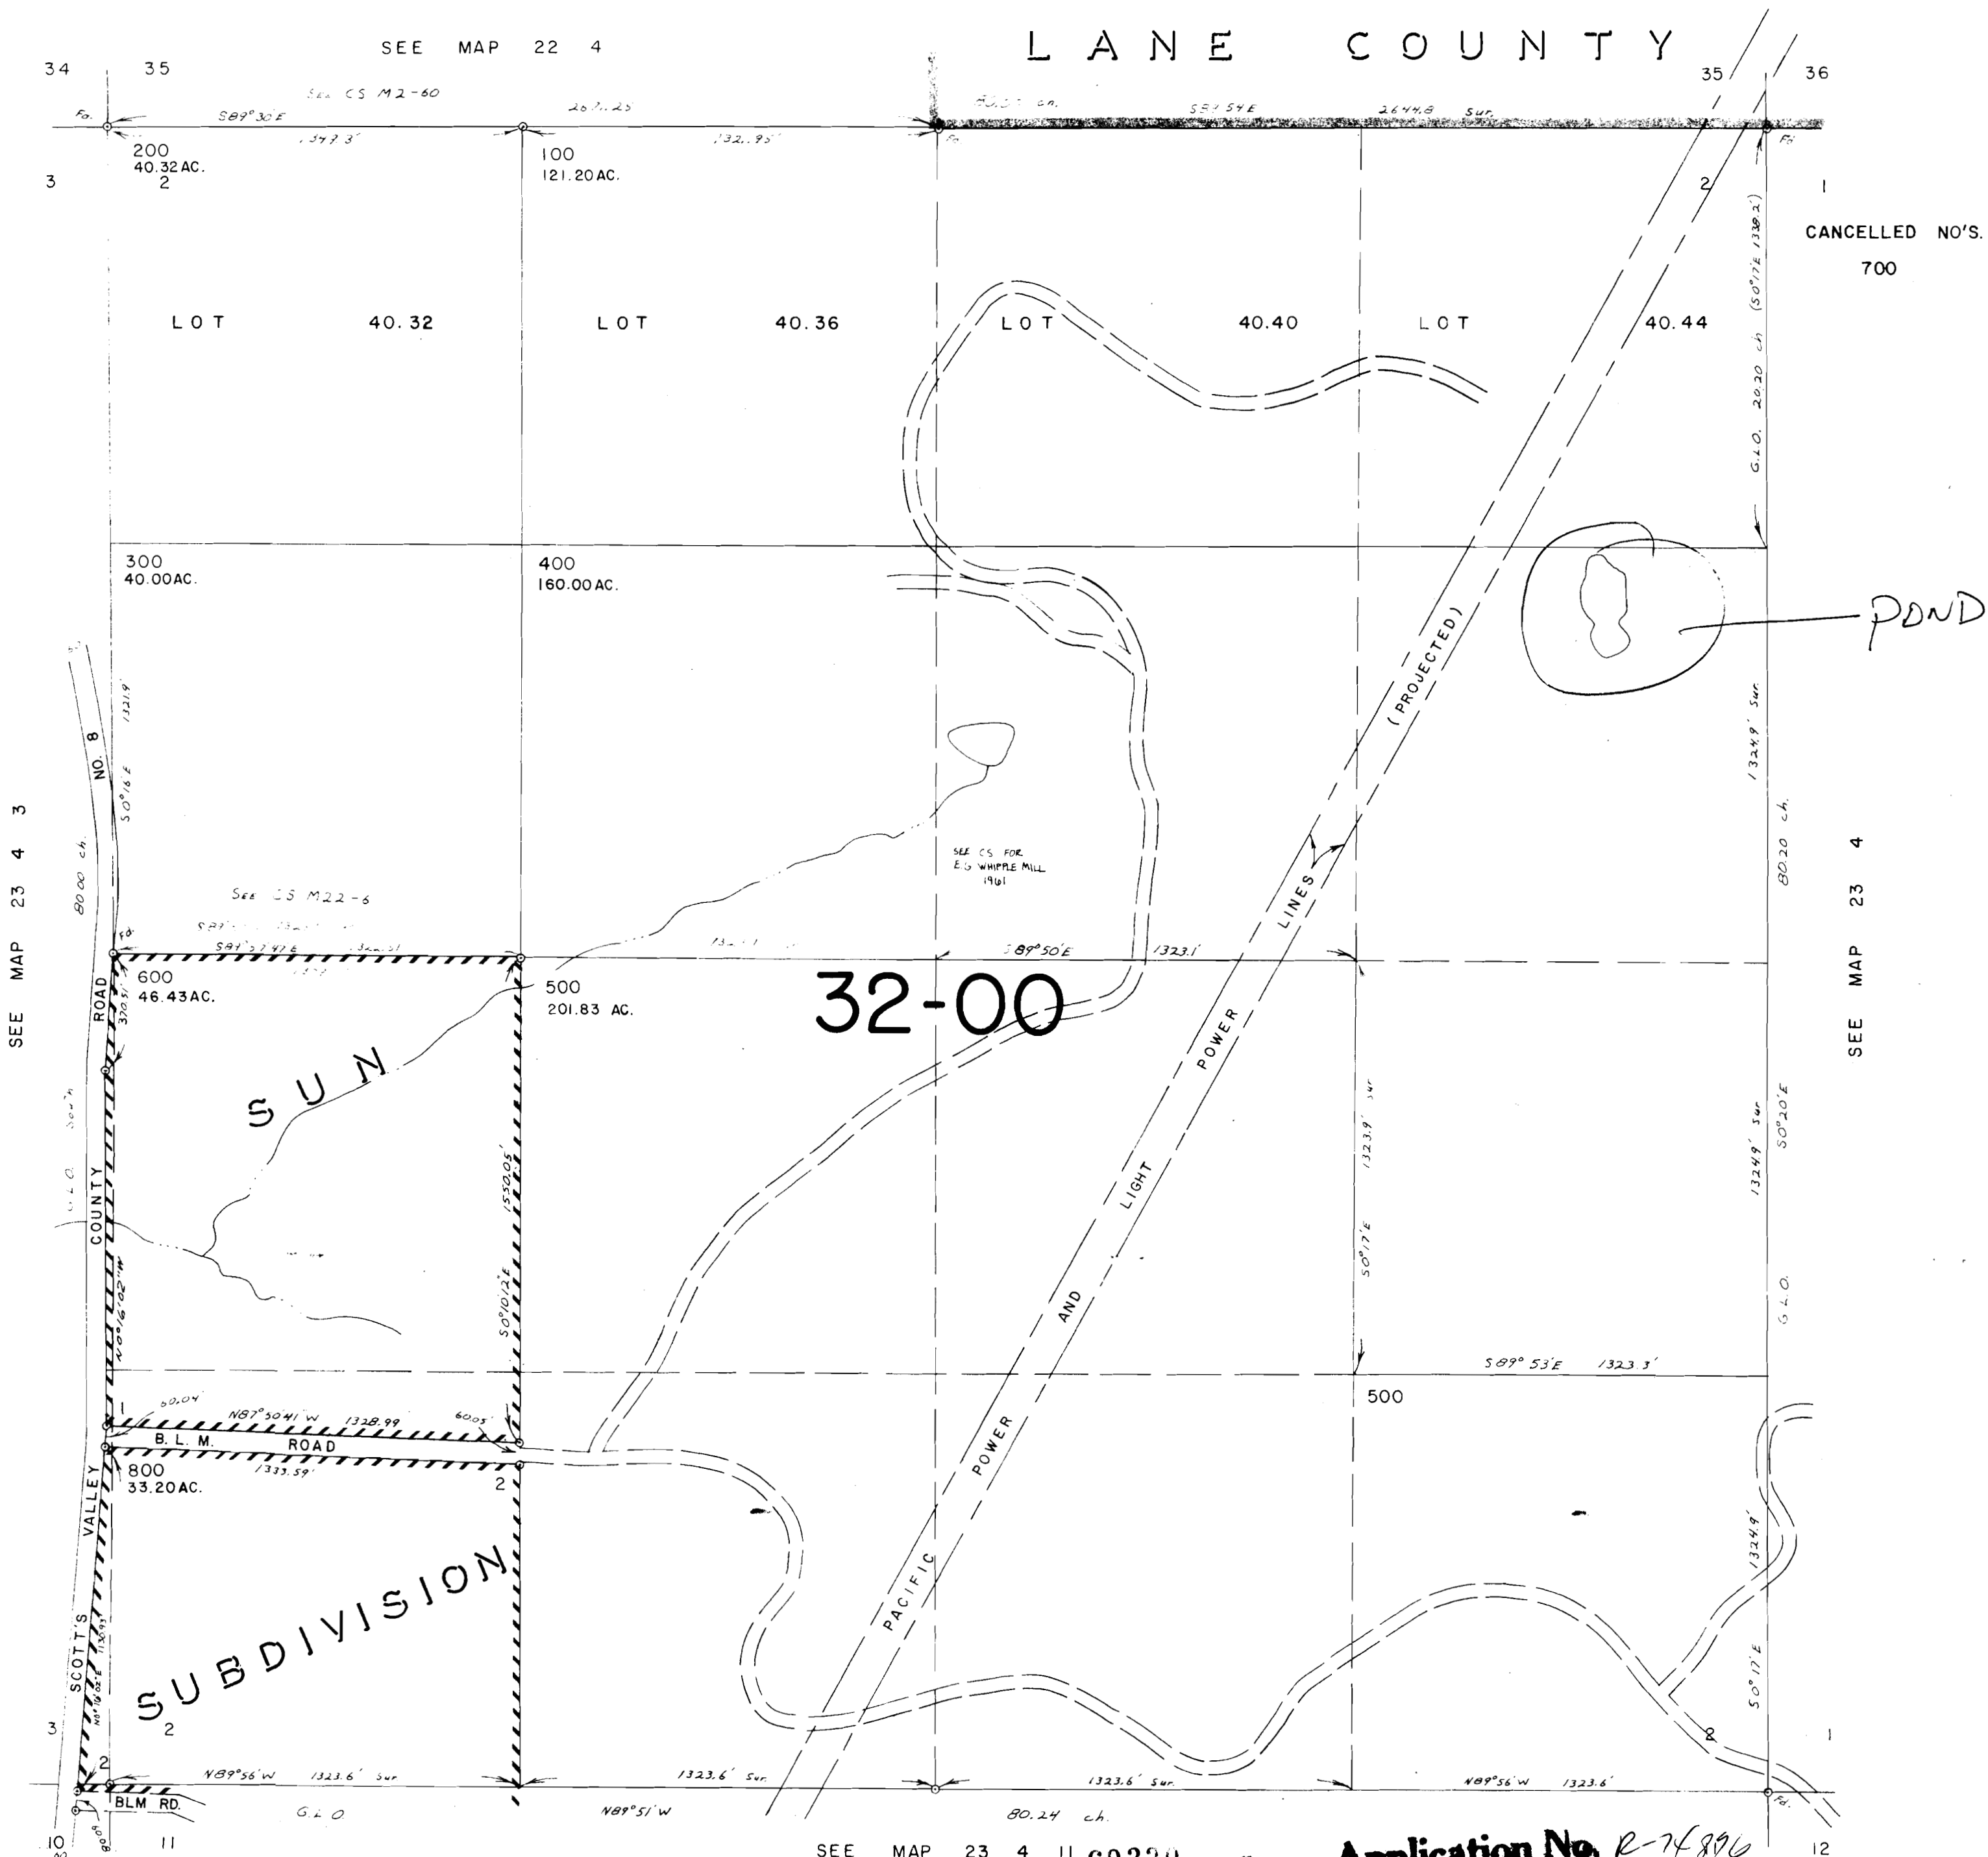

No Final Proof Map available

No Permit Map available