


SECTION 18 T.41S. R.21E. W.M.
LAKE COUNTY
1"=400'

41 21 18

SCALE 1:9600

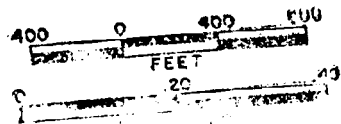


SEE MAP 41 21

7 8


CANCELLED NO'S
400

SEE MAP 41 21

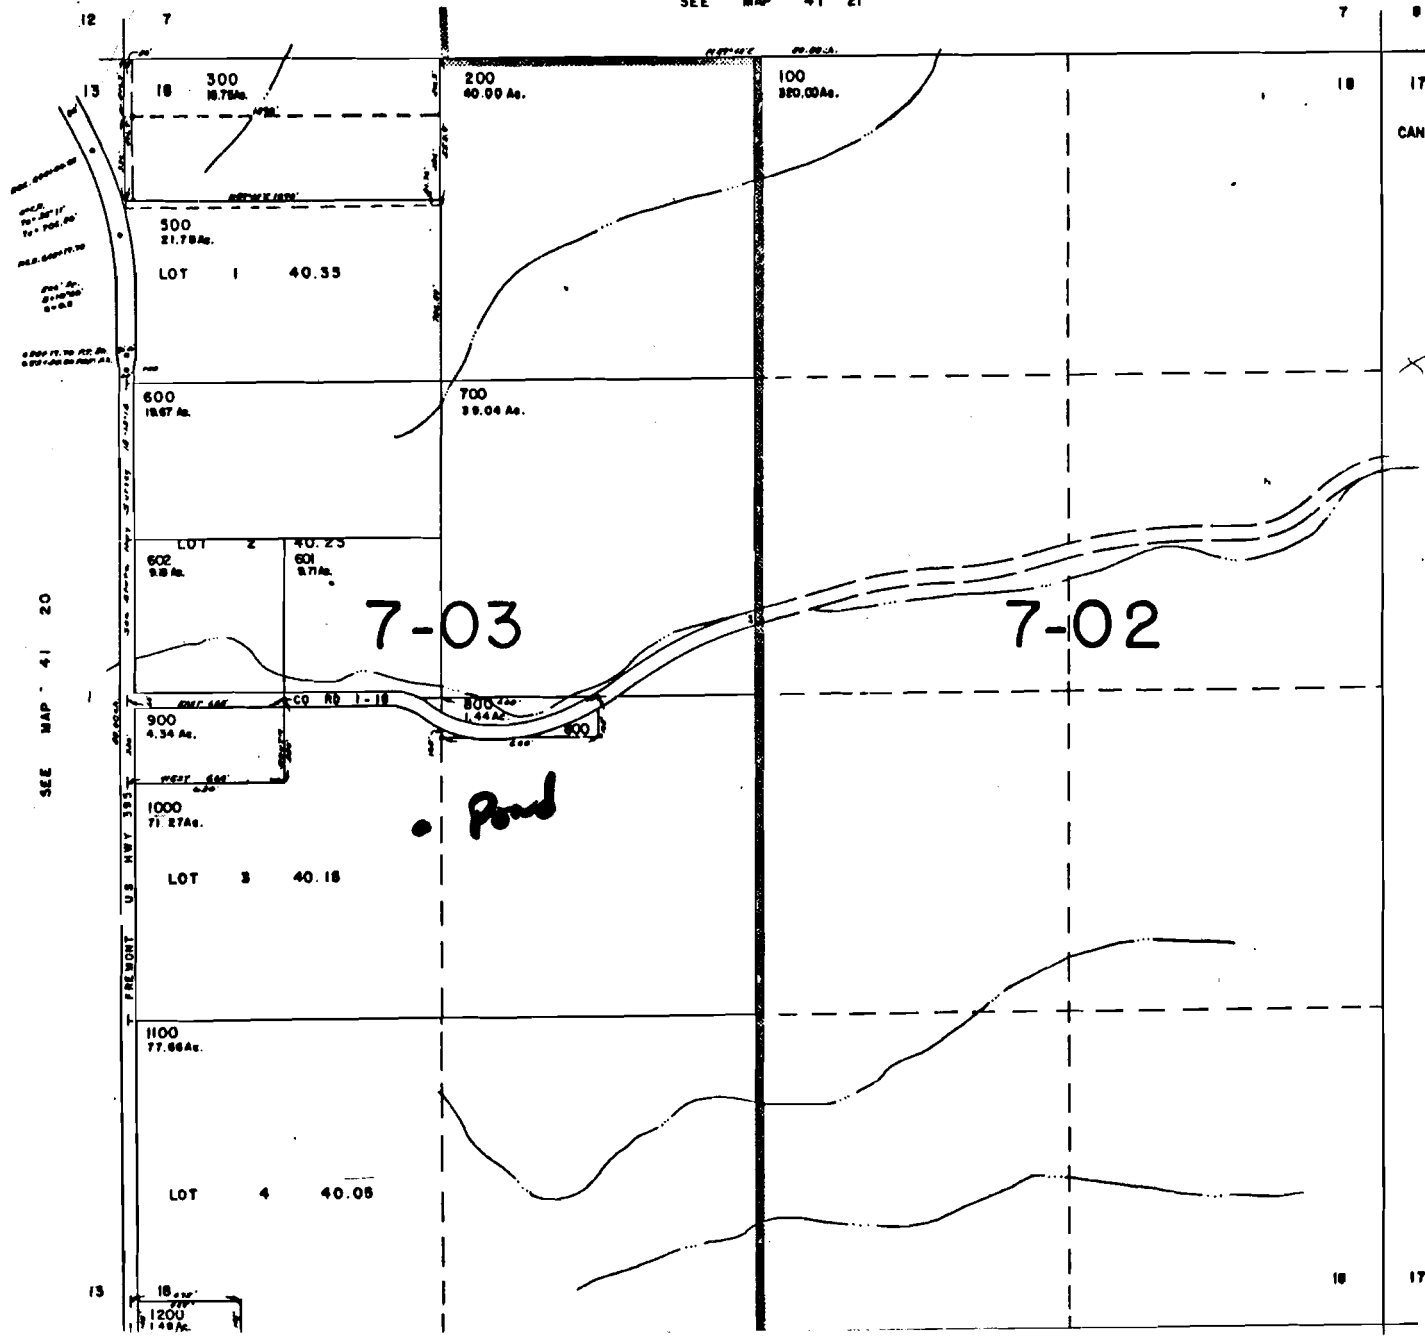

Application No. 8-74897
Permit No.

CERTIFICATE NO. 69331

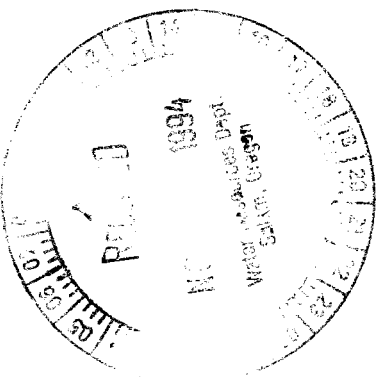

No Final Proof Map available

No Permit Map available