

YARNEY CO.


& INDE.

25 34

SEE MAP 24 34

0' 2000' 4000'  
FEET

Application No. 74901  
Permit No. 69324

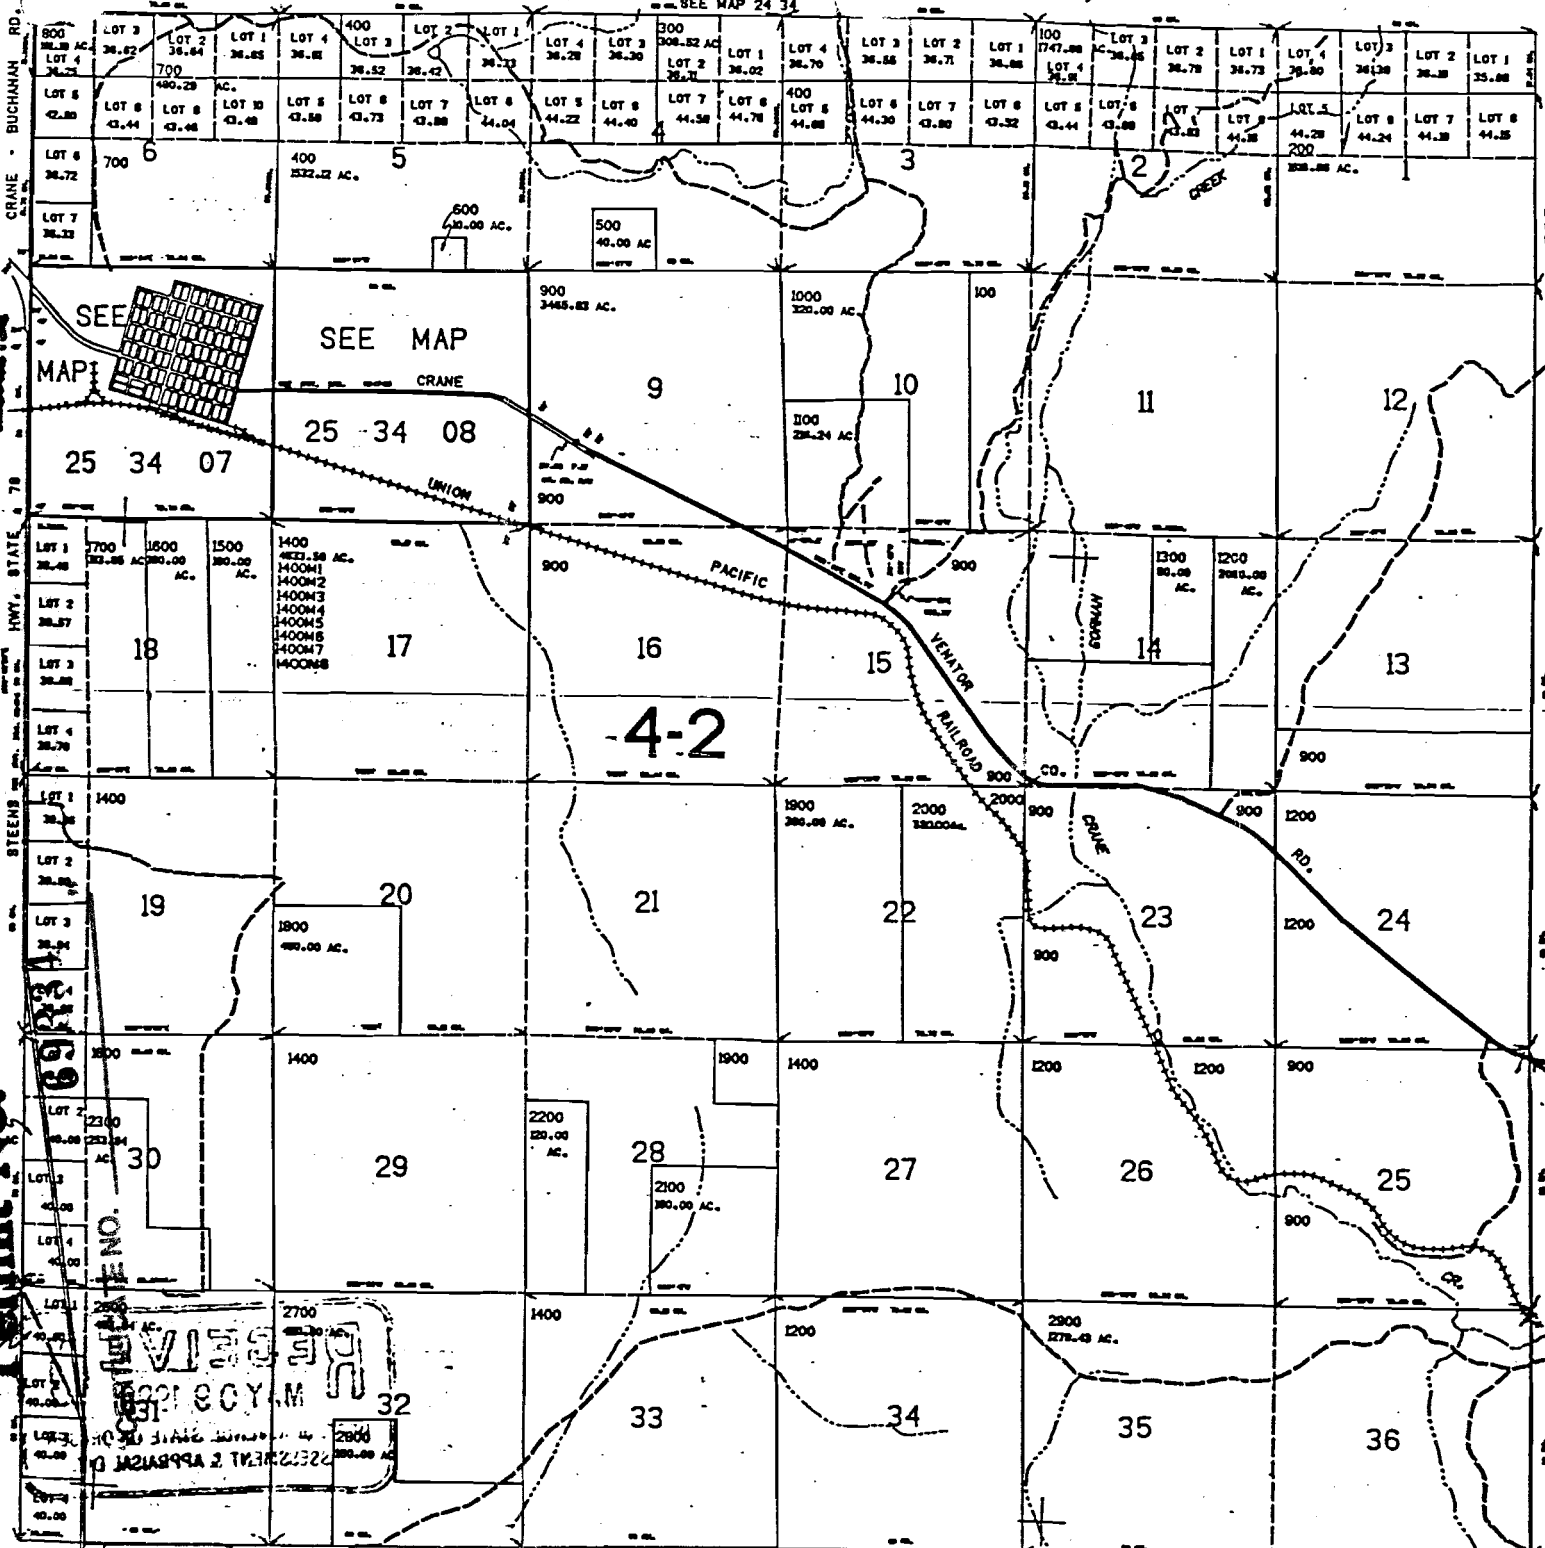


SEE MAP 25 34

640.000

SEE MAP 28 38

25 34  
& INDEX

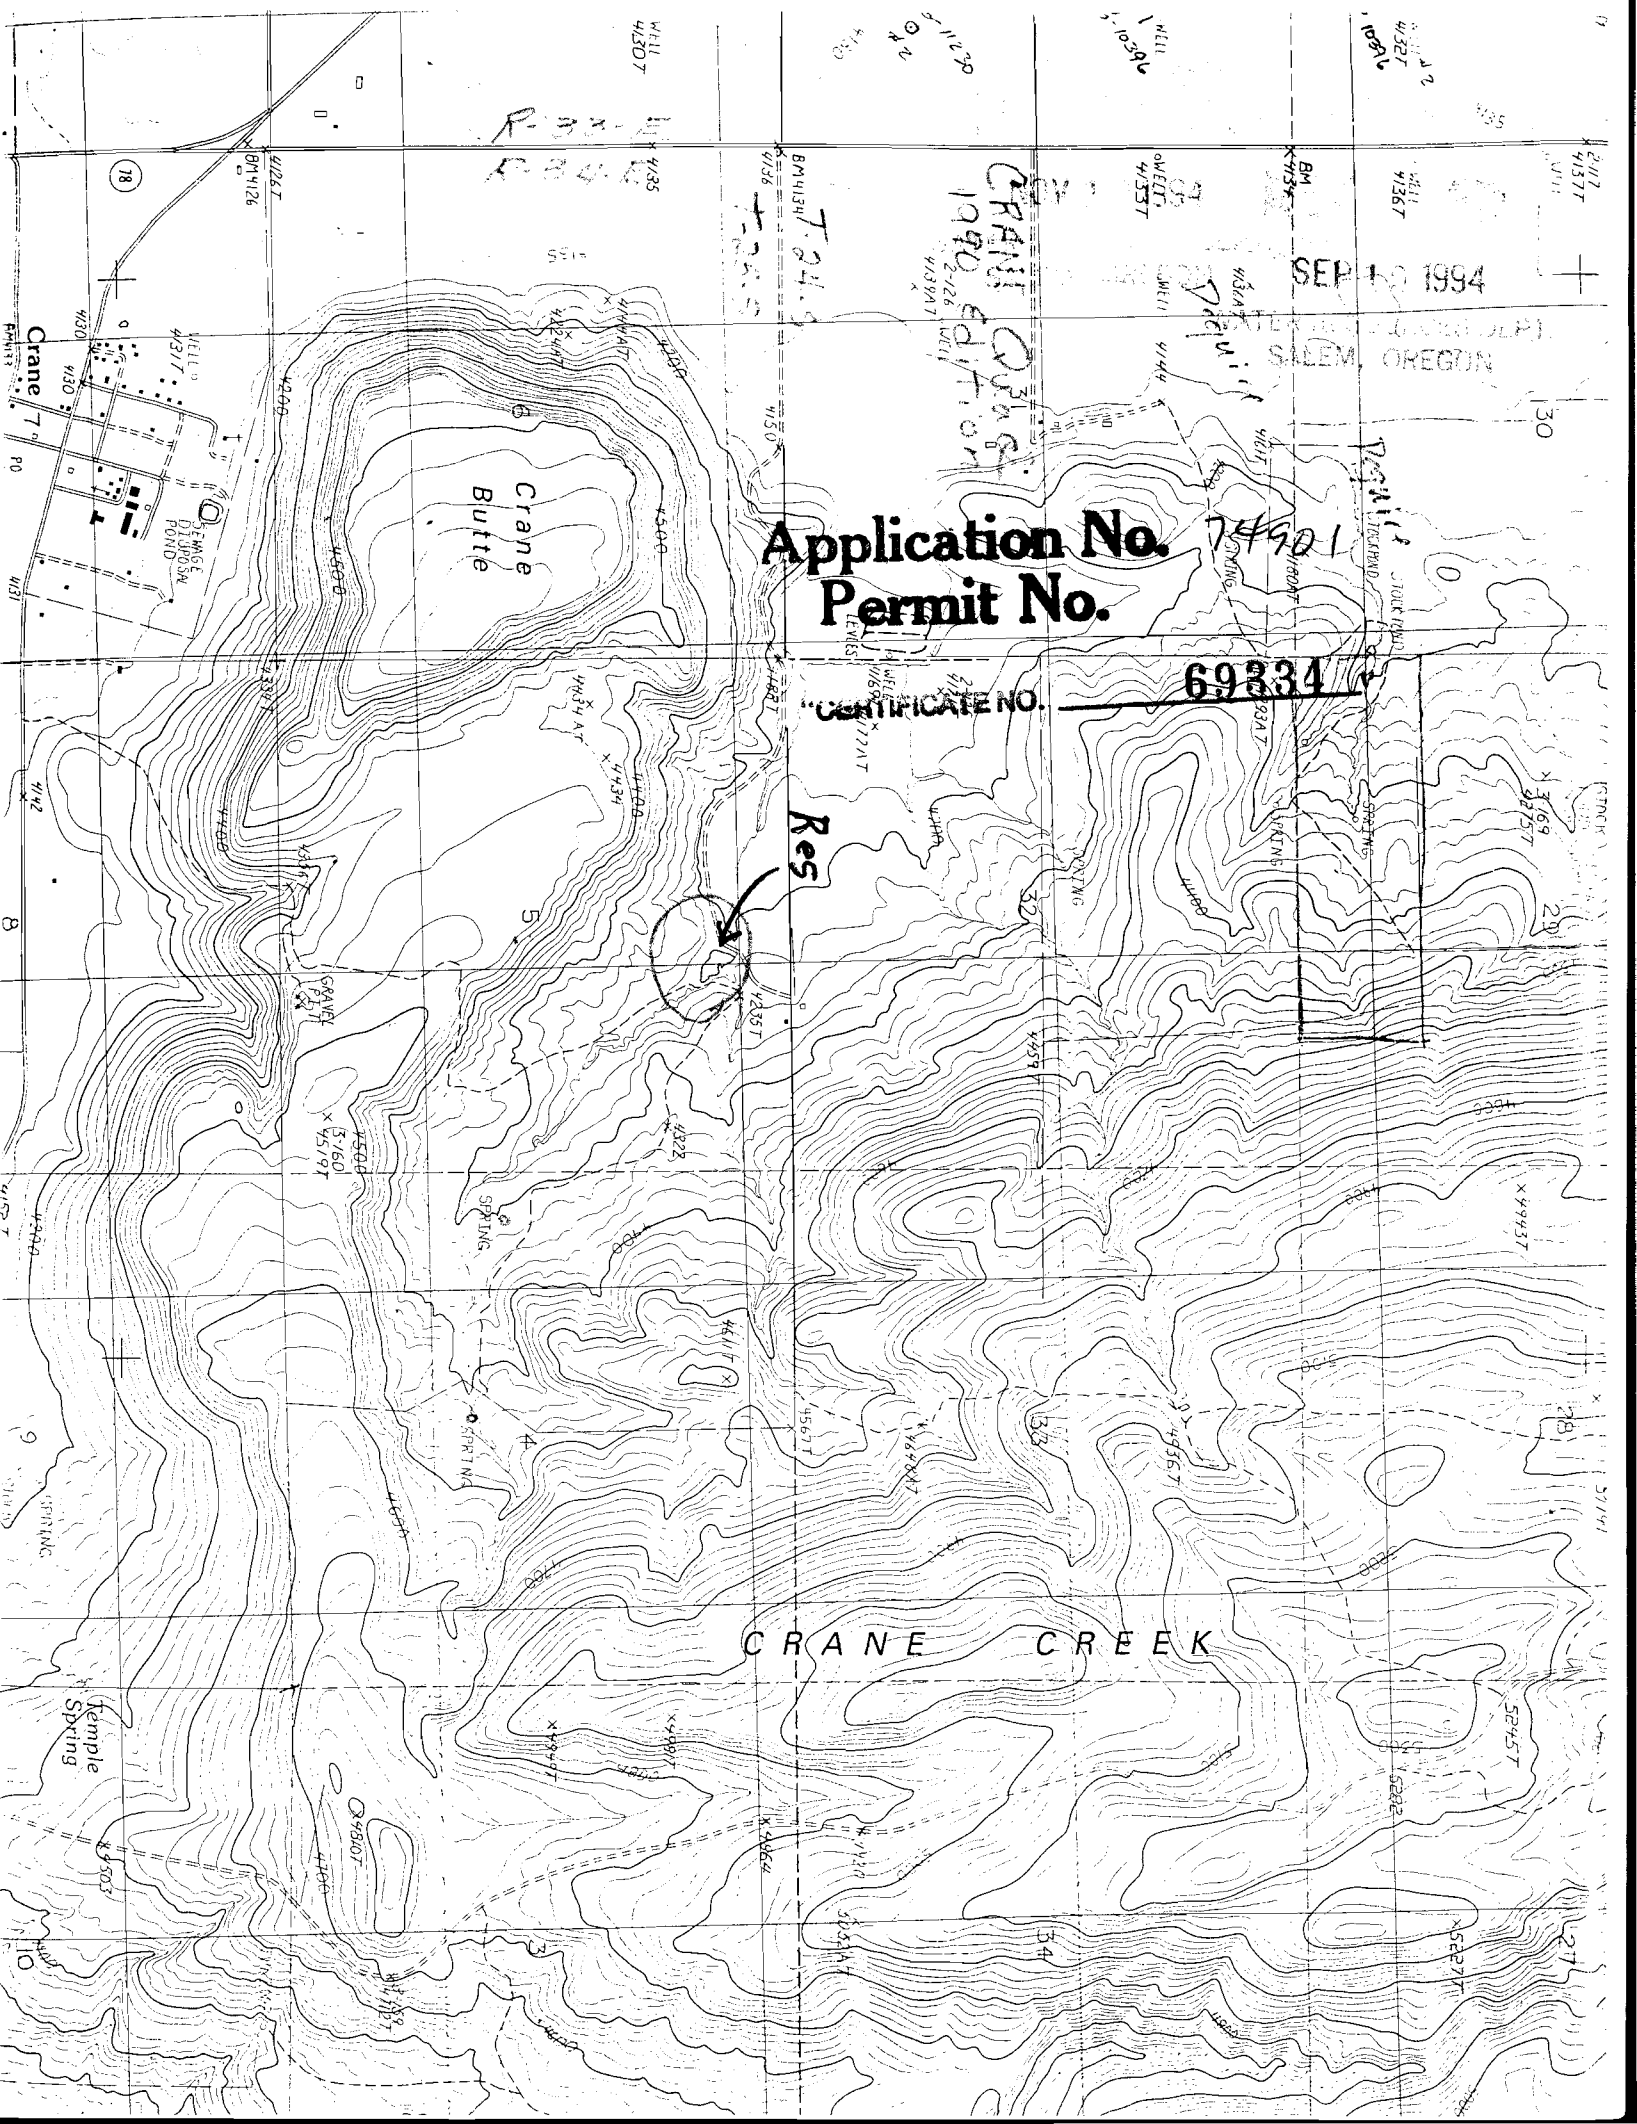

CRANE CREEK  
1990 EDITION

SEP 10 1994

SALEM OREGON

Application No. 74901  
Permit No.


Res

CRANE CREEK

Crane Butte

Crane 7  
SEWAGE DISPOSAL POND

Temple Springs

No Final Proof Map available

No Permit Map available