



Fidelity National Title Co. of Oregon

NOV 1 1994

Application No. P-749022

The sketch below is made solely for the purpose of assisting in locating said premises and the Company assumes no liability for variations, if any, in dimension and location obtained by actual survey.

Permit No.

69335


LIE 1

TAX Lot # 1100

CERTIFICATE NO.

Description

"The S.E. 1/4 of the S.W. 1/4 of section 1, Township 4 South, Range 1 East, of the Willamette Meridian, in Clackamas County, OREGON, except the North 330 ft thereof."

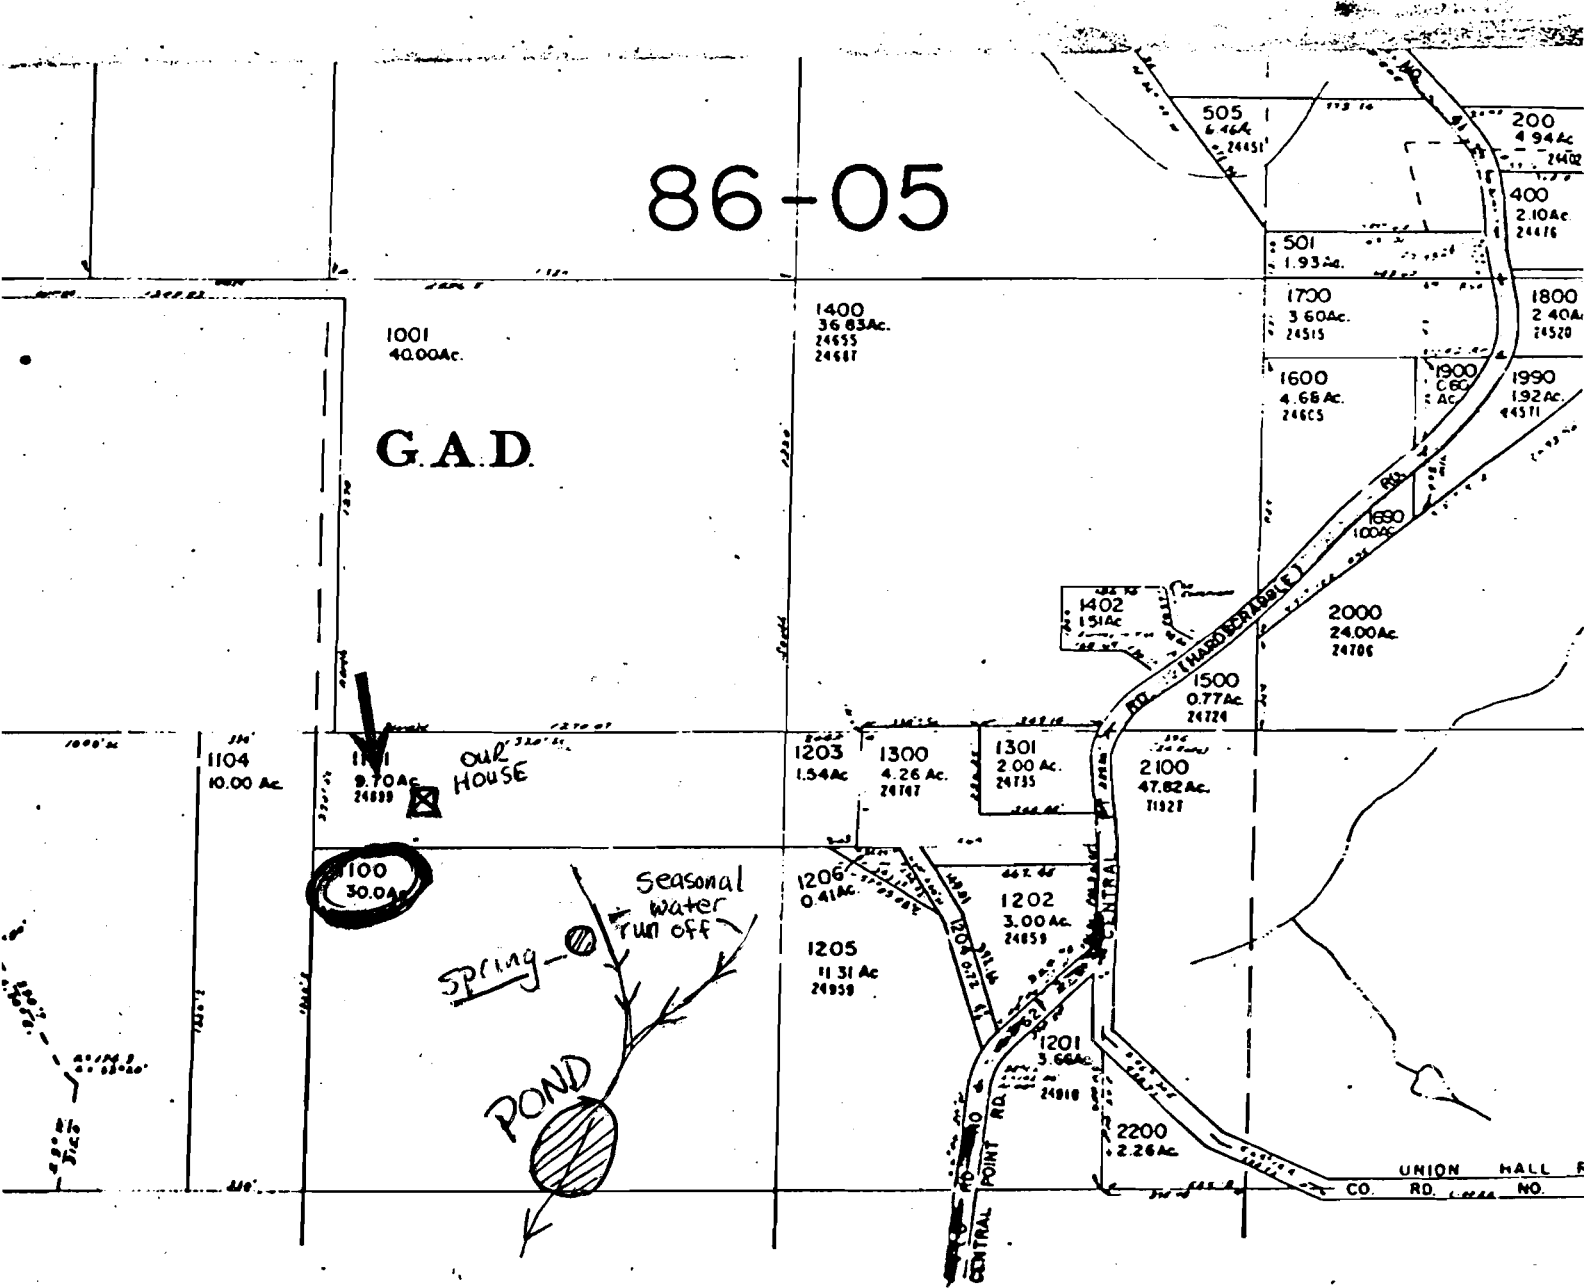

SEE MAP 4 IE 12

~~BMX~~