

IMPORTANT
This Map for Assessment
and Taxation Purposes
ONLY

SEC.28 T6S R6W WM
POLK COUNTY

See Map 6.6.21


101
162.71 AC

Scale 1" = 400'

21-10

Canceled No.

- 102
- 702
- 703
- 200
- 300
- 400
- 401
- 500
- 600
- 800
- 900
- 1000
- 1001
- 1100
- 1200
- 1500
- 1600

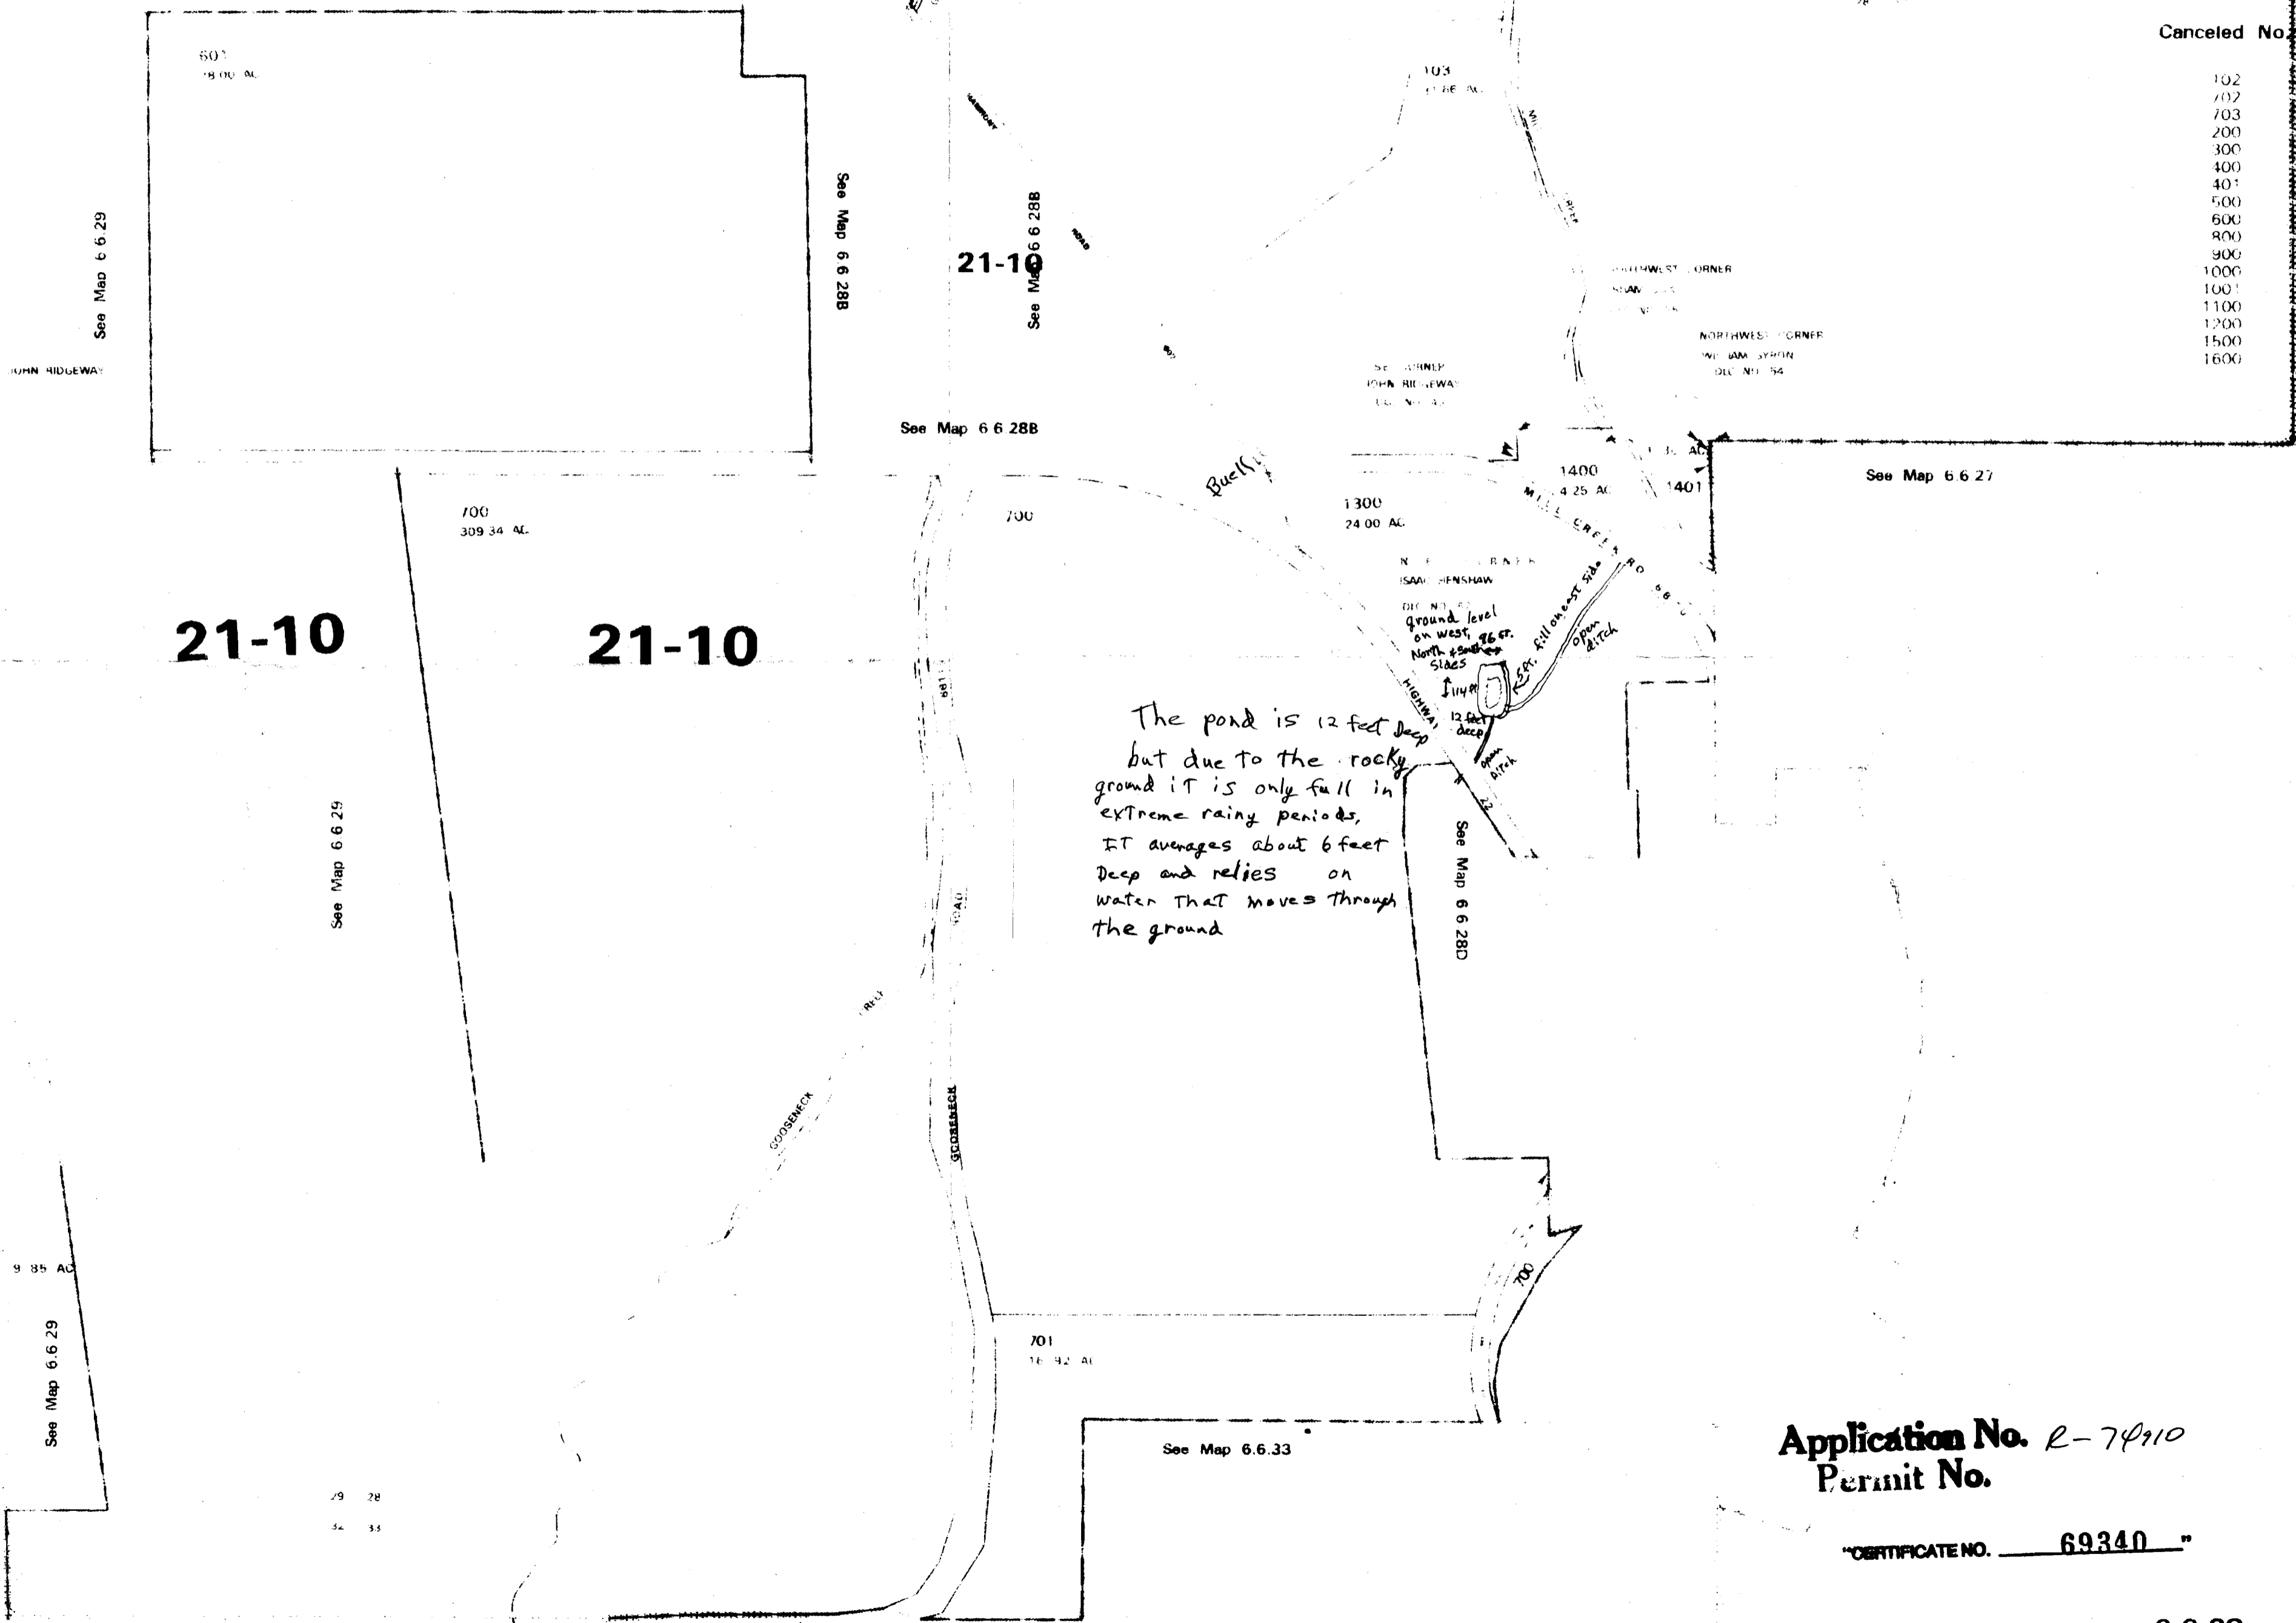

The pond is 12 feet deep
but due to the rocky
ground it is only full in
extreme rainy periods,
It averages about 6 feet
deep and relies on
water that moves through
the ground

Application No. R-7410
Permit No.

"CERTIFICATE NO. 69340"

No Final Proof Map available

No Permit Map available