


Application No. P-74912
Permit No.

T33S

CERTIFICATE NO. 69341

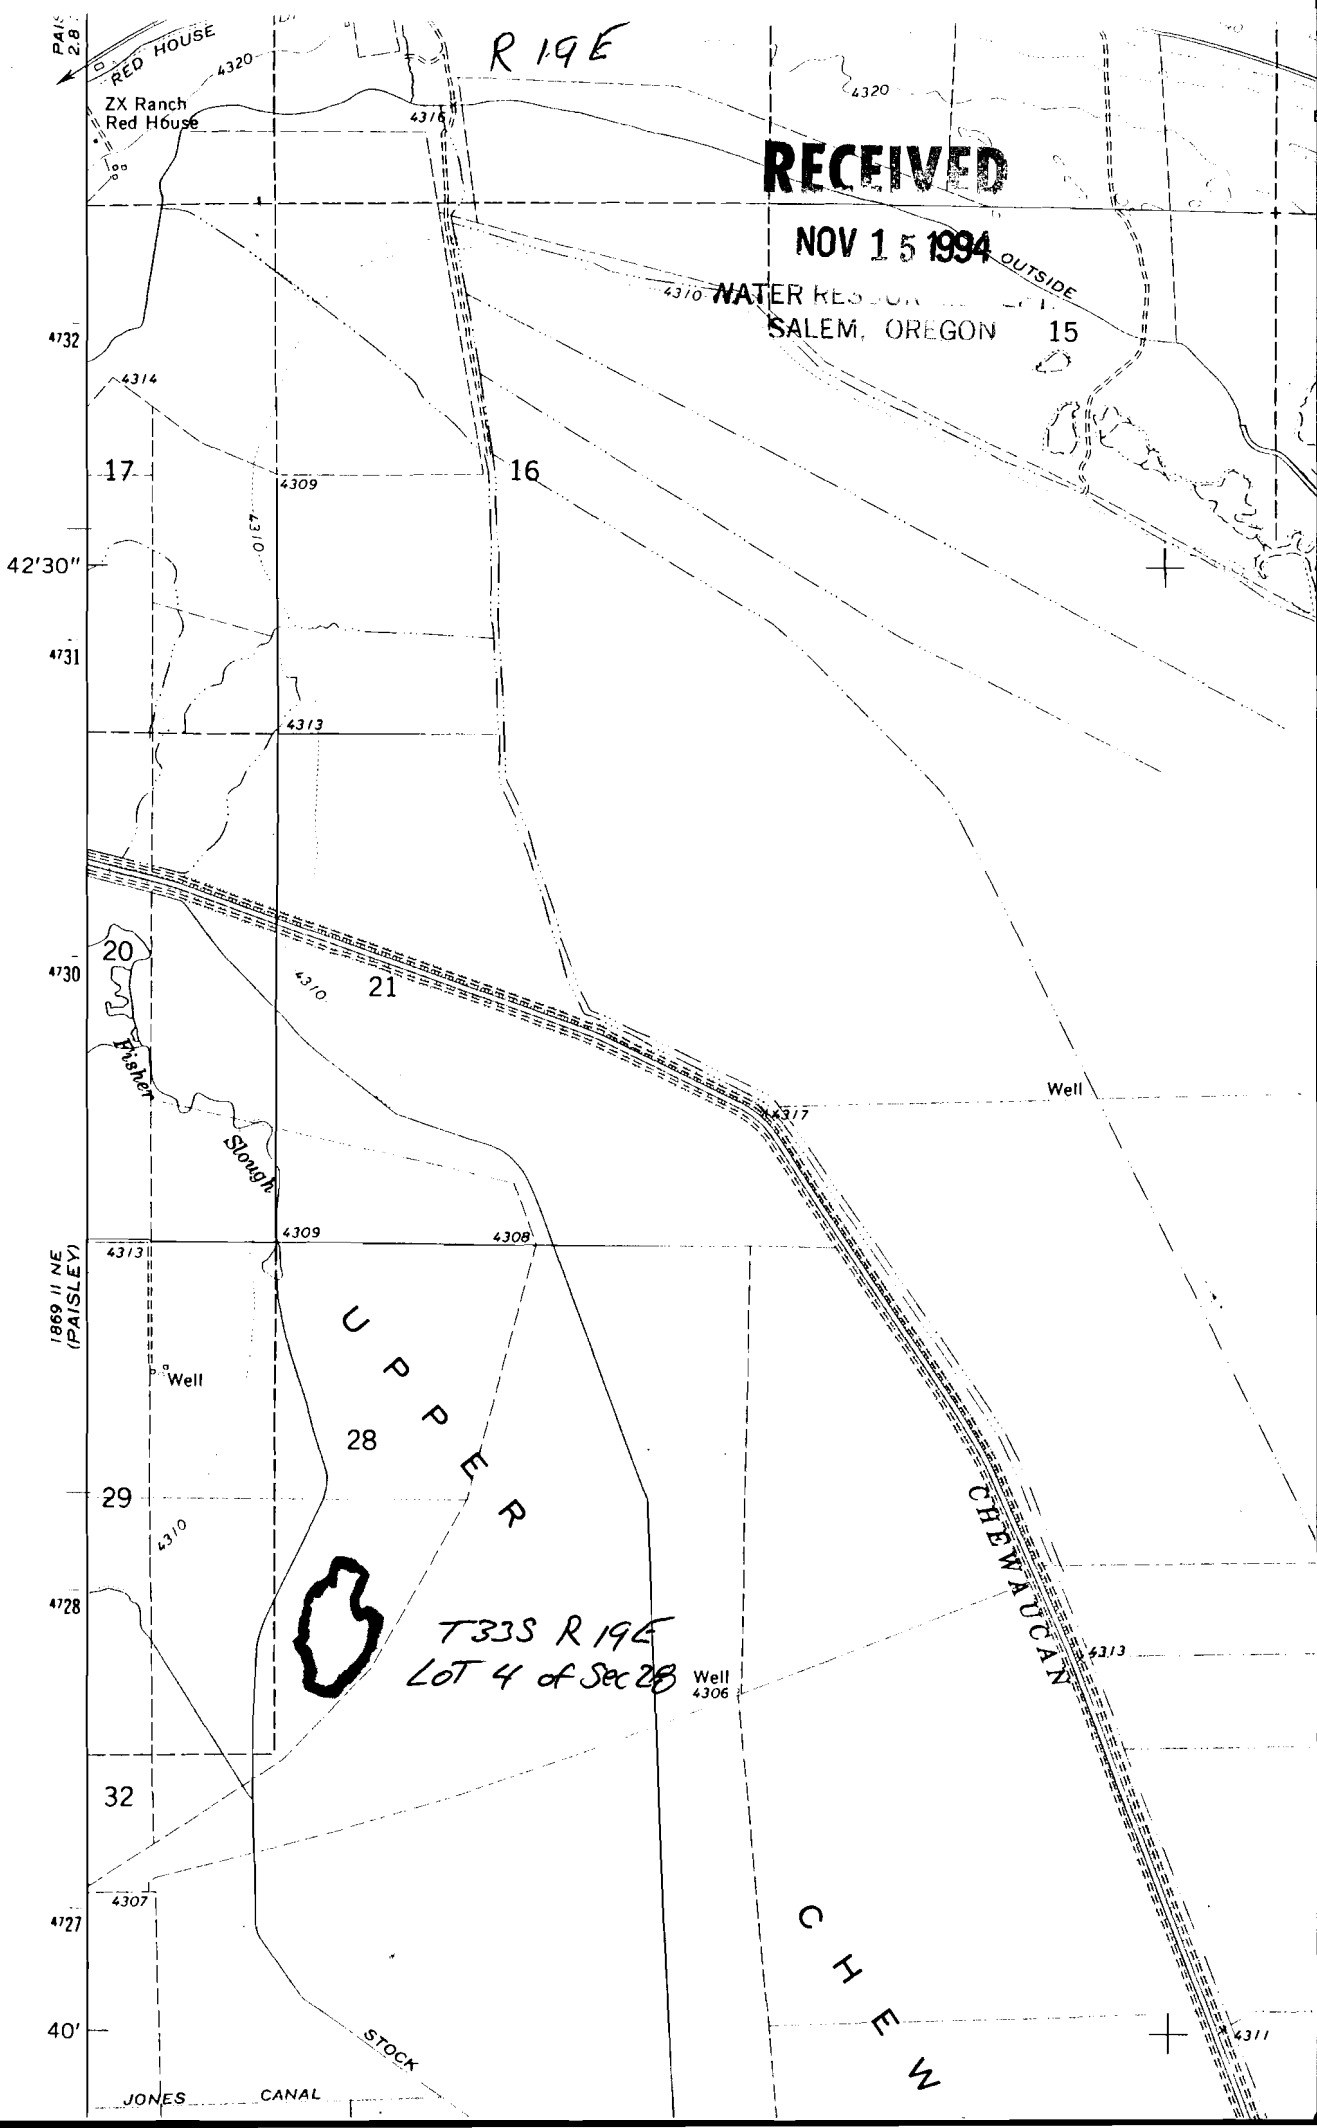

No Final Proof Map available

No Permit Map available