

SECTION 7 T.25S. R.6W. W.M.
DOUGLAS COUNTY

REVISED ON
4-26-94

25 6 7


THIS MAP WAS PREPARED FOR
ASSESSMENT PURPOSE ONLY.

1"=400'

CERTIFICATE NO. 69345

SEE MAP 25 6 6

Application No. R-74967
Permit No.

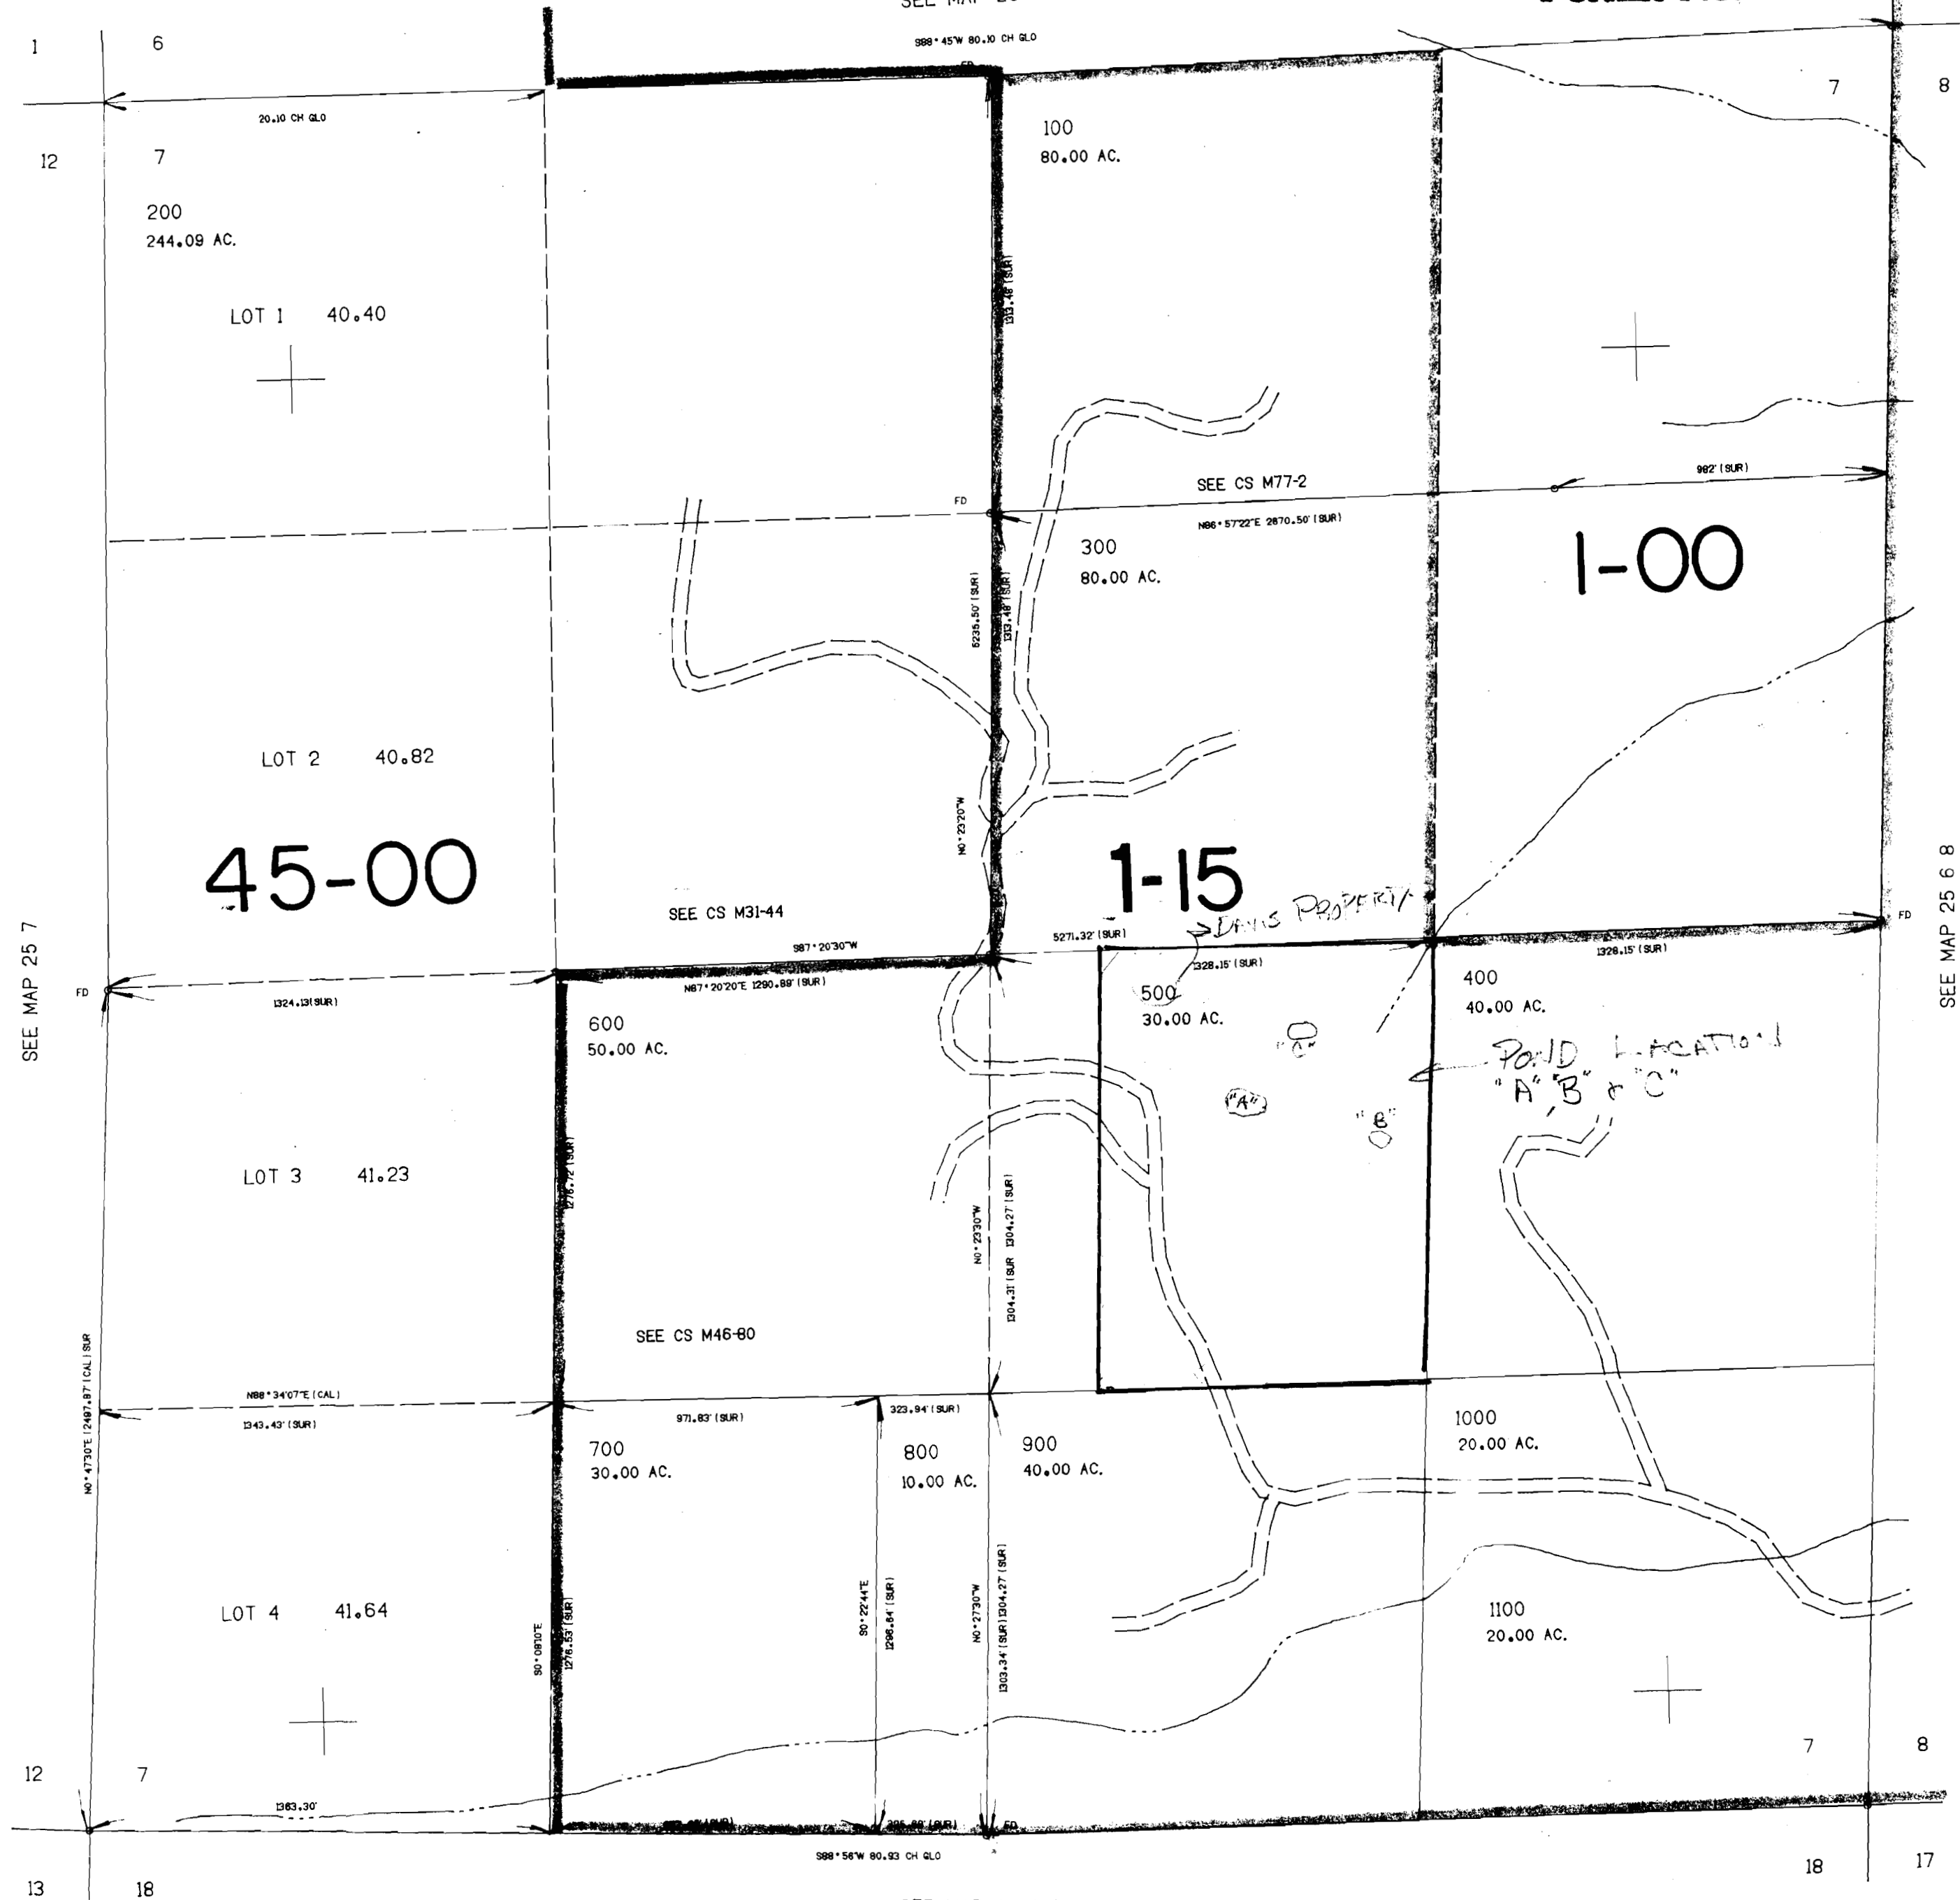

RECEIVED
NOV 11 1994
WATER RESOURCES
SALEM, OREGON

647.000

25 6 7

No Final Proof Map available

No Permit Map available