

Acct # 9392.00

T27-R7-S24-TL100

KEY TITLE COMPANY


DLC NO. 48

13

18

19

57

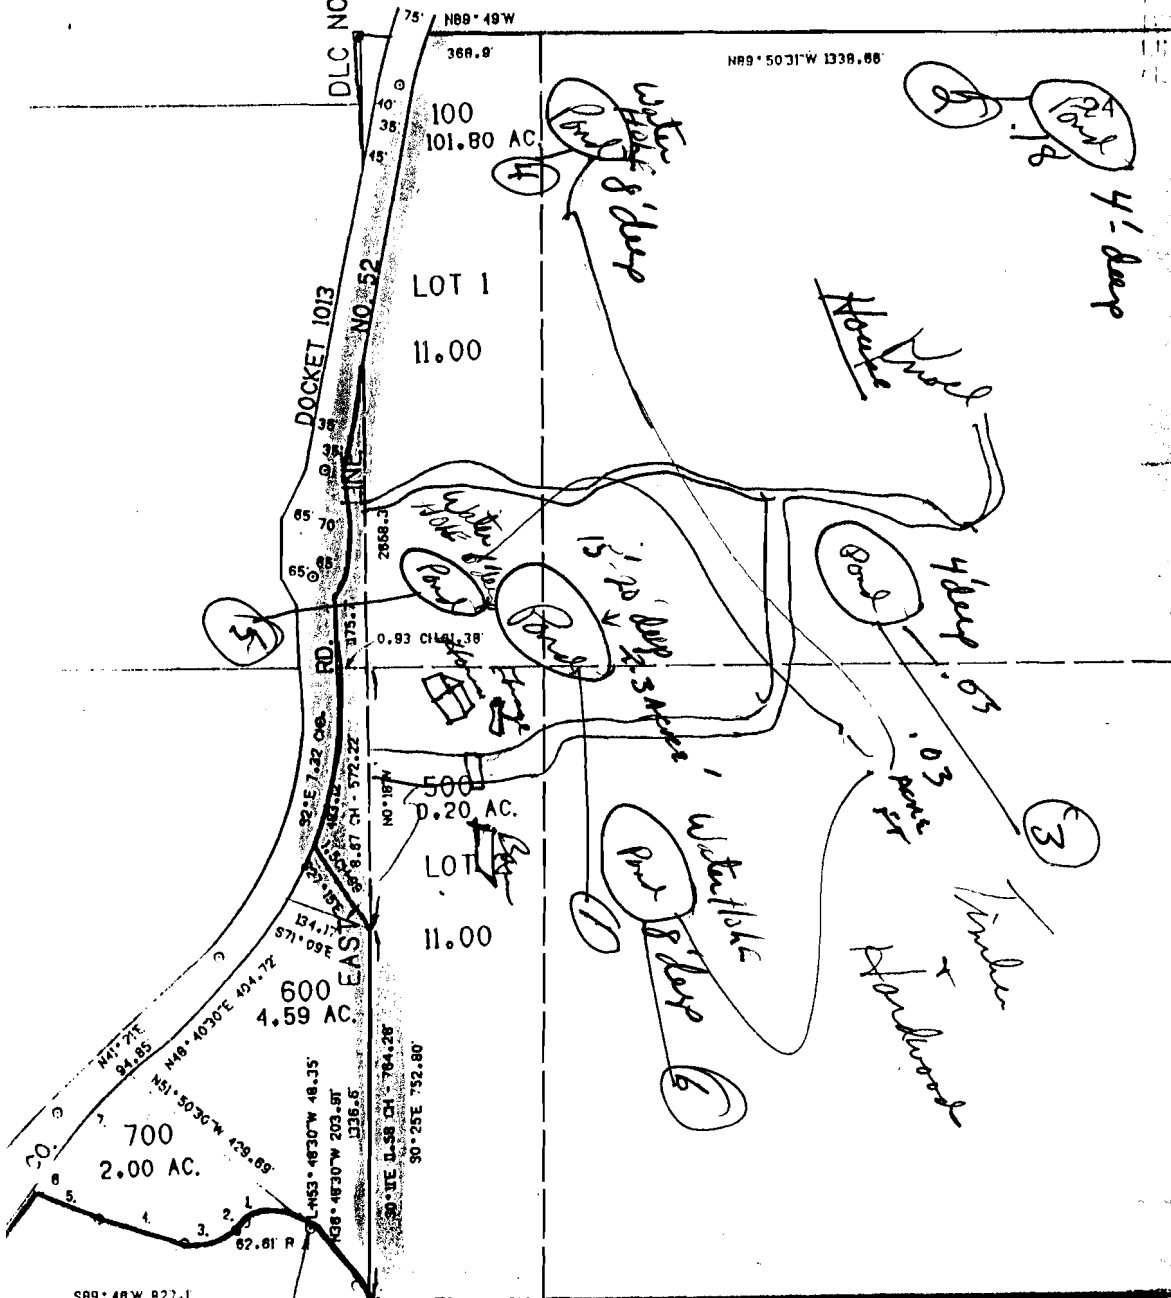

1. LC- S79°30'W 80.9'
2. S49°47'W 27.24'
3. LC- S78°41'W 138.9'
4. N72°25'W 184.83'
5. N85°18'30"W 130.5'
6. N37°51'30"E 80.16'
7. N38°39'30"E 201.30'

M
 Joe & Margaret Martin
 5744 Columbia Road
 Redding, OR 97470

SEE MAP 27 6 19

Application No. R-74918
 Permit No.

RECEIVED

NOV 15 1994

WATER RESOURCES DEPT.
SALEM, OREGON

CERTIFICATE NO. 69346

SEE MAP

SE COR WM, MORIN
 DLC NO. 48

SE COR WM, MORIN
 DLC NO. 48

No Final Proof Map available

No Permit Map available