
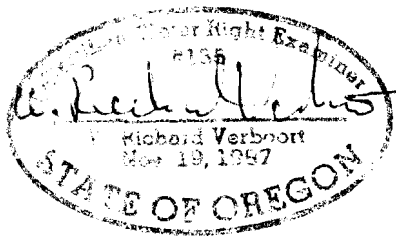


SECTION 18 T.2 N., R.2 W., W.M.

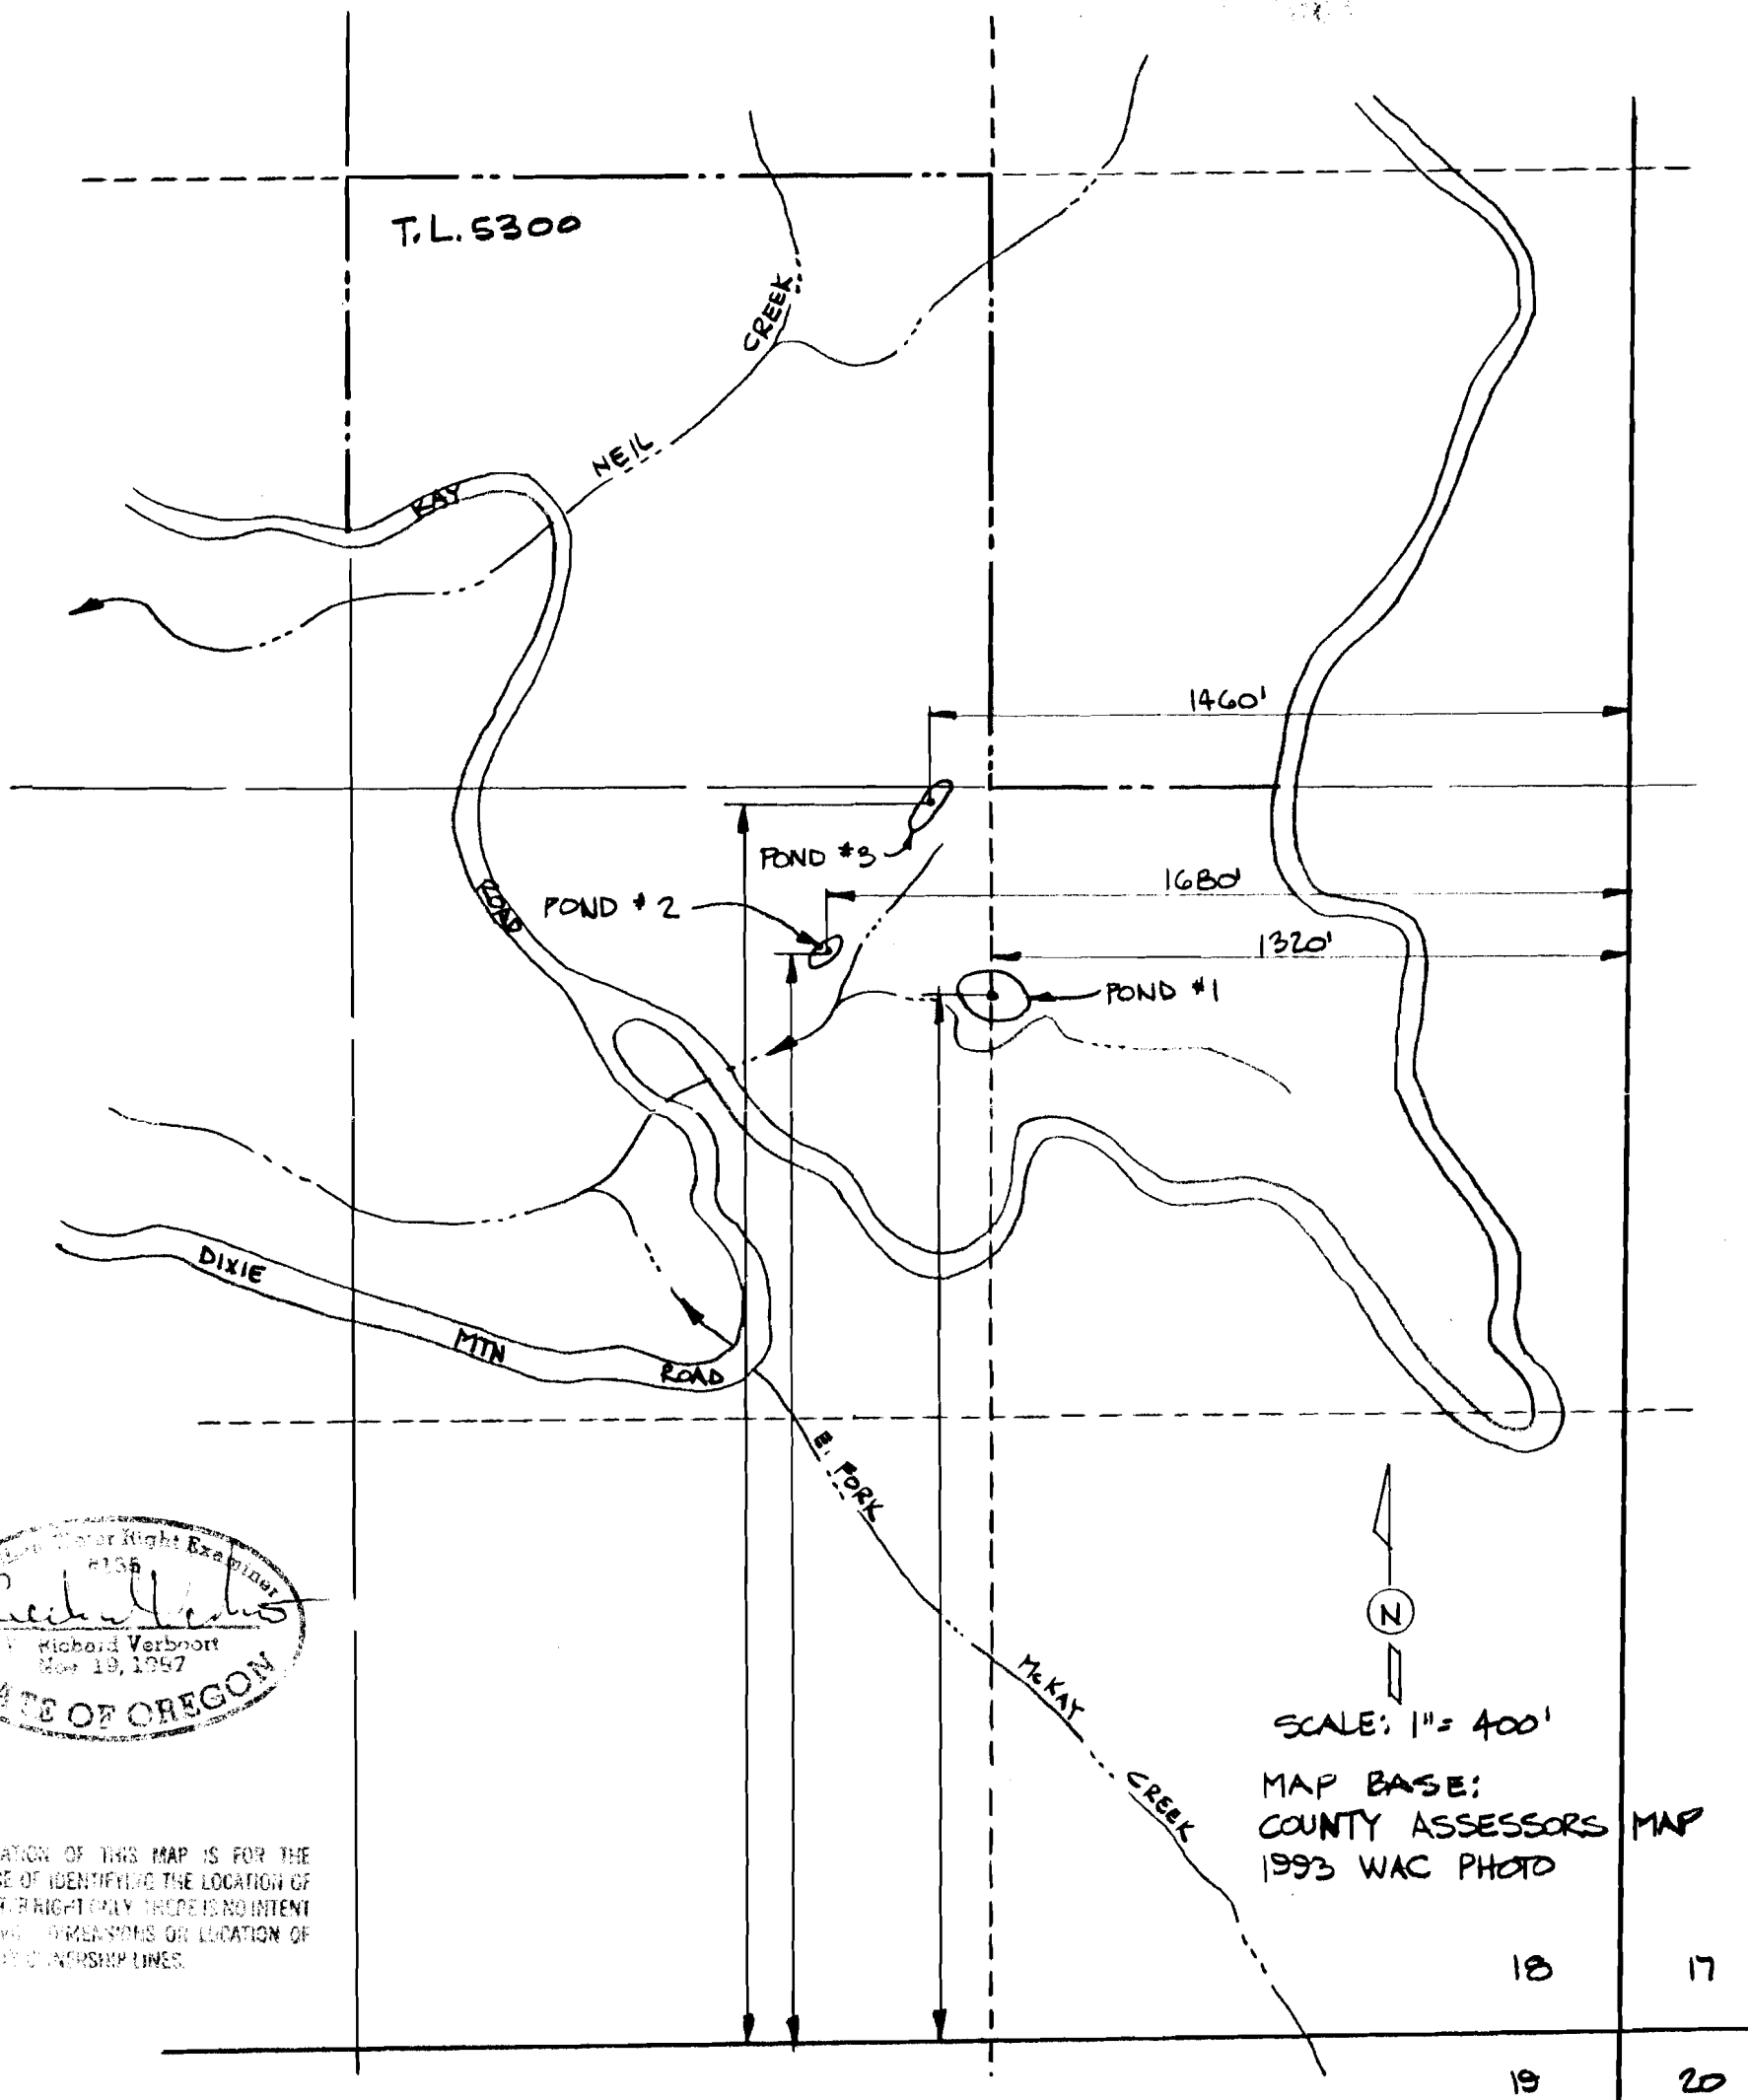

PREPARATION OF THIS MAP IS FOR THE PURPOSE OF IDENTIFYING THE LOCATION OF THE WATER RIGHT ONLY. THERE IS NO INTENT TO PROVE OR REVEAL OR LOCATE OF PROPERTY OWNERSHIP LINES.

WATER RIGHT APPLICATION MAP

Application No. R-74920
 Permit No. _____

CERTIFICATE NO. 69348

VERBOORT ENGINEERING
 AGRICULTURE • CIVIL • WATER RESOURCES
 HILLSBORO, OREGON

	by	date
designed	WRV	10-29-94
drawn	JER	10-29-94
checked	WRV	10-25-94
drawing no.	94-B-20	
sheet no.	1/1	

TIM & EL DONNA GRABER
 13103 SE NIXON AVE
 MILWAUKIE, OR 97222

No Final Proof Map available

No Permit Map available