

Application No. R-75018  
 Permit No.

SECTION 19 T.27S. R.6W. W.M.  
 DOUGLAS COUNTY

REVISED ON  
 4-3-91

1" = 400'

CERTIFICATE NO. 69362


SEE MAP 27 6 18

18

589\*372

1201  
 1201MI  
 5.00 Ac.

00

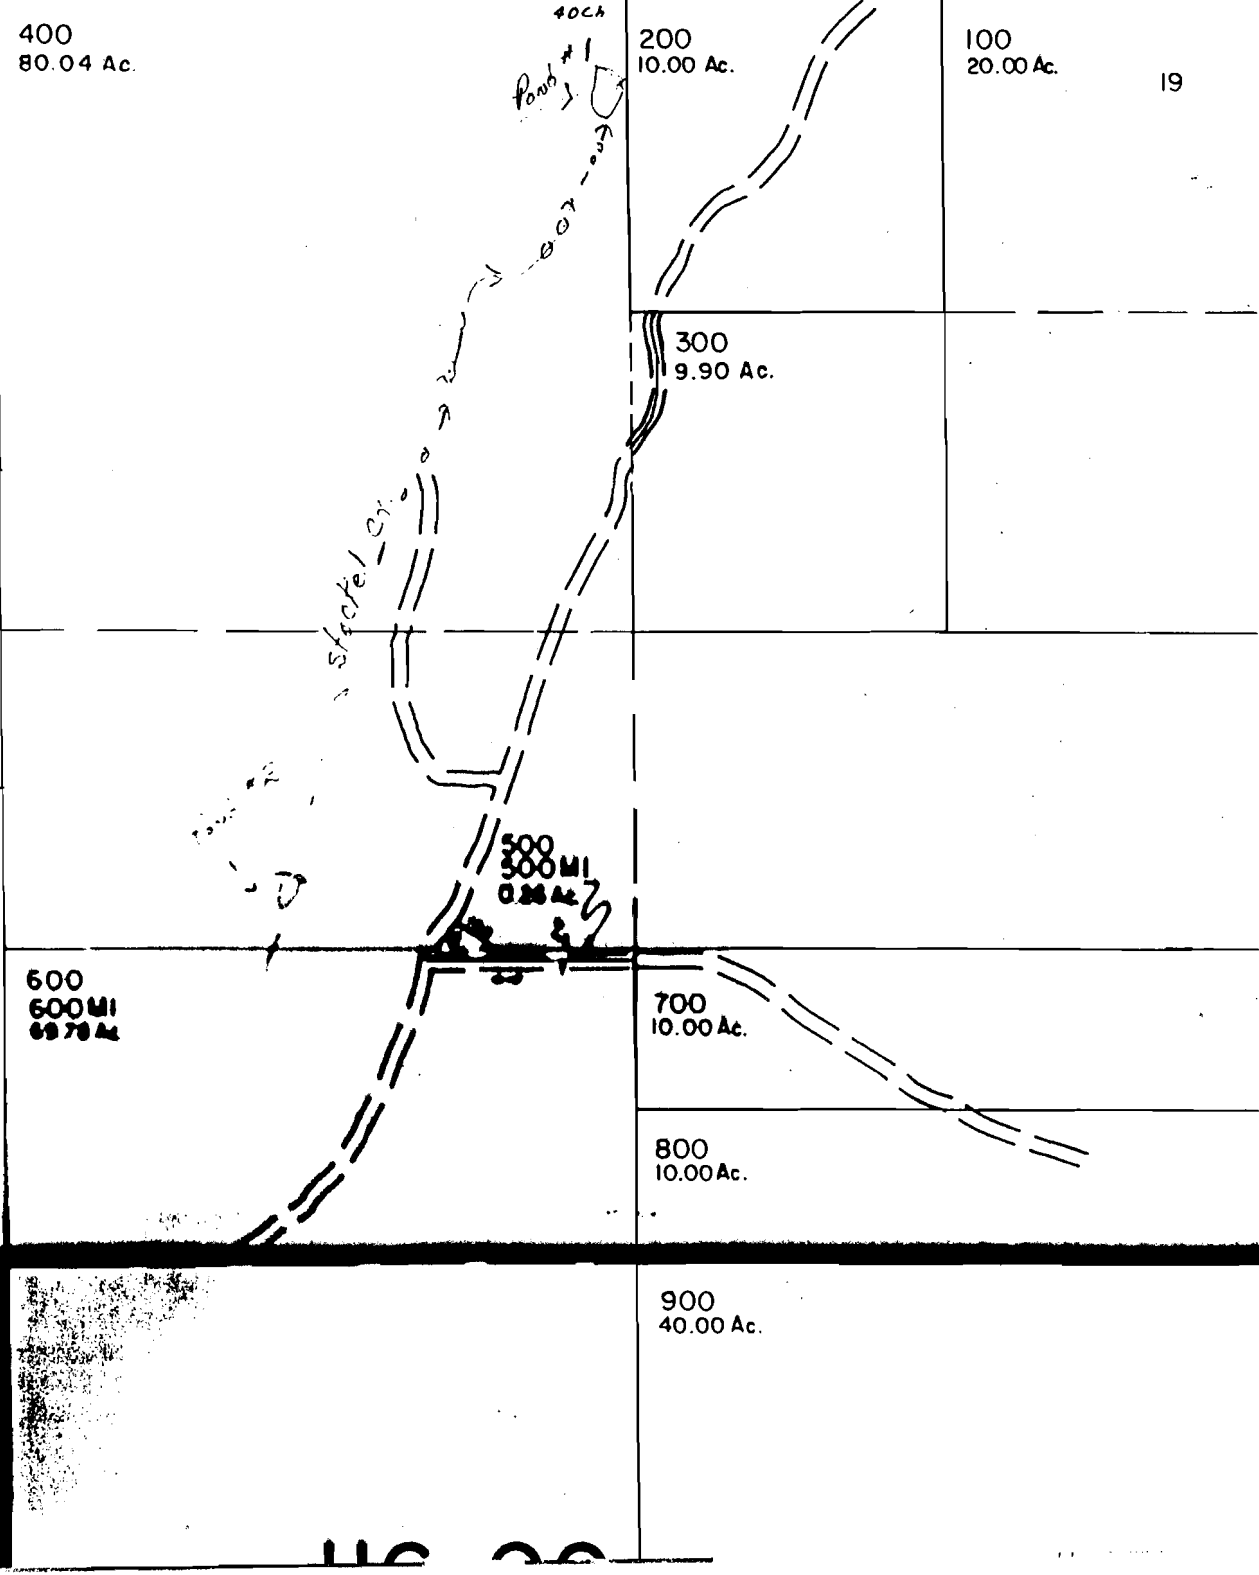

19

46 00

No Final Proof Map available

No Permit Map available