

Application No. R-75036

Permit No.


T.23S., R.7 W., W.M.

SCALE: 1" = 400'

CERTIFICATE NO. 69371

REGISTRATION STATEMENT MAP

SECTION 20

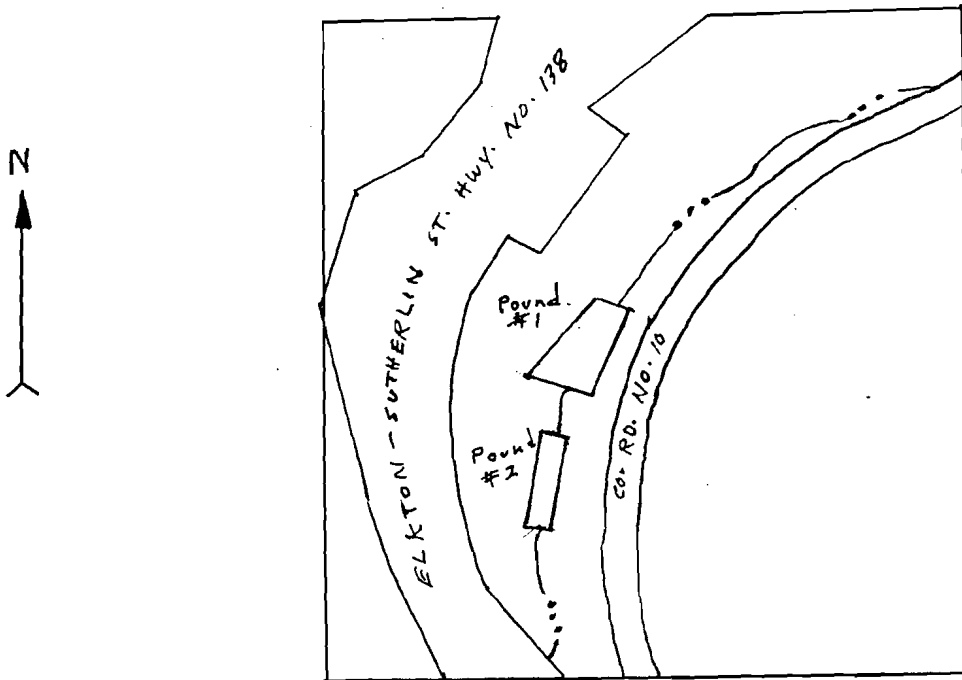

NE 1/4 NW 1/4


THE PURPOSE OF THIS MAP IS TO IDENTIFY THE LOCATION OF THE WATER RIGHT. IT IS NOT INTENDED TO PROVIDE INFORMATION RELATIVE TO THE LOCATION OF PROPERTY OWNERSHIP BOUNDARY LINES.

UNDER

IN NAME OF

TIM SHEPHERD

Surveyed AUG 30, 1992, by DUANE KIRBY

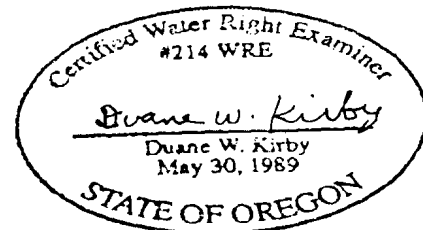

No Final Proof Map available

No Permit Map available