


SECTION 1 T.31S. R.2W. W.M.
DOUGLAS COUNTY

THIS MAP WAS PREPARED FOR
ASSESSMENT PURPOSE ONLY.

1"=400'

SEE MAP 30 2

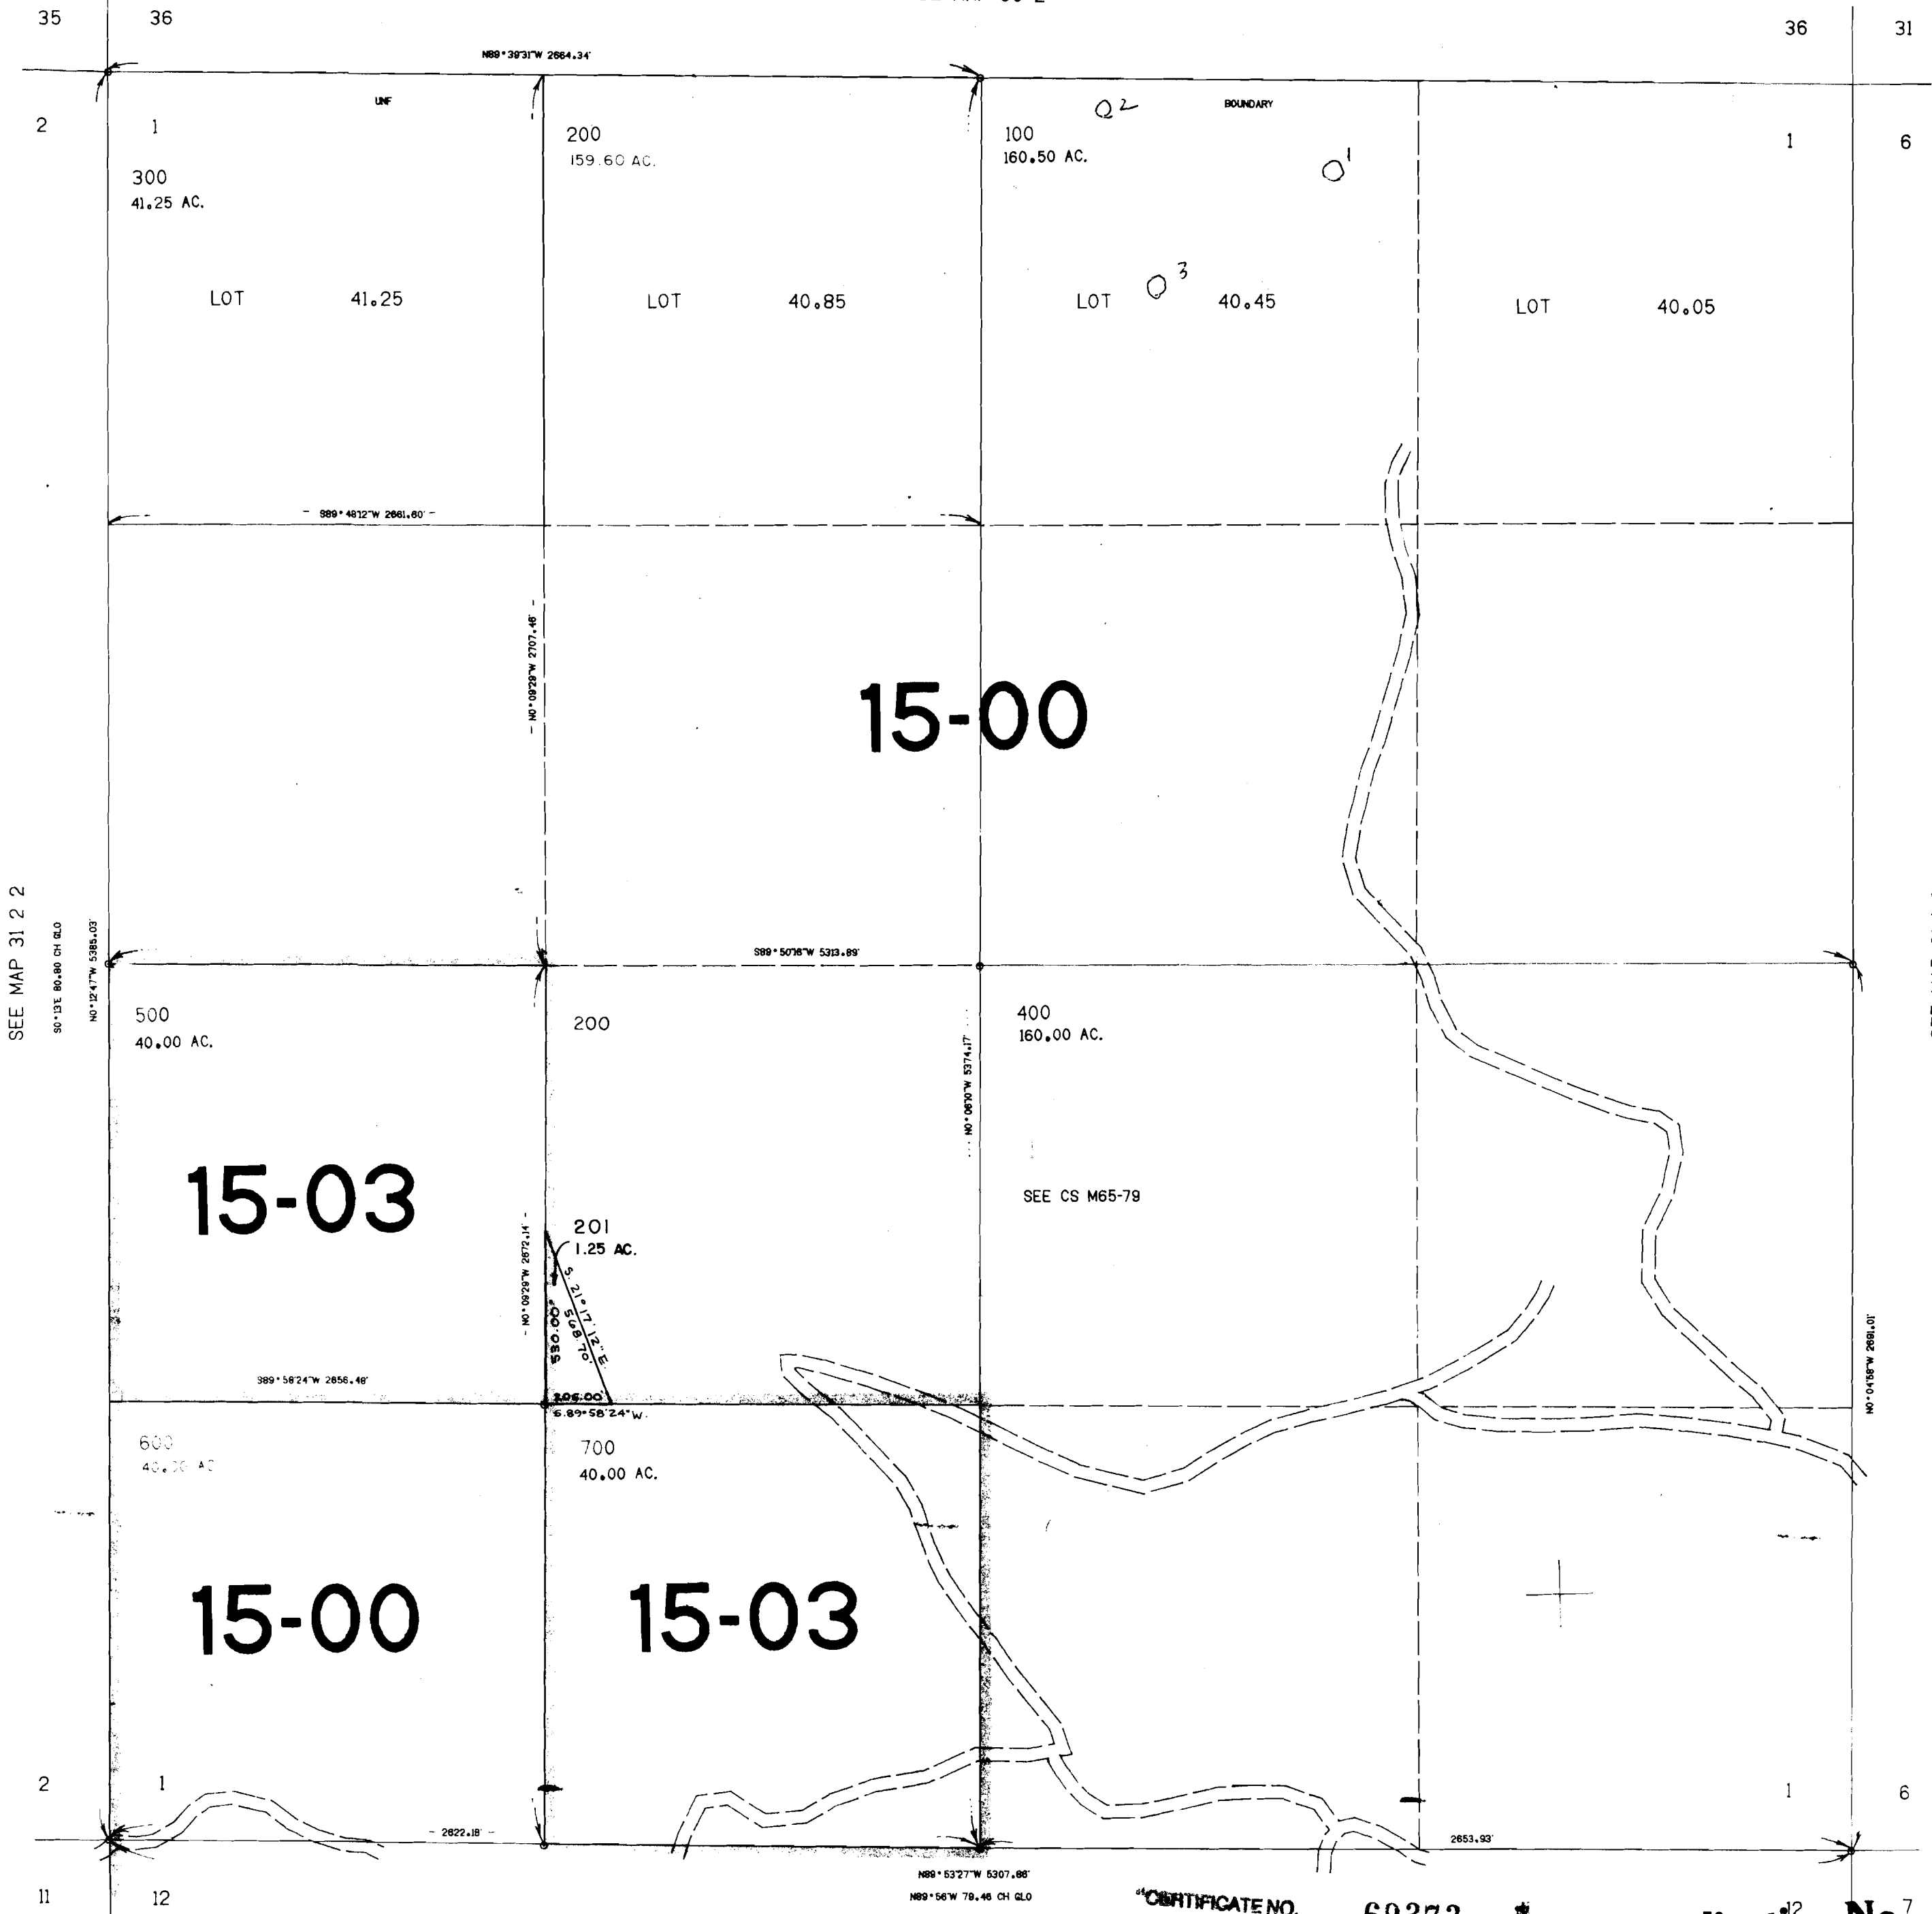

SEE MAP 31 2 12

CERTIFICATE NO. 69373

Application No. 75038
Permit No.

No Final Proof Map available

No Permit Map available