


T. 32 S.  
R. 5 W.

Scale 1" = 400 FT.

CERTIFICATE NO. 69381

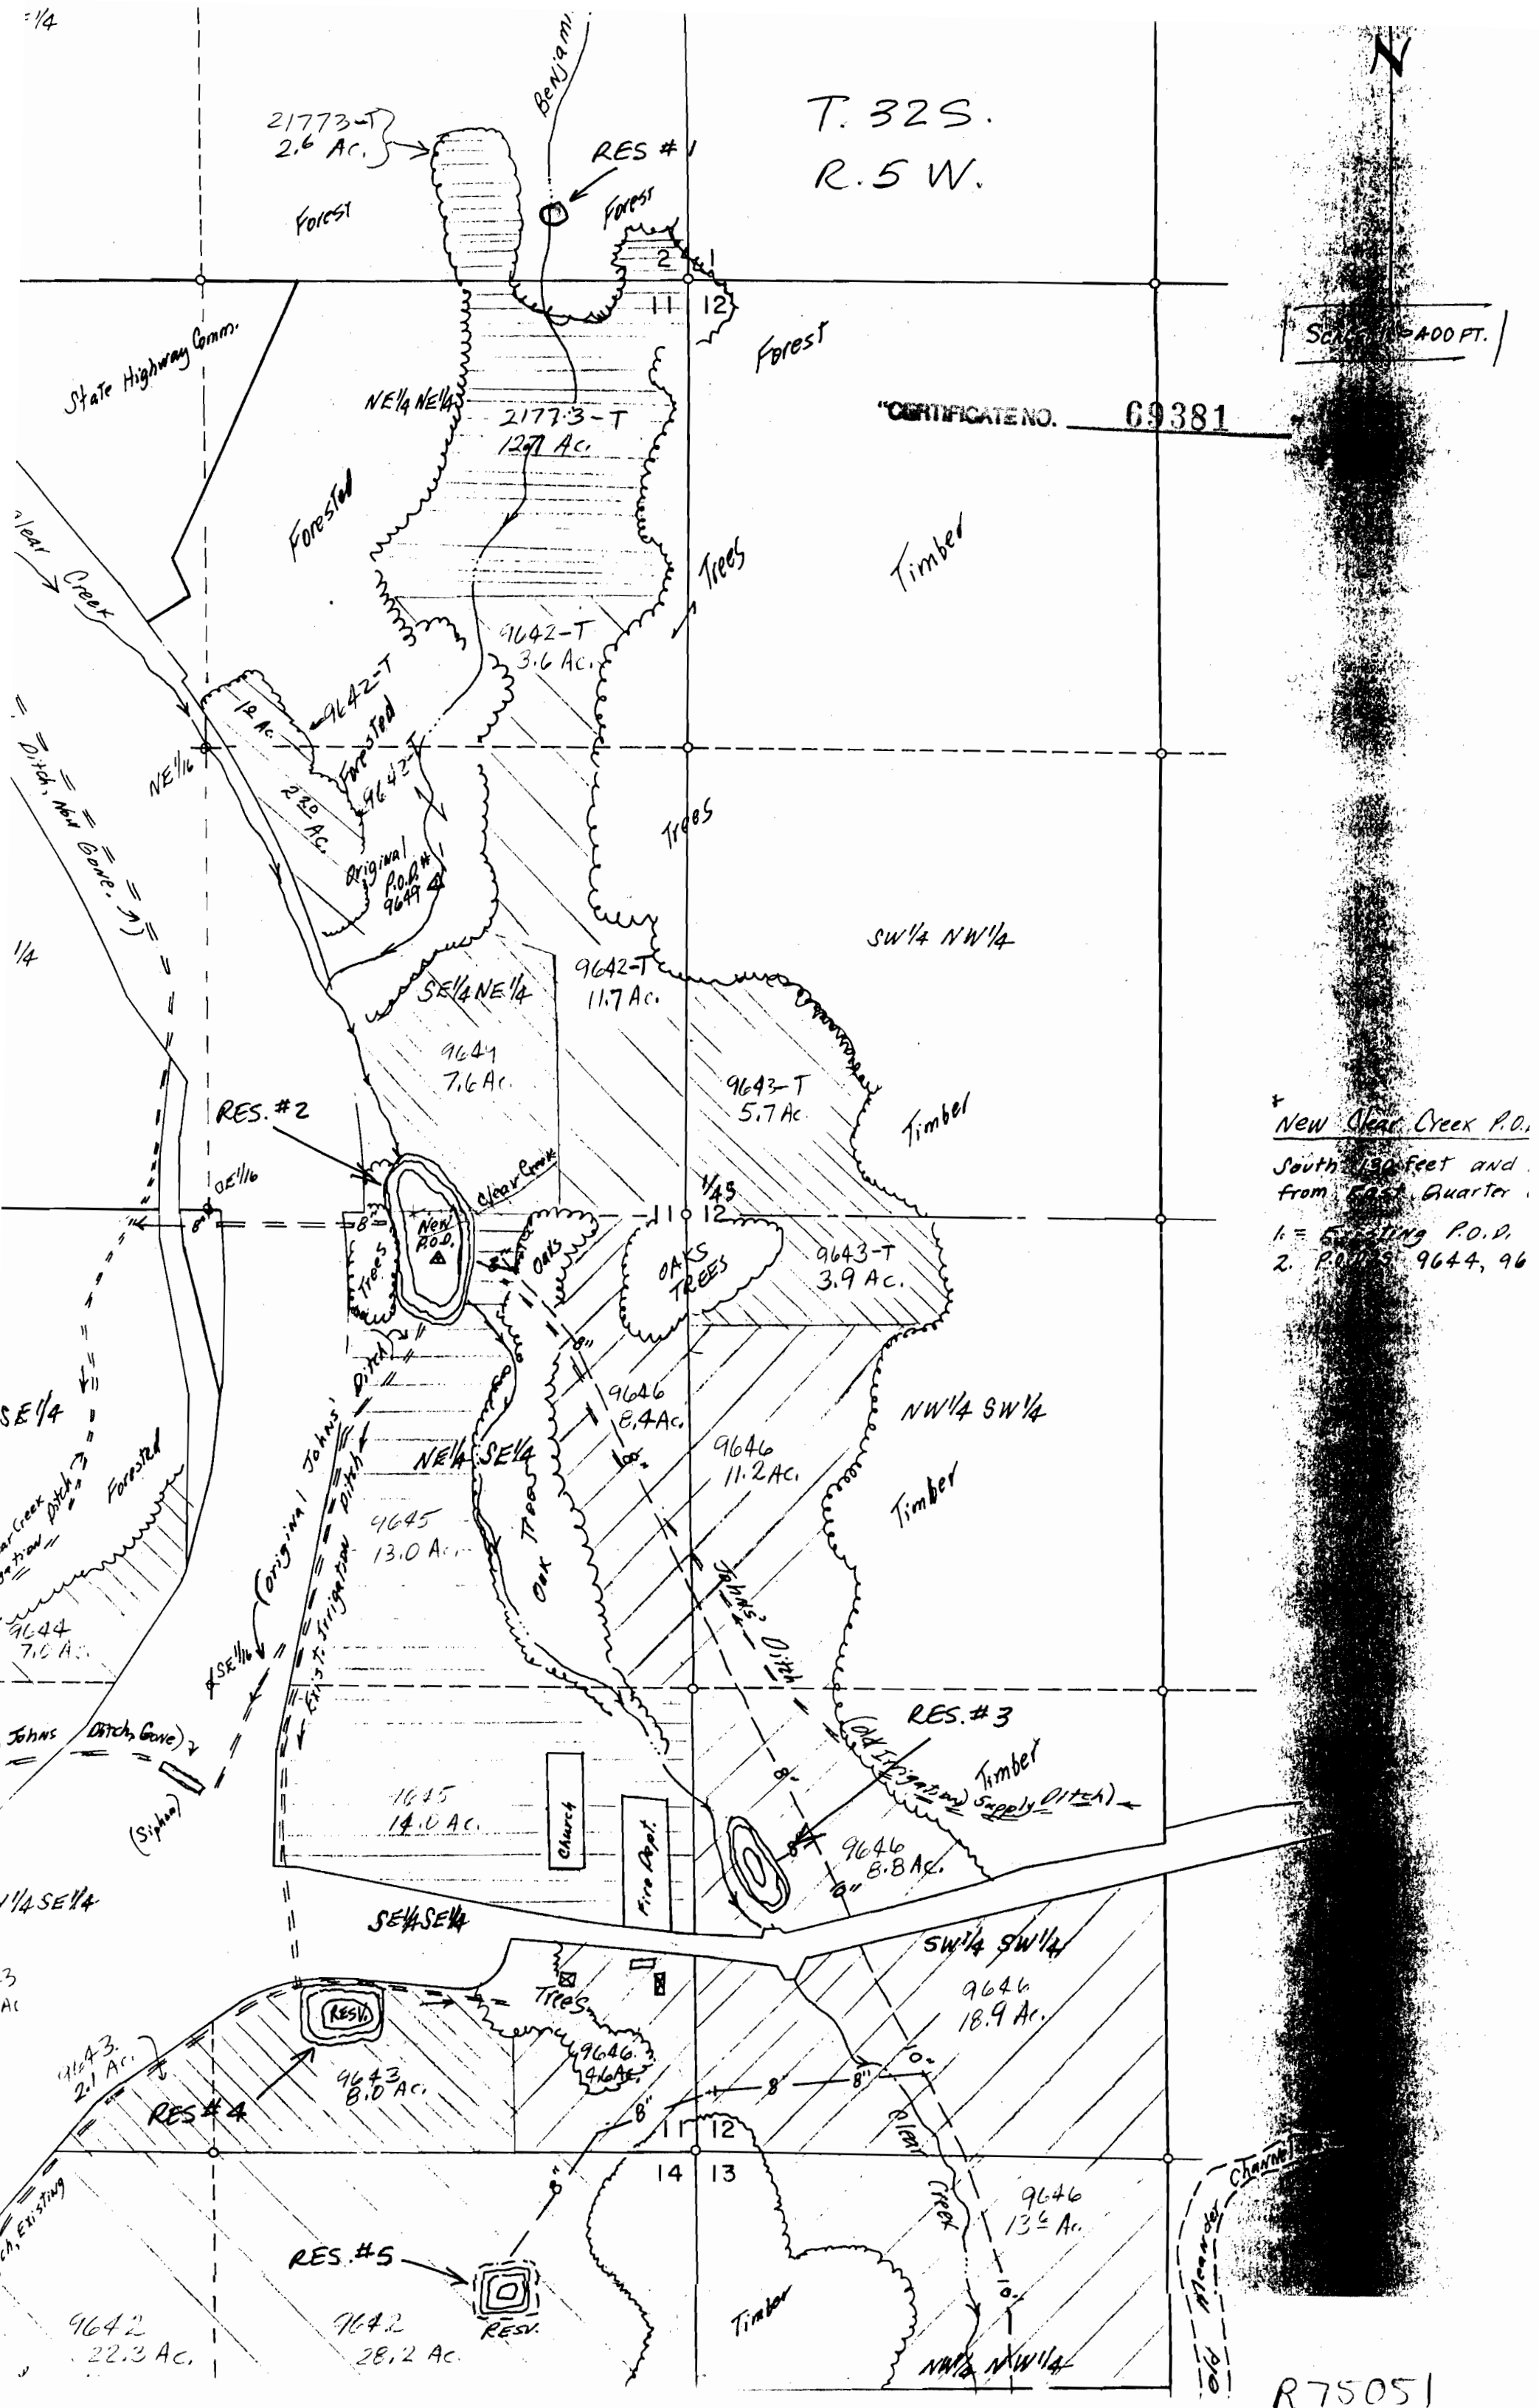

\* New Clear Creek P.O.  
 South 130 feet and  
 from East Quarter  
 1. = Existing P.O.  
 2. P.O.'S 9644, 96