


SECTION 17 T1N R3W W.M.

WASHINGTON COUNTY OREGON.

SCALE 1"=400'

SEE MAP
IN 3 8

CERTIFICATE NO. 69382 IN 3 17

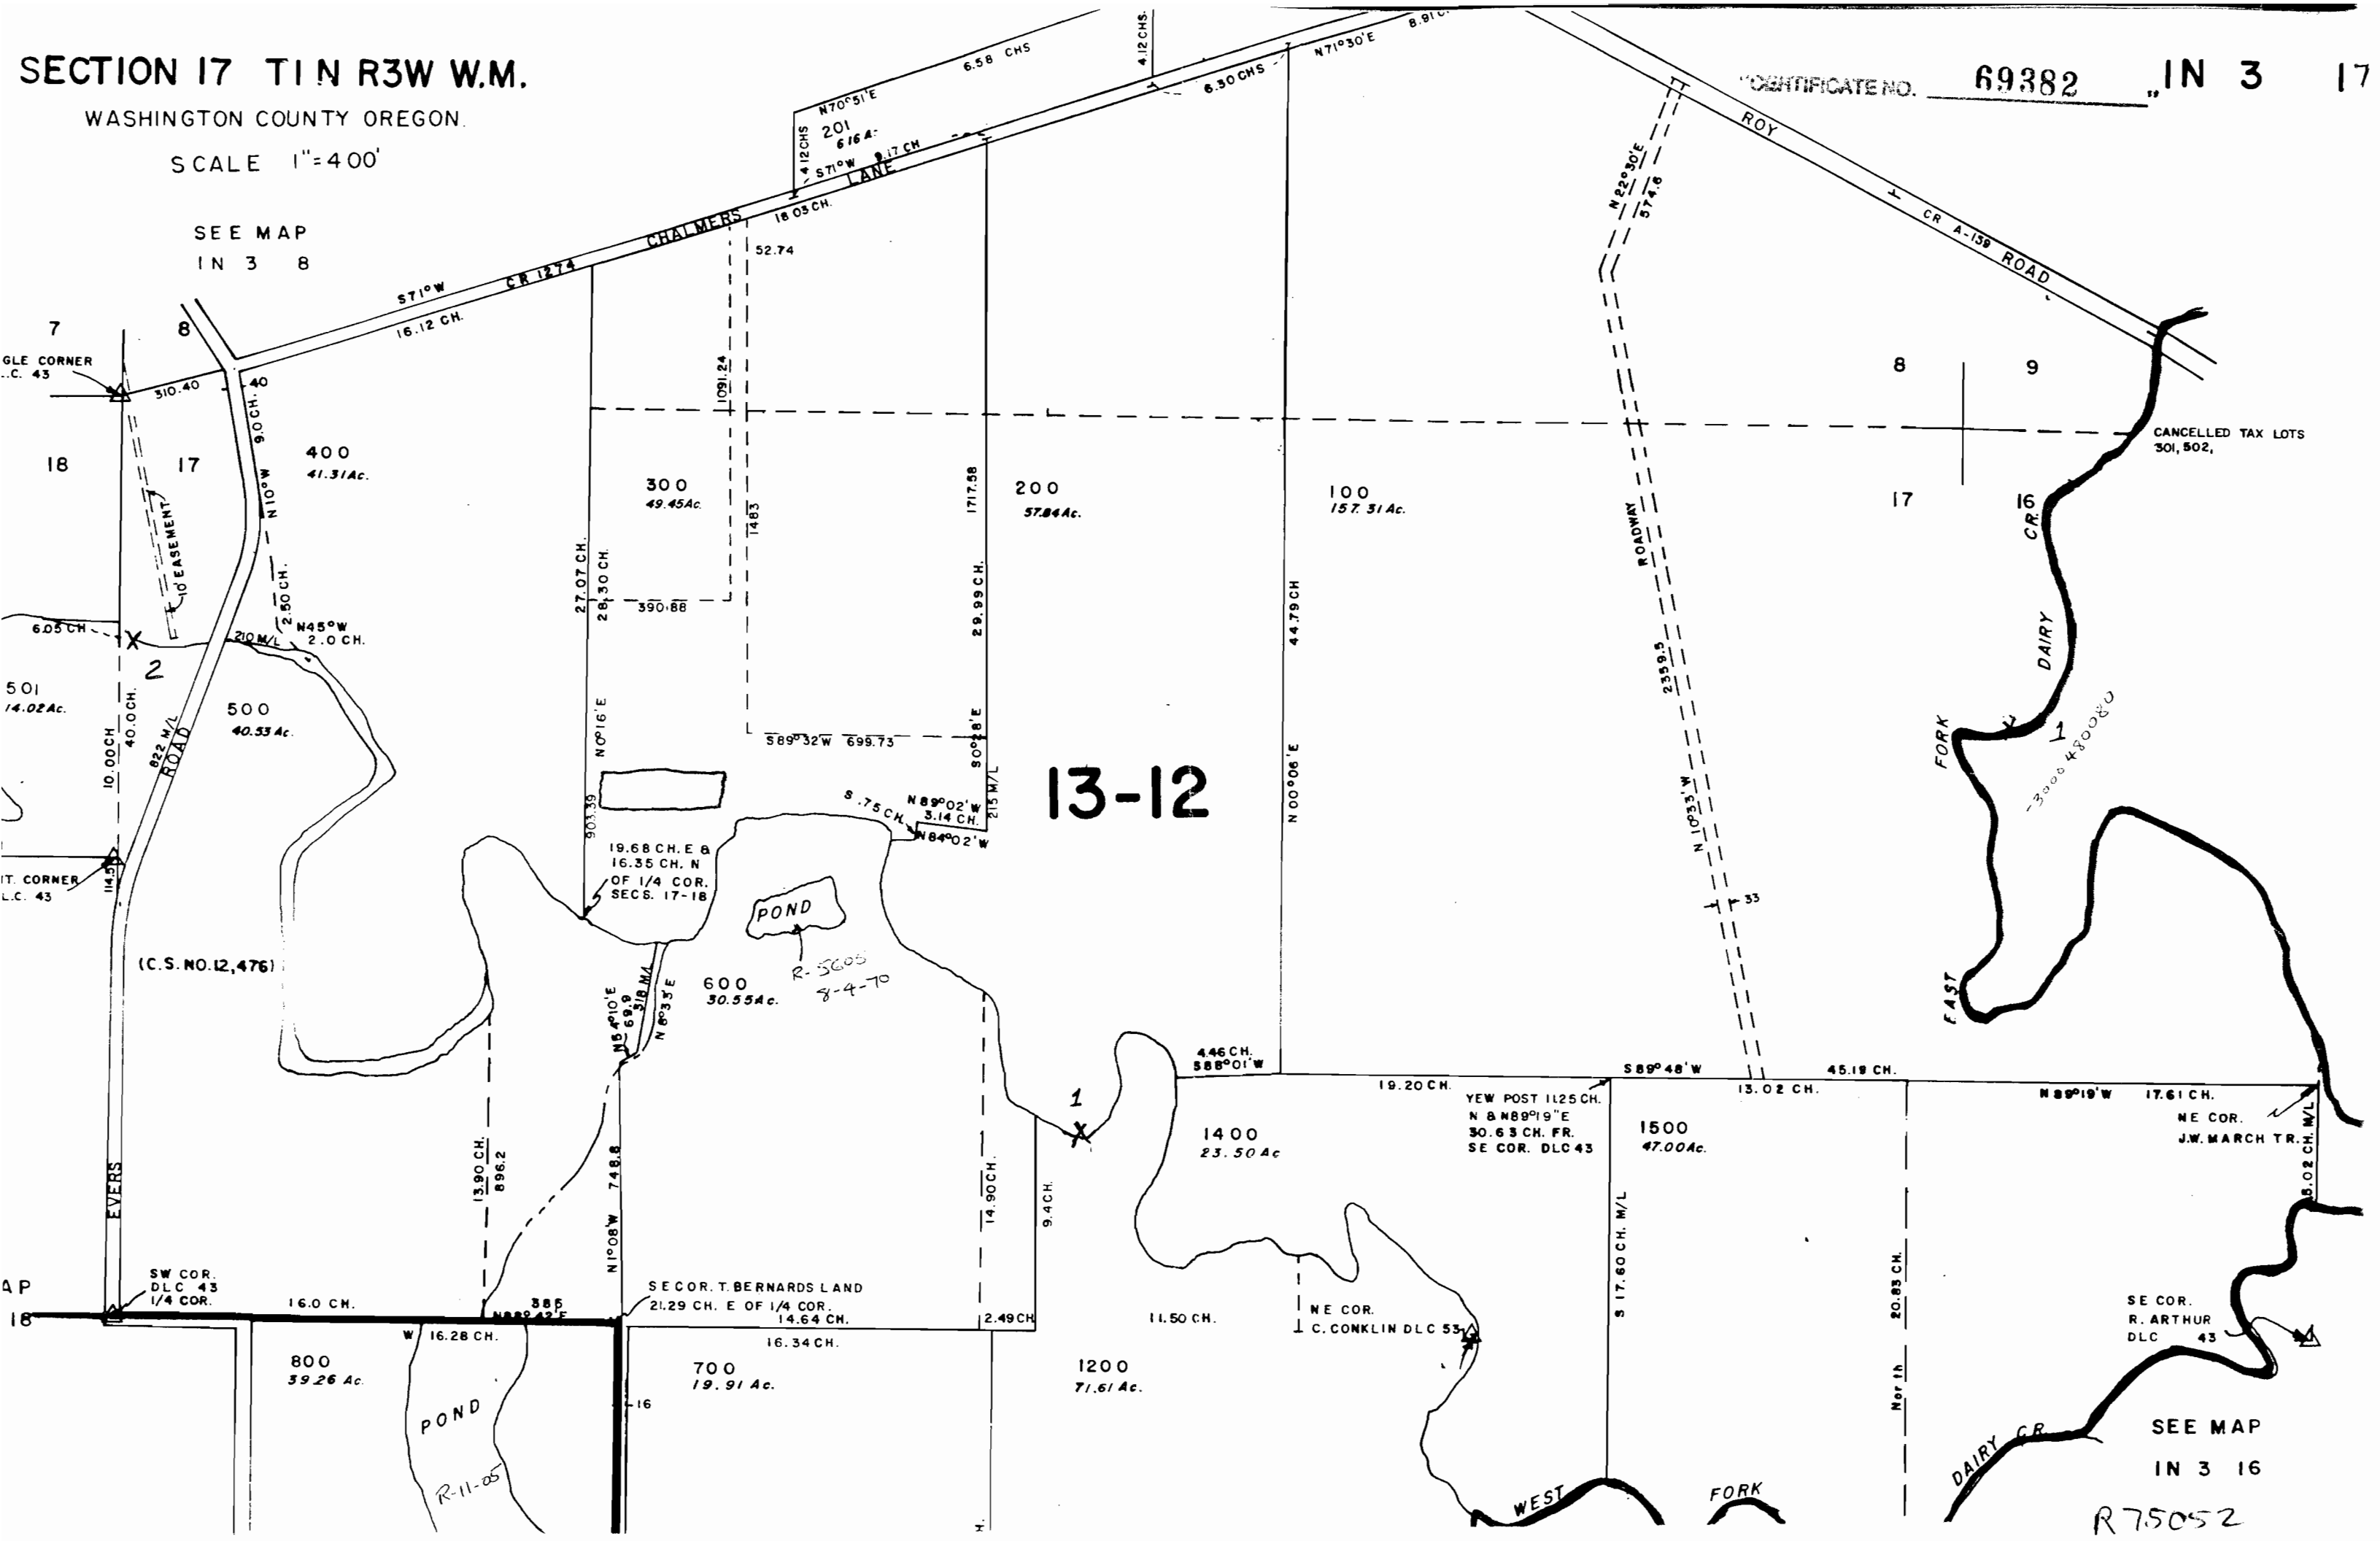

13-12

R75052