


**RECEIVED**

NOV - 7 1994

WATER RESOURCES DEPT.  
SALEM, OREGON

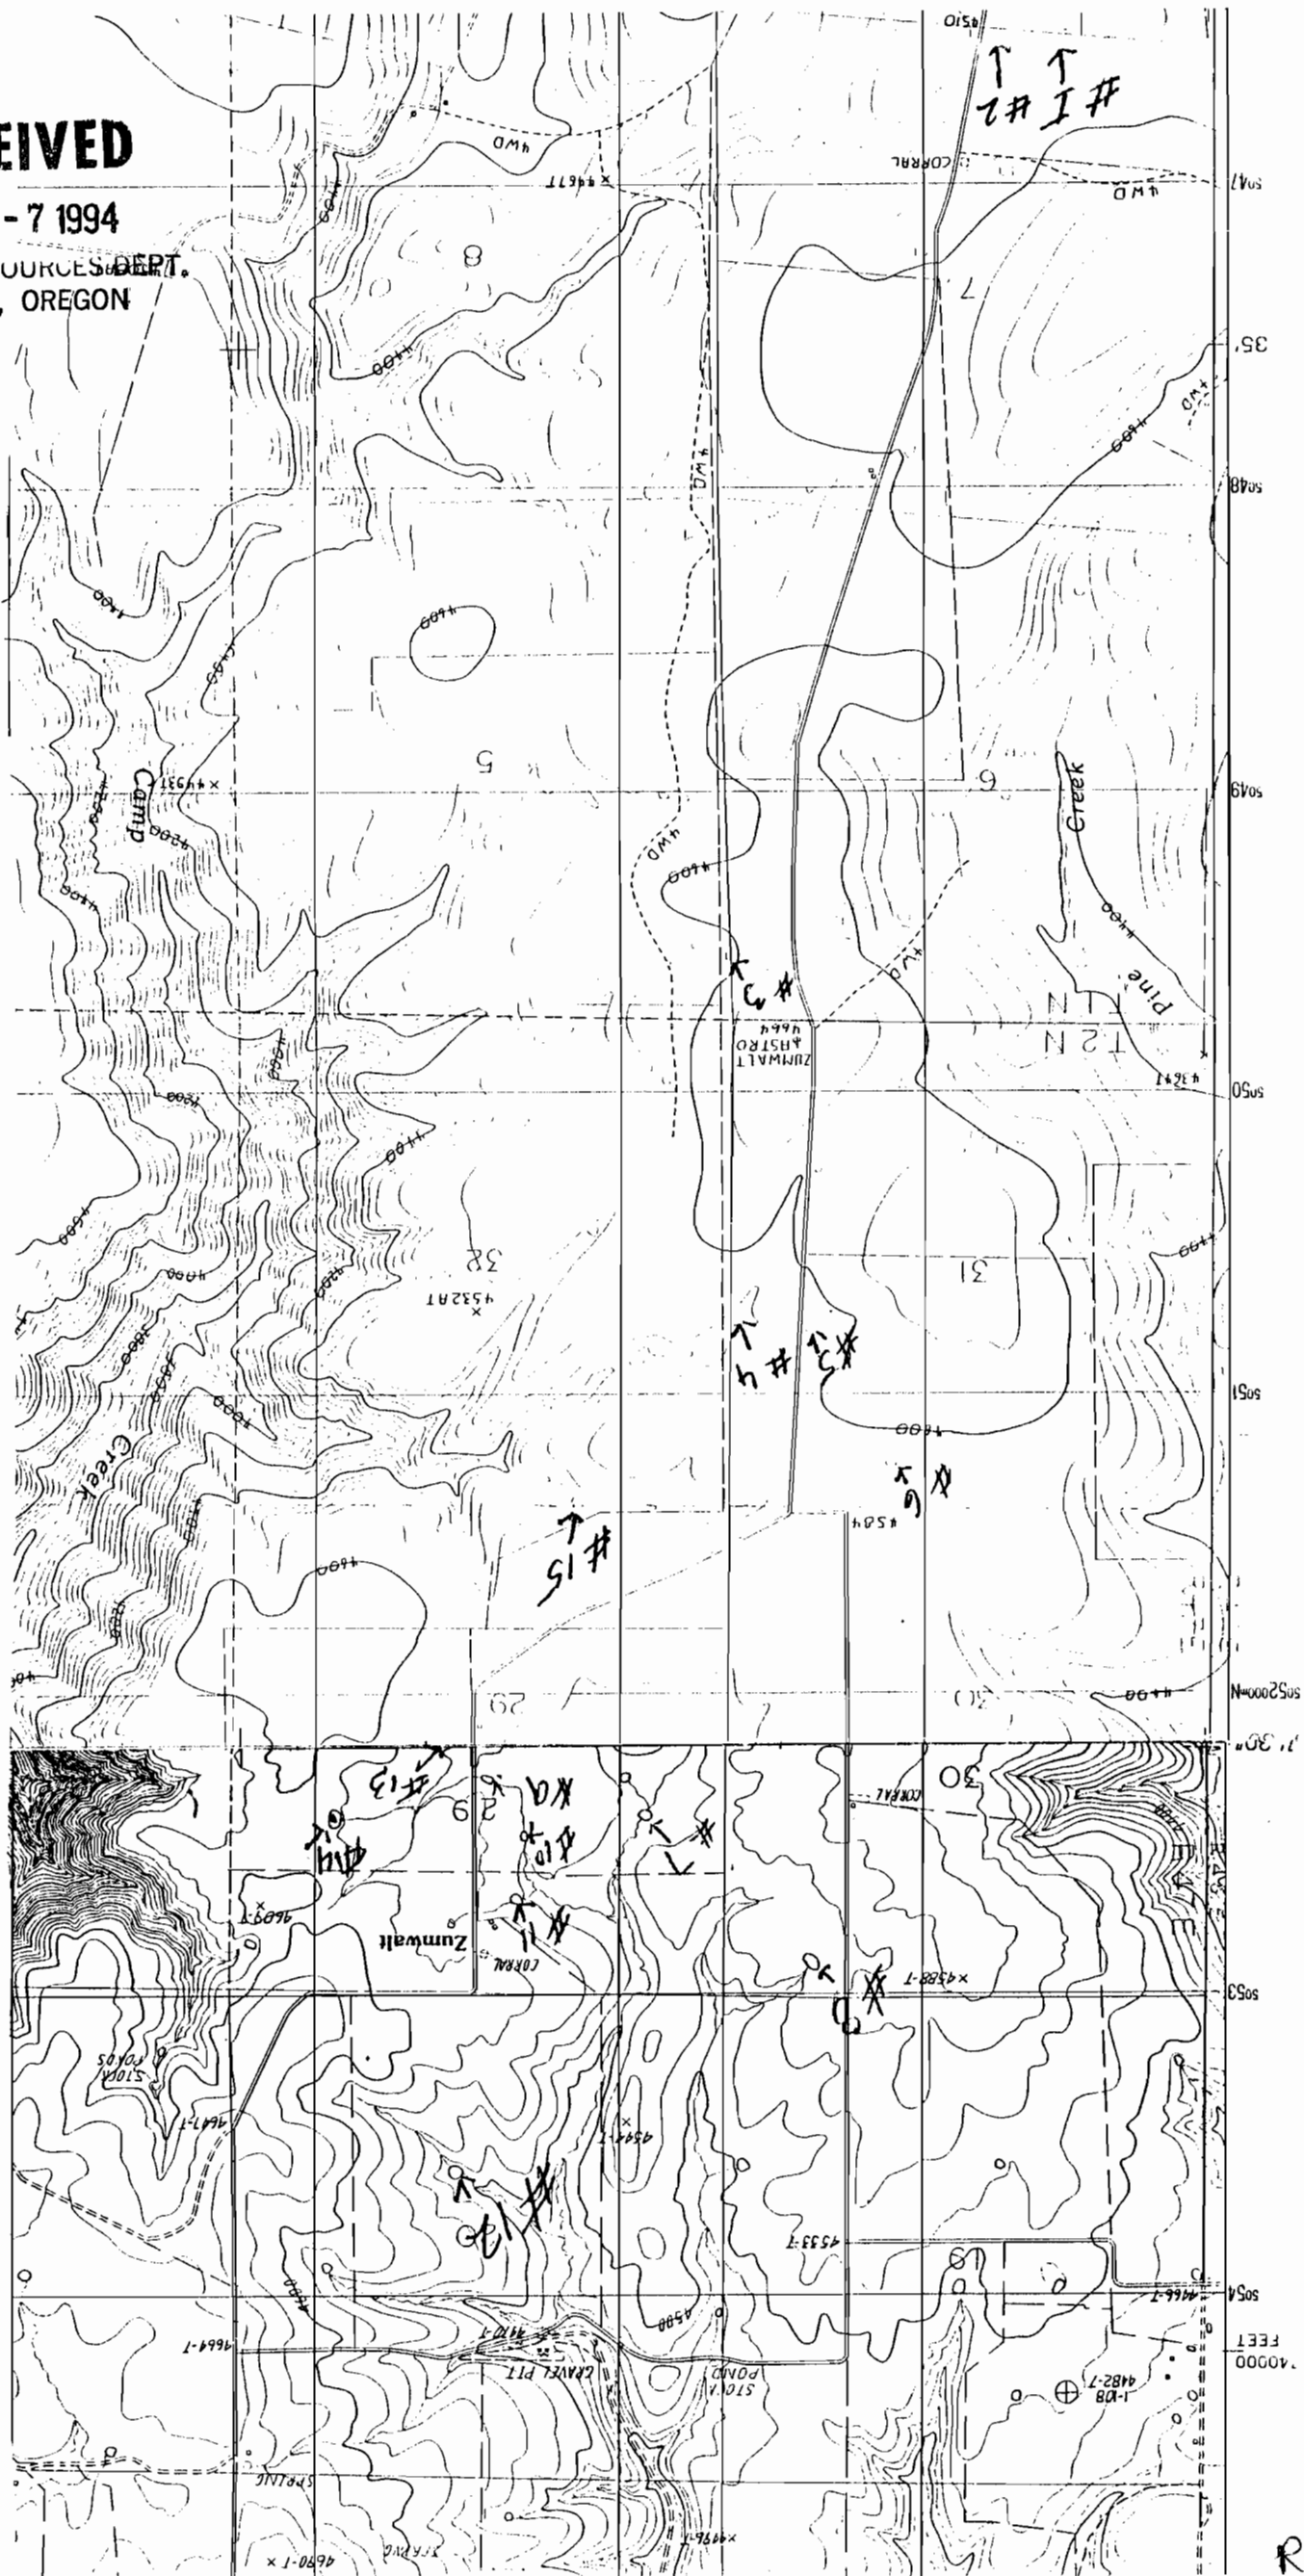

CERTIFICATE NO

69391

R75069