


7

1475' N. NE
SAUVIE ISLAND

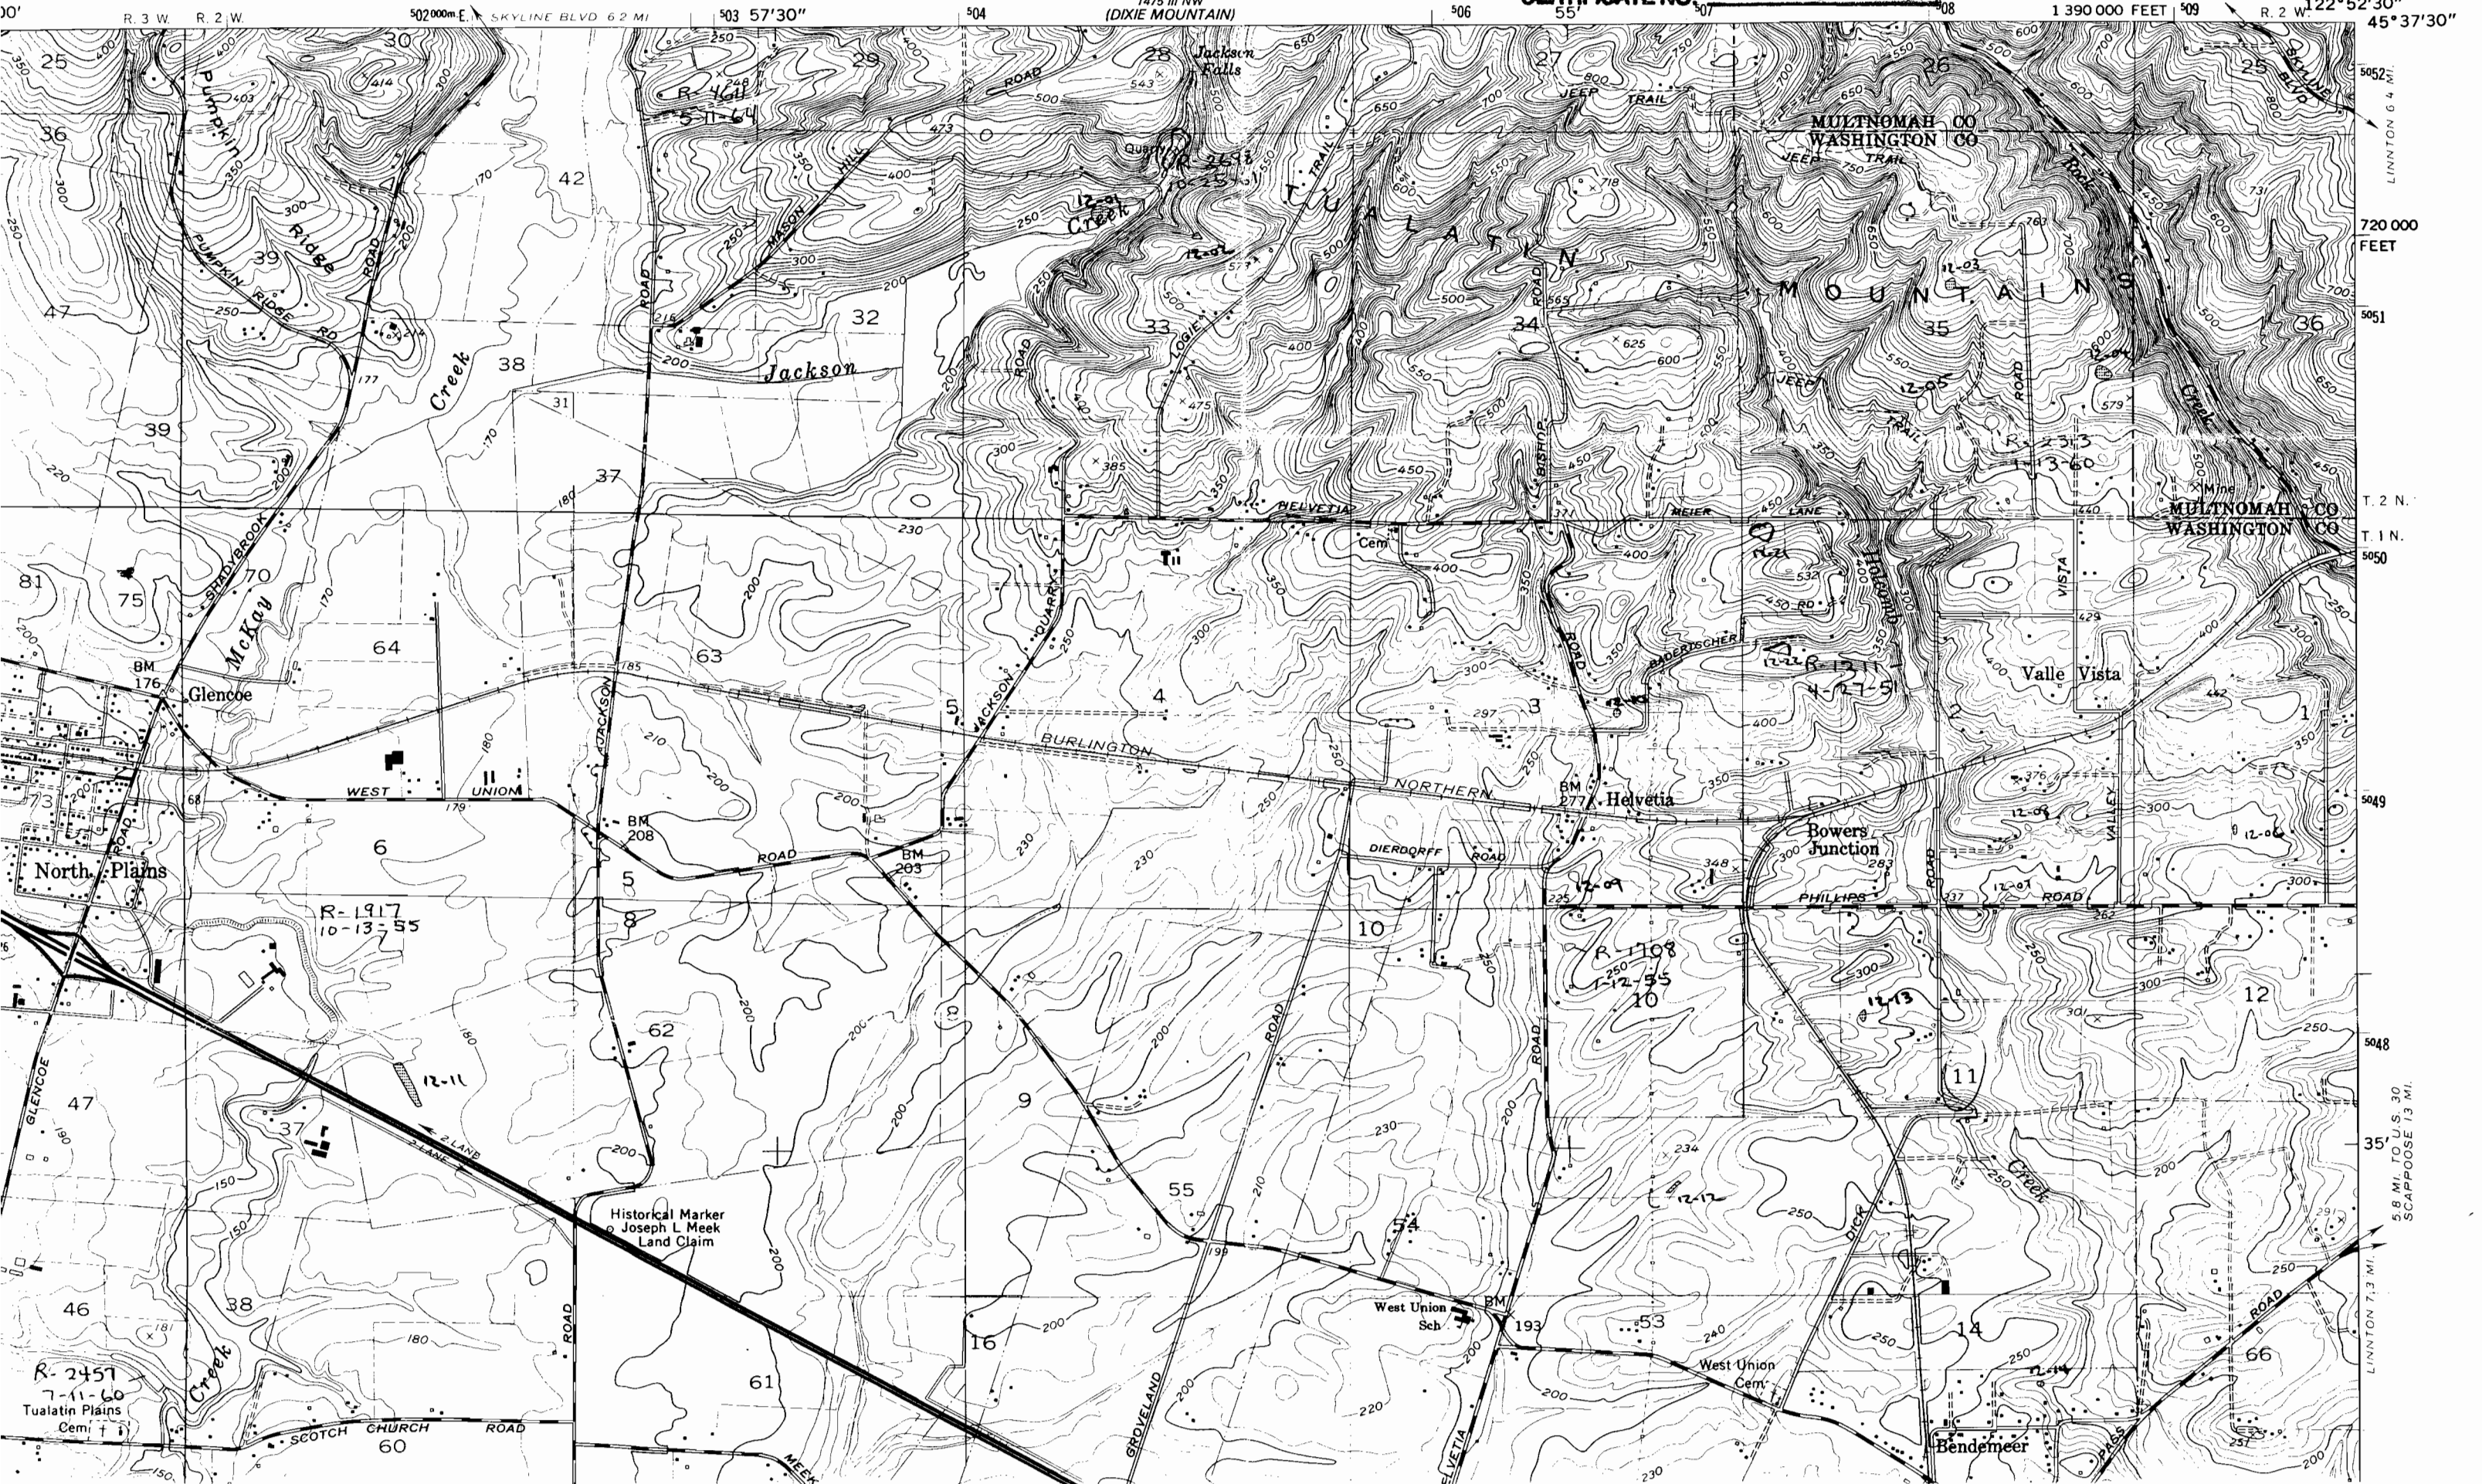

5052
720 000
FEET
5051
T. 2 N.
T. 1 N.
5050
5049
5048
35'
5.8 MI. TO U.S. 30
SCAPOOSE 13 MI.
LINLTON 7.3 MI.