



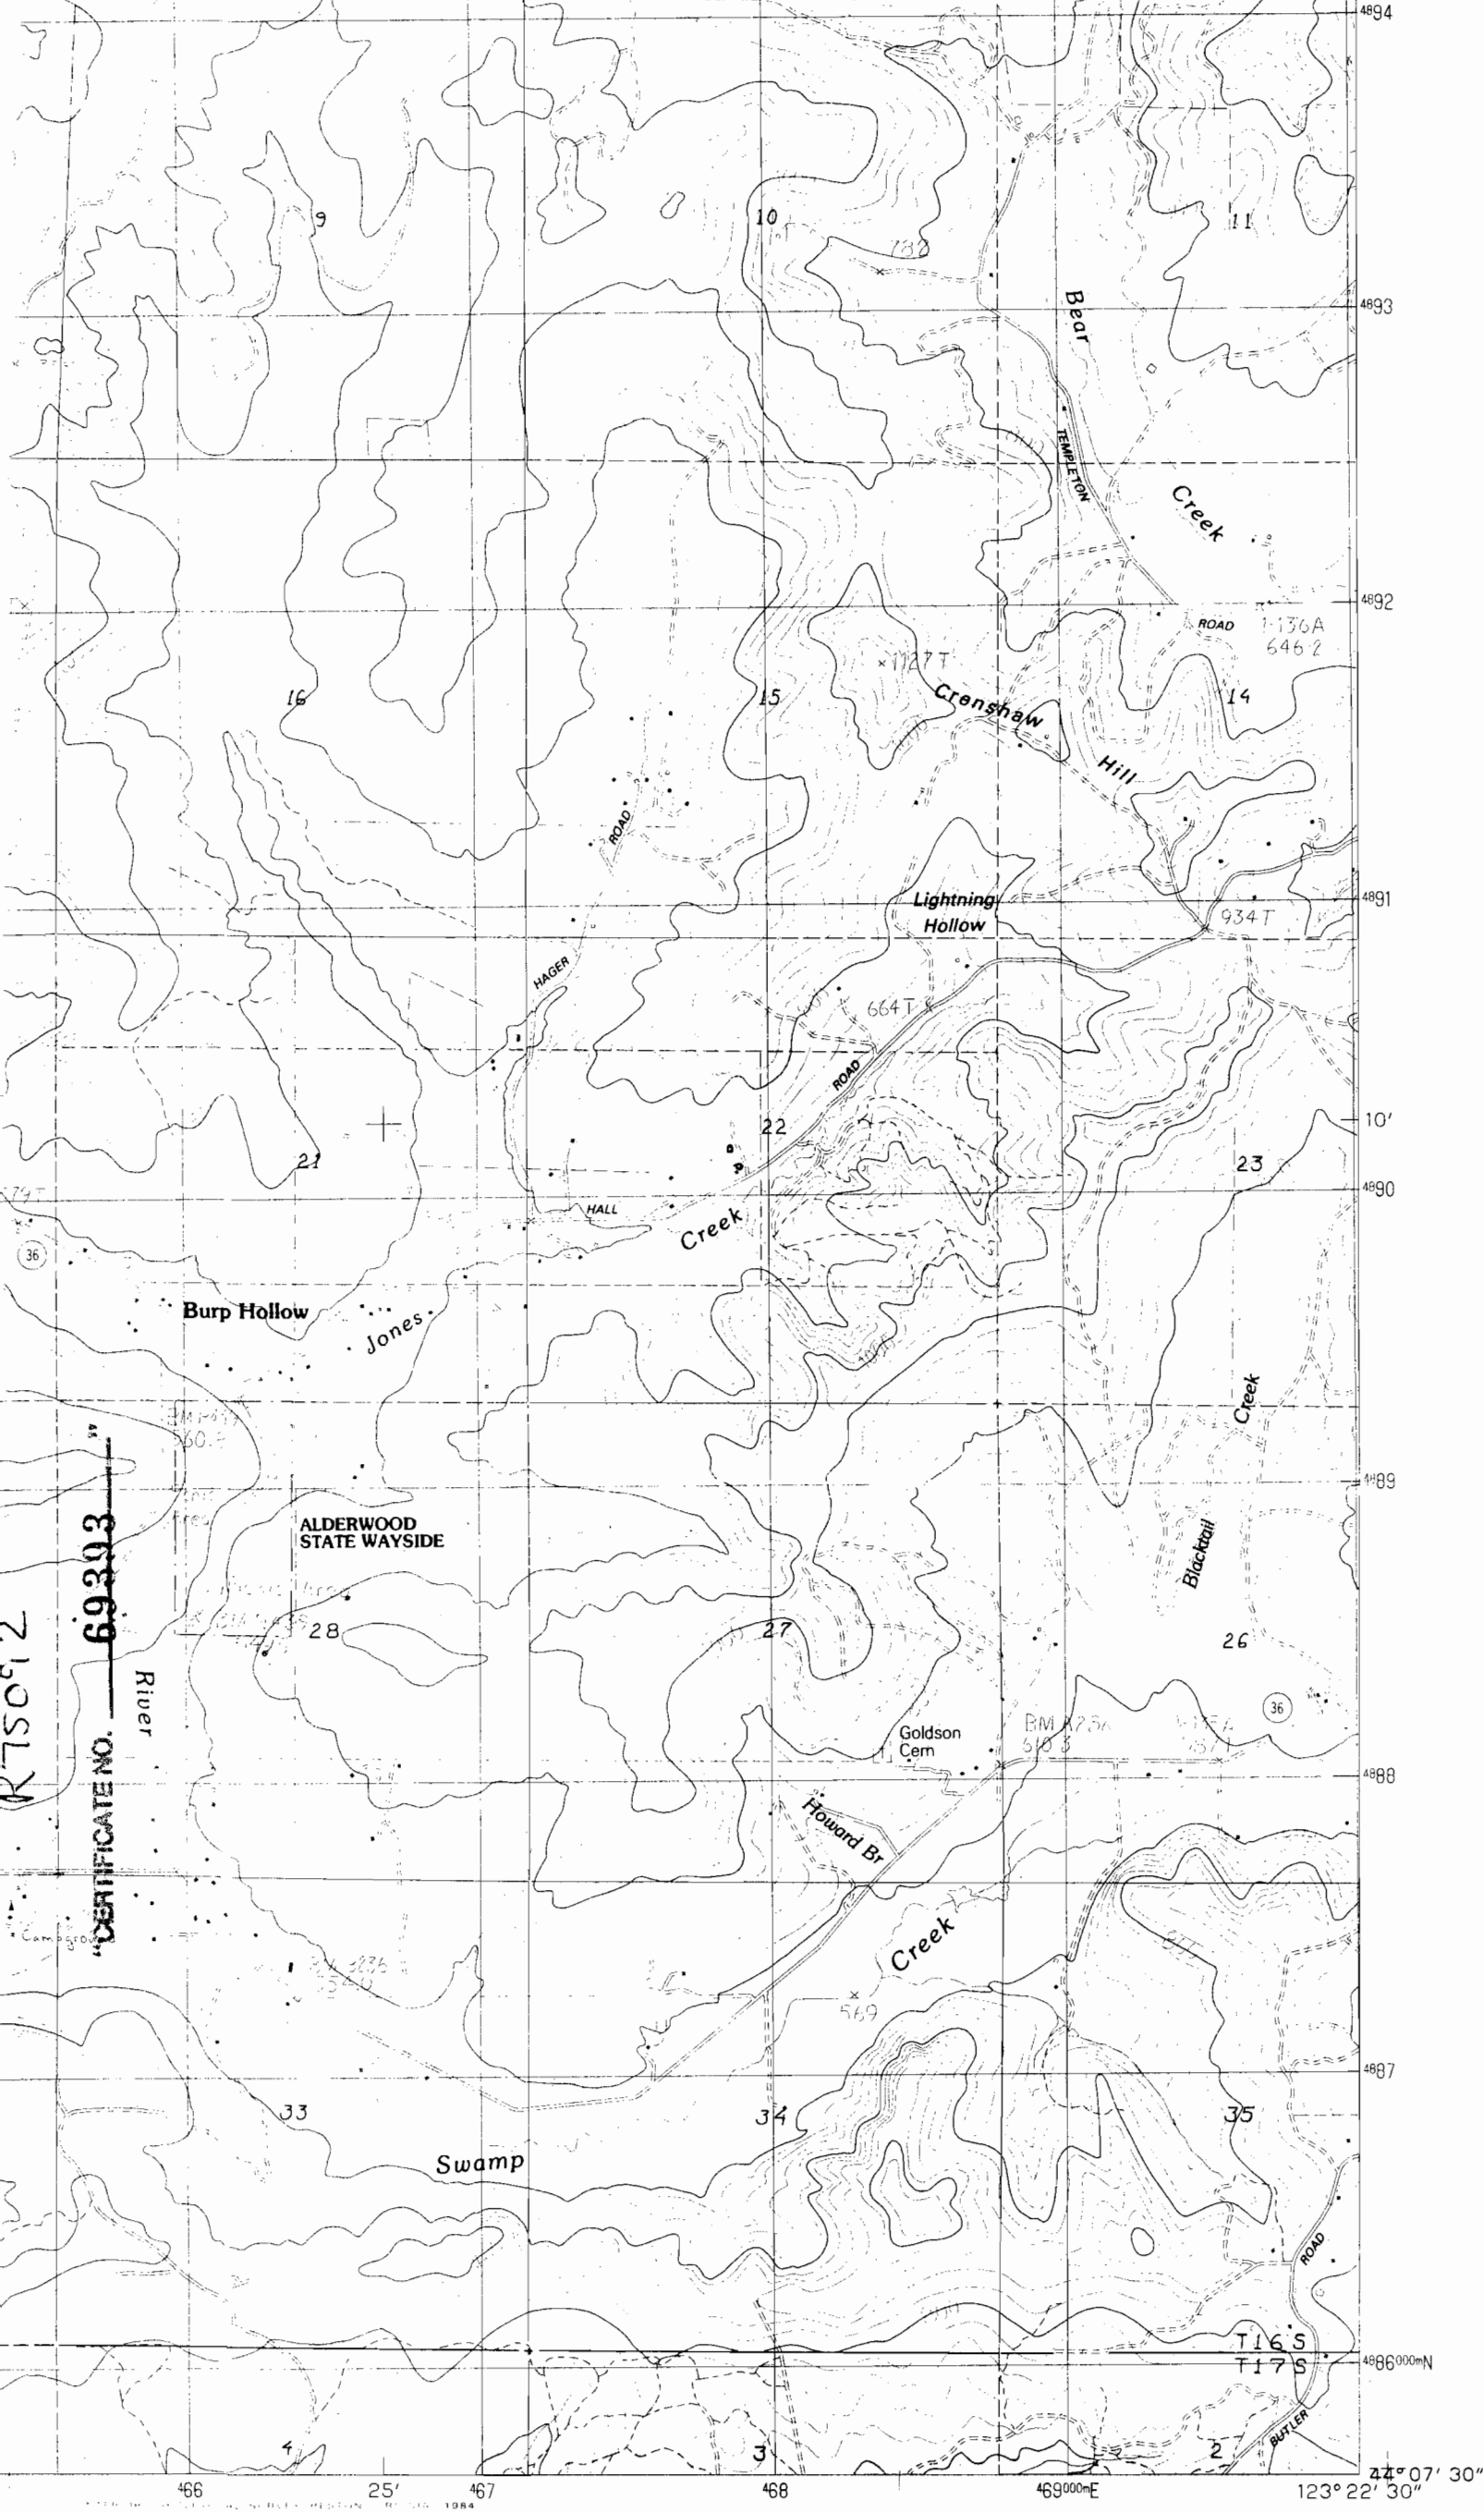

T R S
16 06 22
00400

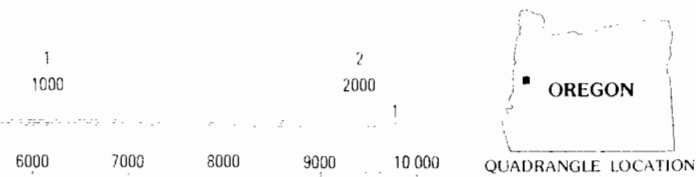

FEET
1000
2000
3000
4000
5000
6000
7000
8000
9000
10000

1	2	3	1 Prairie Peak
4		5	2 Glenbrook
6	7	8	3 Monroe
			4 Triangle Lake
			5 Cheshire
			6 Walton
			7 Nott
			8 Veneta

ADJOINING 7.5' QUADRANGLE NAMES

ROAD LEGEND

Improved Road.....
Unimproved Road.....
Trail.....
○ Interstate Route ○ U.S. Route ○ State Route

HORTON, OREG.

PROVISIONAL EDITION 1984

069-02

16 06 22 00400
T R S

ACCOUNT # 1229630 65902
HOUSE LAND

16-06-22

CERTIFICATE NO. 69393 R75092

1/4 Cor.

79.90 ch = 5273.40'

15

14

15

22

COUNTY ROAD NO. 428
1. N. 56°09'59"E. 51.49'
2. N. 22°35'42"E. 49.94'
3. LC = S. 48°40'21"W. 179.64'
4. LC = S. 39°22'50"W. 220.20'
5. LC = S. 69°31'10"W. 175.07'
6. LC = S. 64°59'11"W. 172.56'

SEE SURVEY N° 6863

SEE SURVEY N° 8628
AND SURVEY N° 17750

069-19

TOM

ROAD LONG

CREEK

1/4 Cor.

(N 00°05'E. 80.00 ch = 5280')

See Map 16 06 23

Prod 1 - 1st rain fed
L = 90' W = 75' D = 8.5'
Acre Feet = 7.51

Prod 2 - 2nd rain fed
(intermittent Nov - May)
L = 45' W = 23' D = 3.0' ac. ft.
Acre Feet = 0.224

SEE SURVEY N° 22893

Year-around spring and
300 gallon cistern.
Source of household drinking
water. Year-around
surface water runoff.

When it is only dry in winter
and dry season, otherwise, there
is zero surface water runoff.

SCALE 1:9600

See Map 16 06 21

COUNTY ROAD NO. 1013

(N 00°20'E. 80.00 ch = 5280')

1/4 COR.

EAST
200'
NORTH
200'
WEST

ROAD

401

LOG POND HALL

600

601

N. 89°14'W. - 620.8'