


IDENTIFICATION NO.

69396 R75130

7  
1475 III NW  
(DIXIE MOUNTAIN)

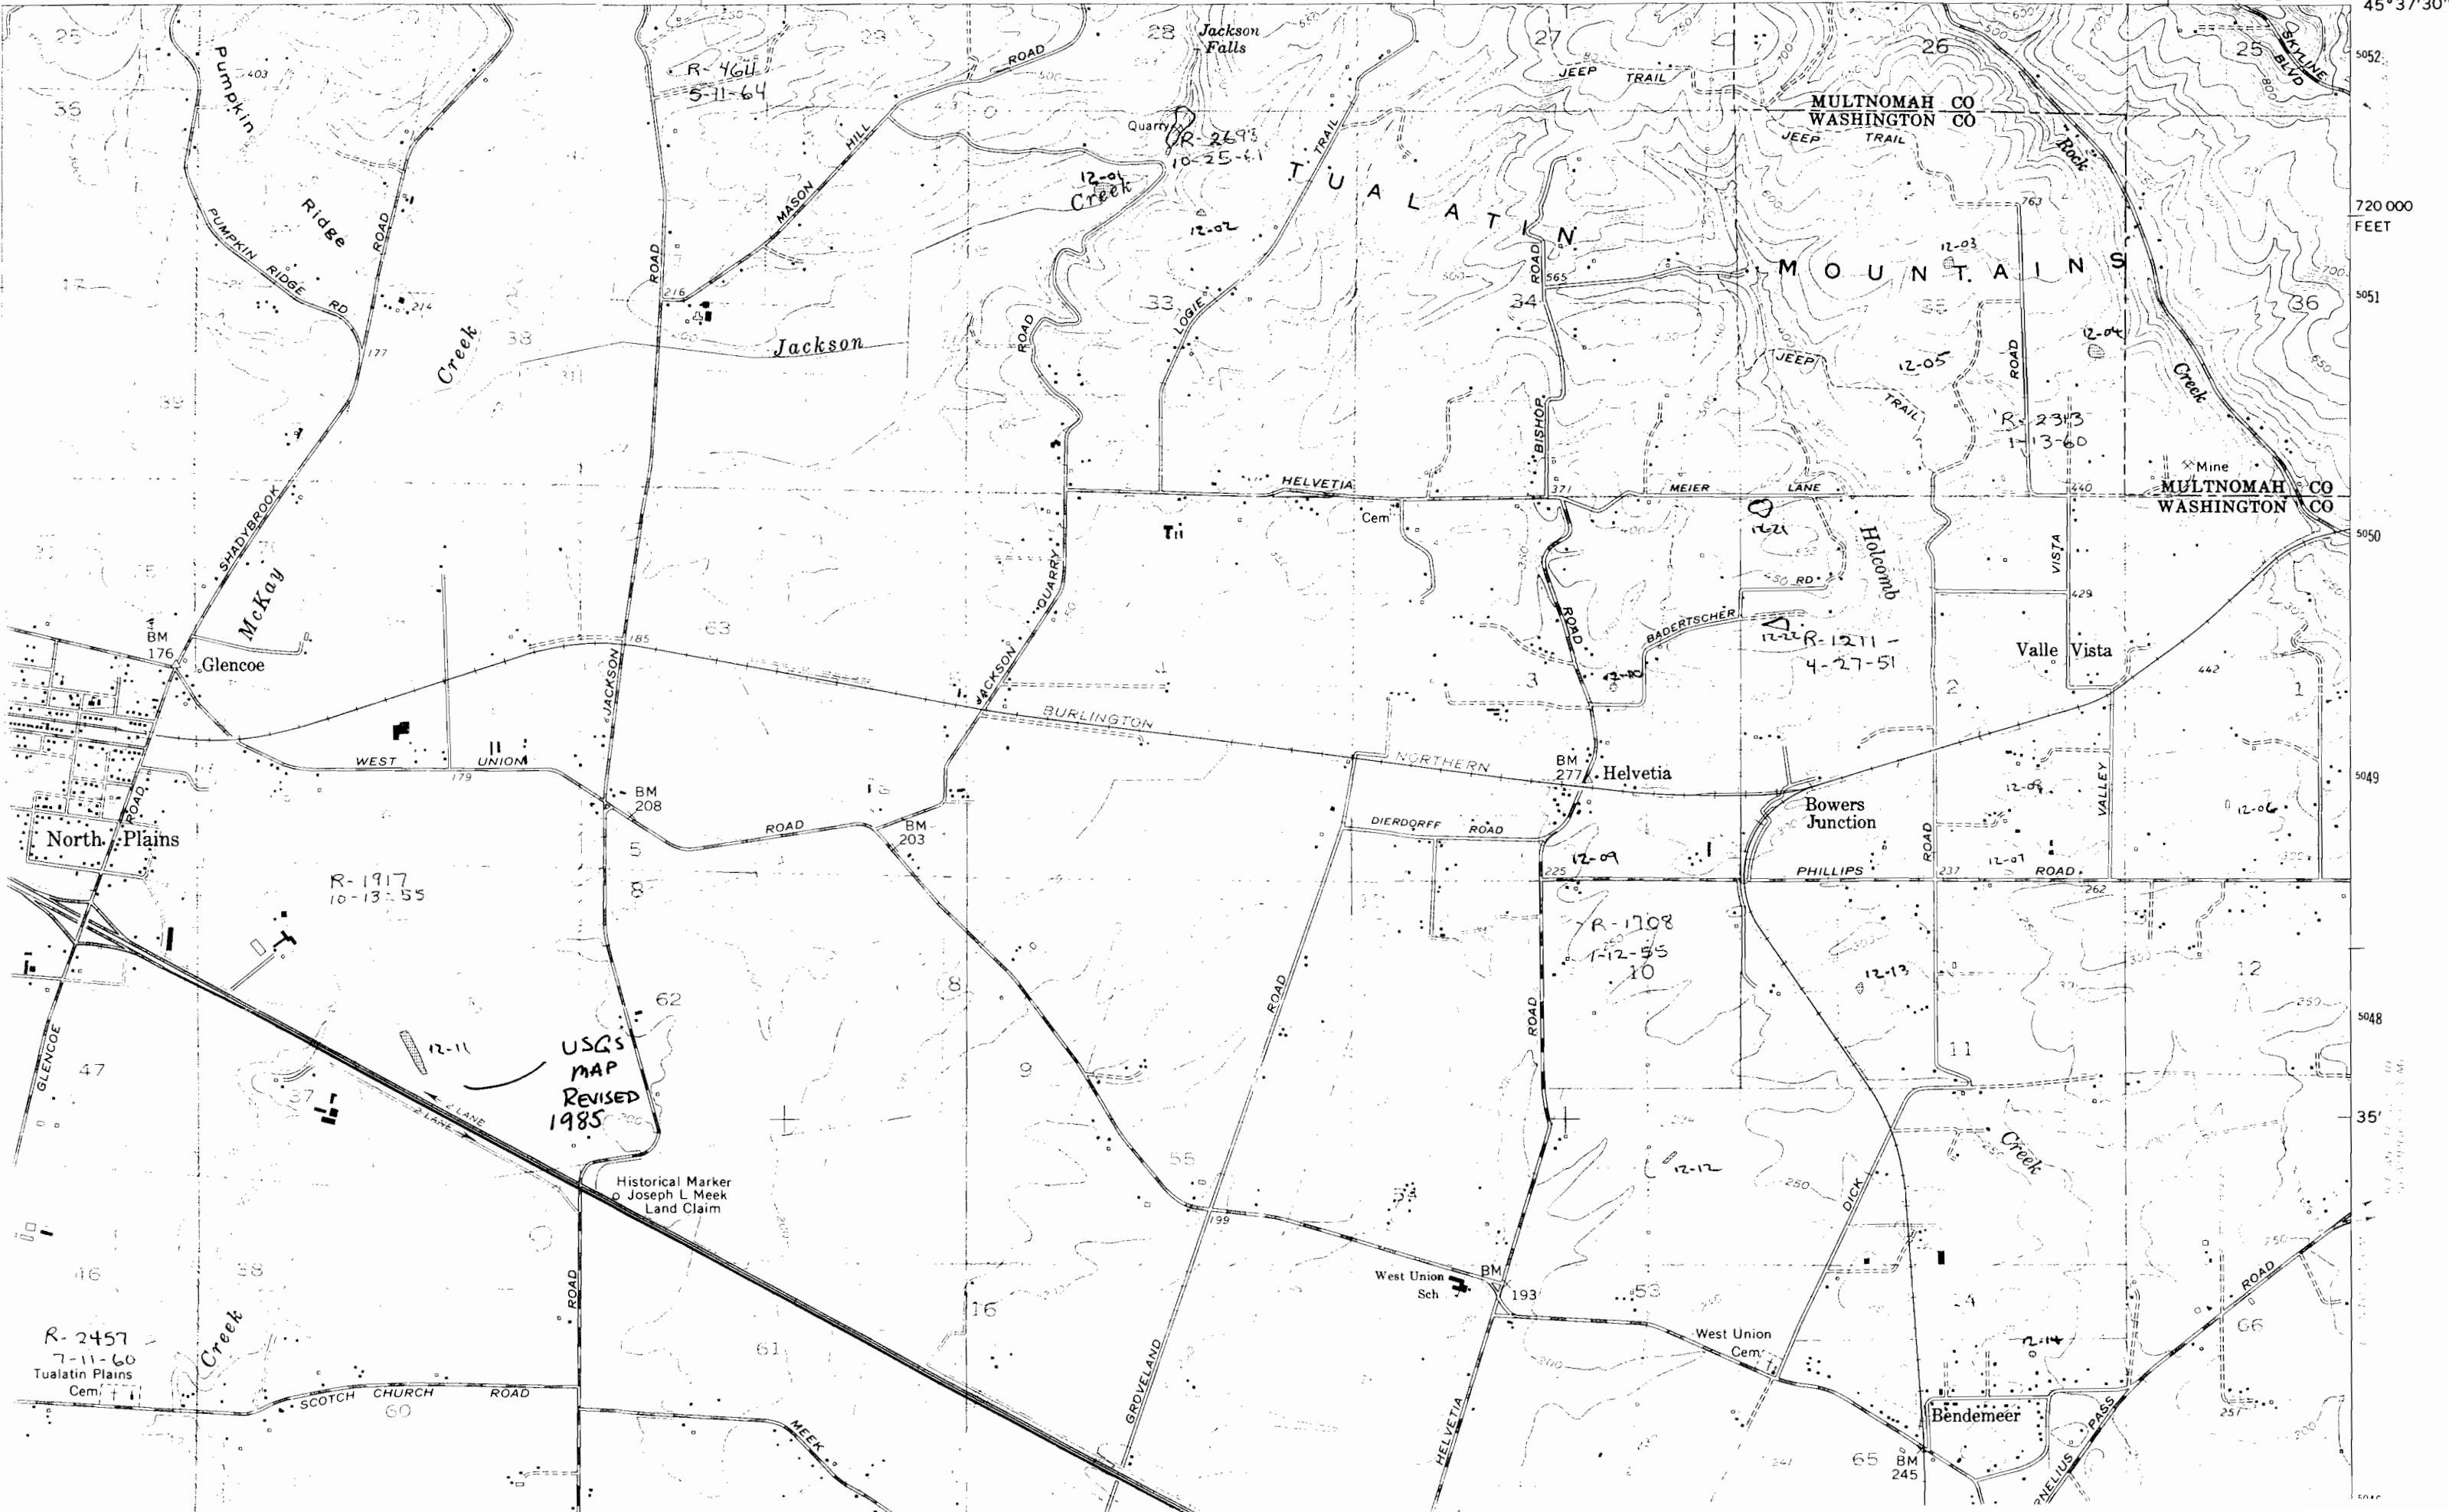

R-2457  
7-11-60  
Tualatin Plains  
Cem.

R-1917  
10-13-55

USGS  
MAP  
REVISED  
1985

Historical Marker  
of Joseph L Meek  
Land Claim

R-1708  
1-12-55  
10

R-2313  
1-13-60

R-1211  
4-27-51

R-4611  
5-11-64

12-01  
Creek

12-03

12-05

12-04

12-02

12-07

12-08

