

WASHINGTON CO
YAMHILL CO

LAURELWOOD, OR
1956

R 15134

69400

16 Bald Peak
MAM 1629

BALD PEAK
STATE PARK

Microwave
Sta

YCOMB
RD
31
MILL
32

Hill Cem
Hill School
Creek
42

218
41

18
57
BM 183

Iowa Hill

Laurelwood
LANDING
49
Sewage Disposal
Laurelwood Academy

R-1199
11-10-30

48
ROAD
Quarry

17

14
15
BM 1114

9
8
7
6
5
4
3
2
1

56
1000
900
800
700
600
500
400
300
200
100
0

16

511-3 TL 770

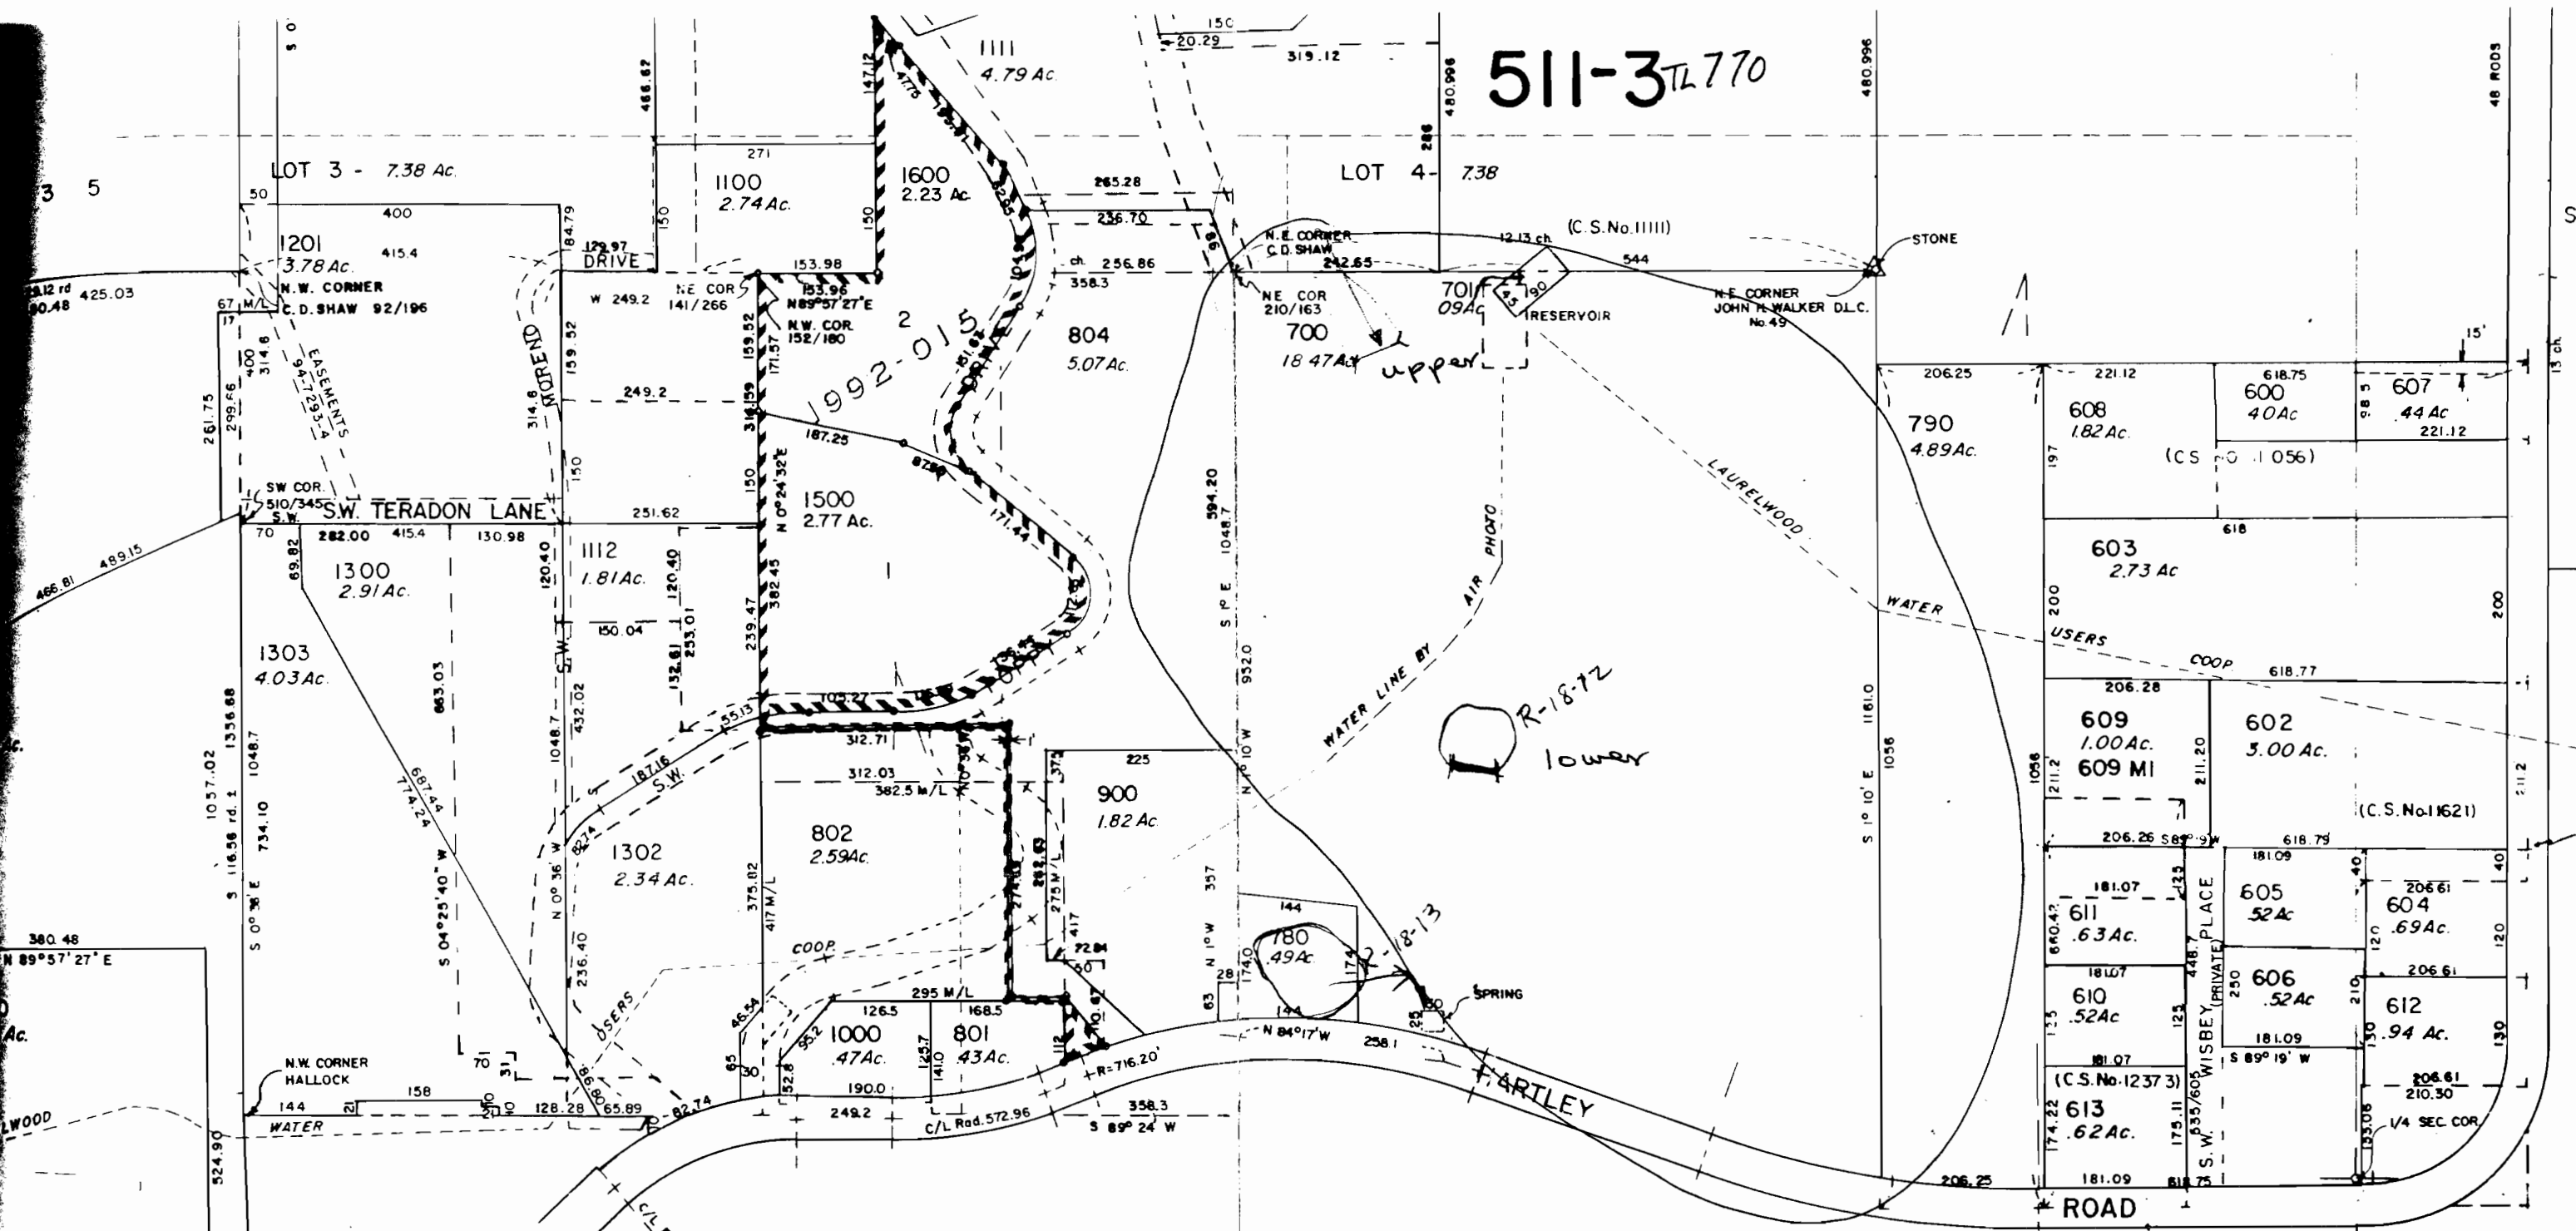

SEE MAP 2S 3 5DB

SEE MAP 2S 3 5

SEE MAP 2S 3 4C

FOR ASSESSMENT PURPOSES ONLY
DO NOT RELY ON FOR ANY OTHER USE

"CERTIFICATE NO. 69400"

R75134

2S 3 5A

2S

DEPT
ASSESSMENT