SEC.08 TWP.8S. RGE.1E. WM
MARION COUNTY, OREGON

8 1E 08

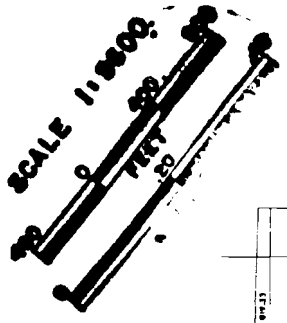

RECEIVED
DEC 5 1994
WATER RESOURCES DEP
SALEM, OREGON

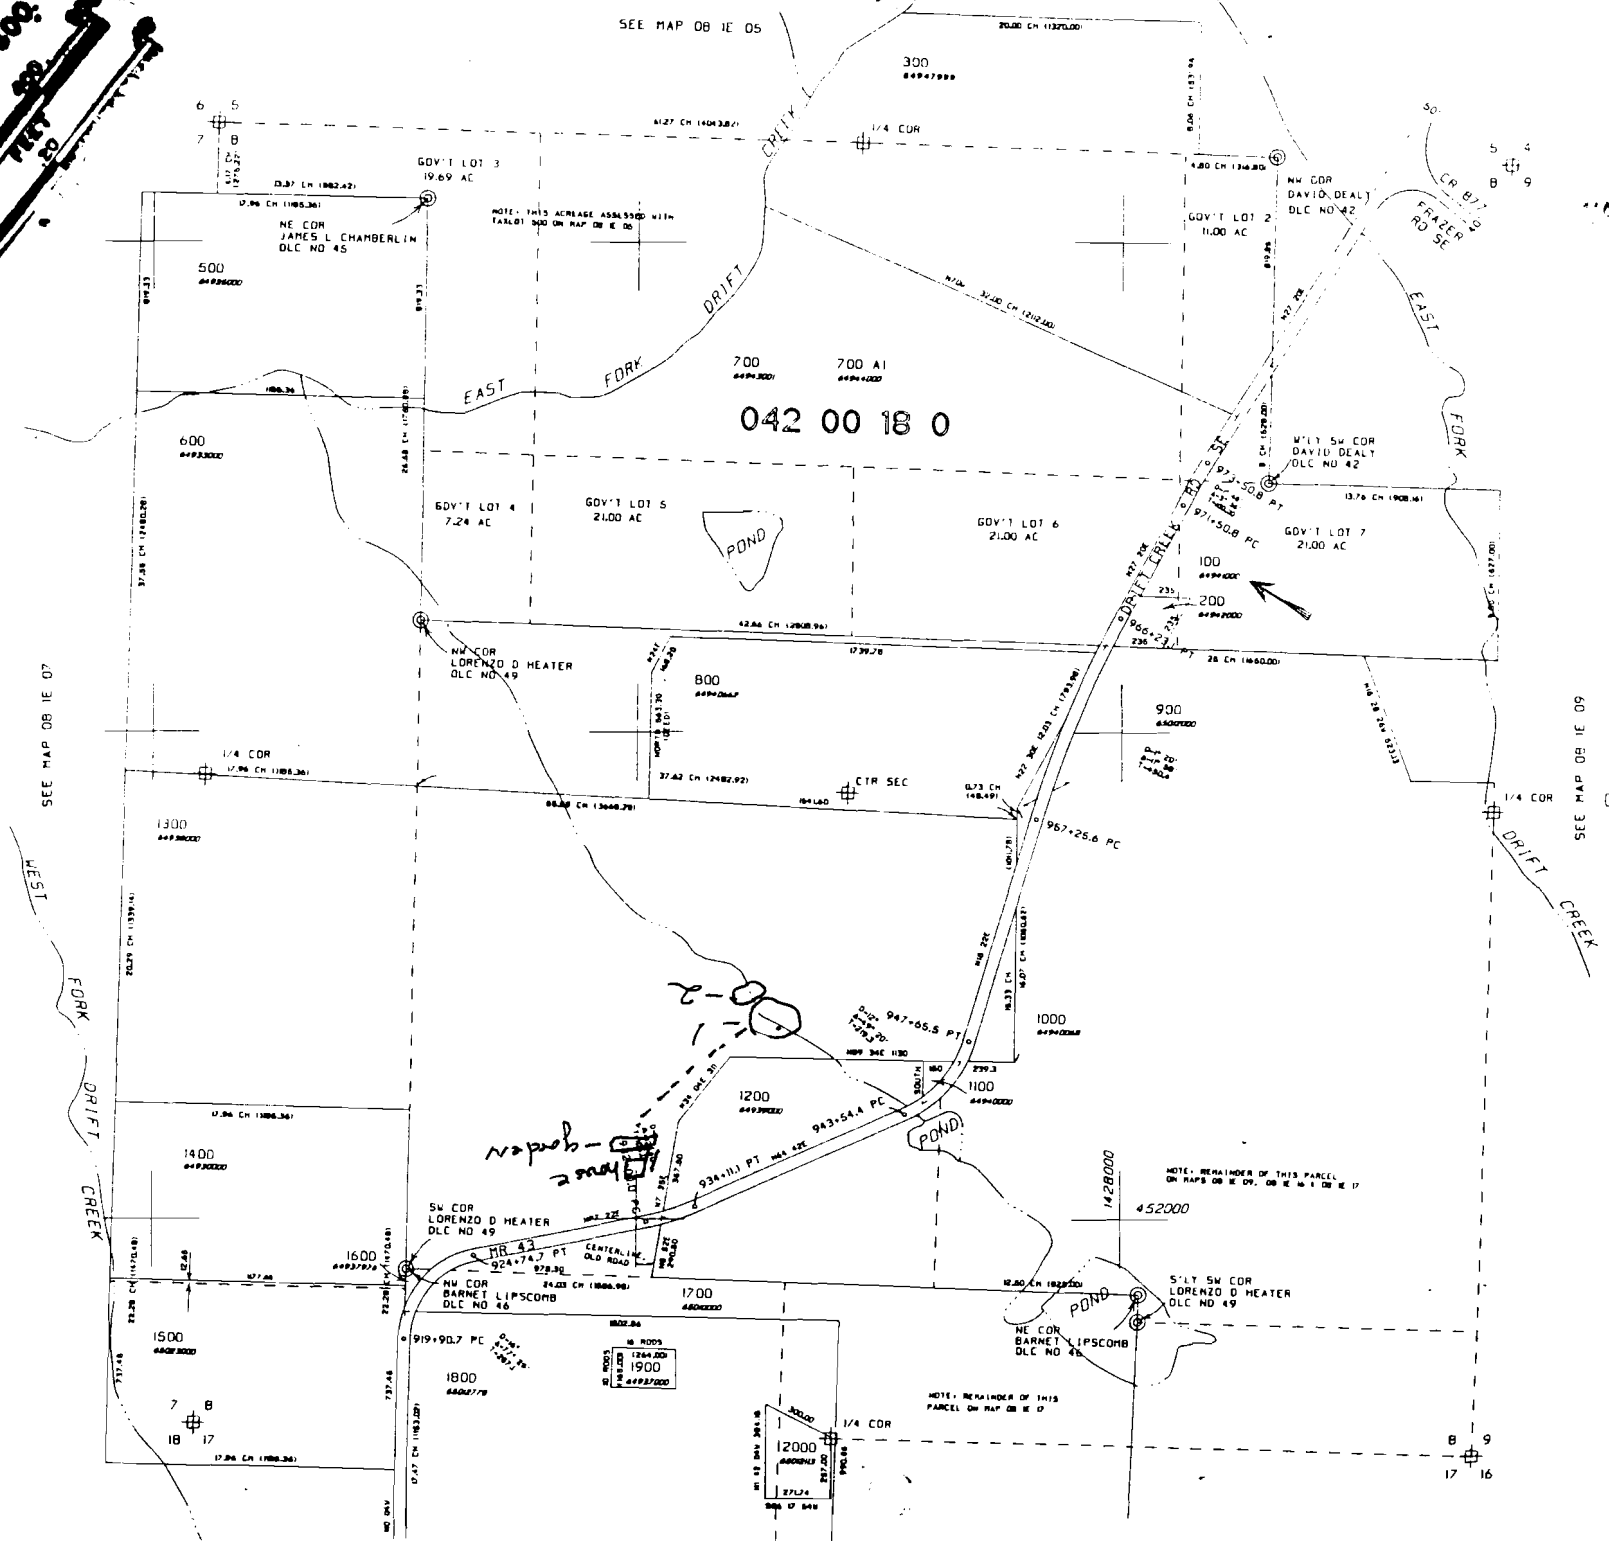

R75210