

R75213


CERTIFICATE NO. 69411



Fidelity National Title Co. of Oregon

The sketch below is made solely for the purpose of assisting in locating said premises and the Company assumes no liability for variations, if any, in dimensions and location ascertained by actual survey.

2N219

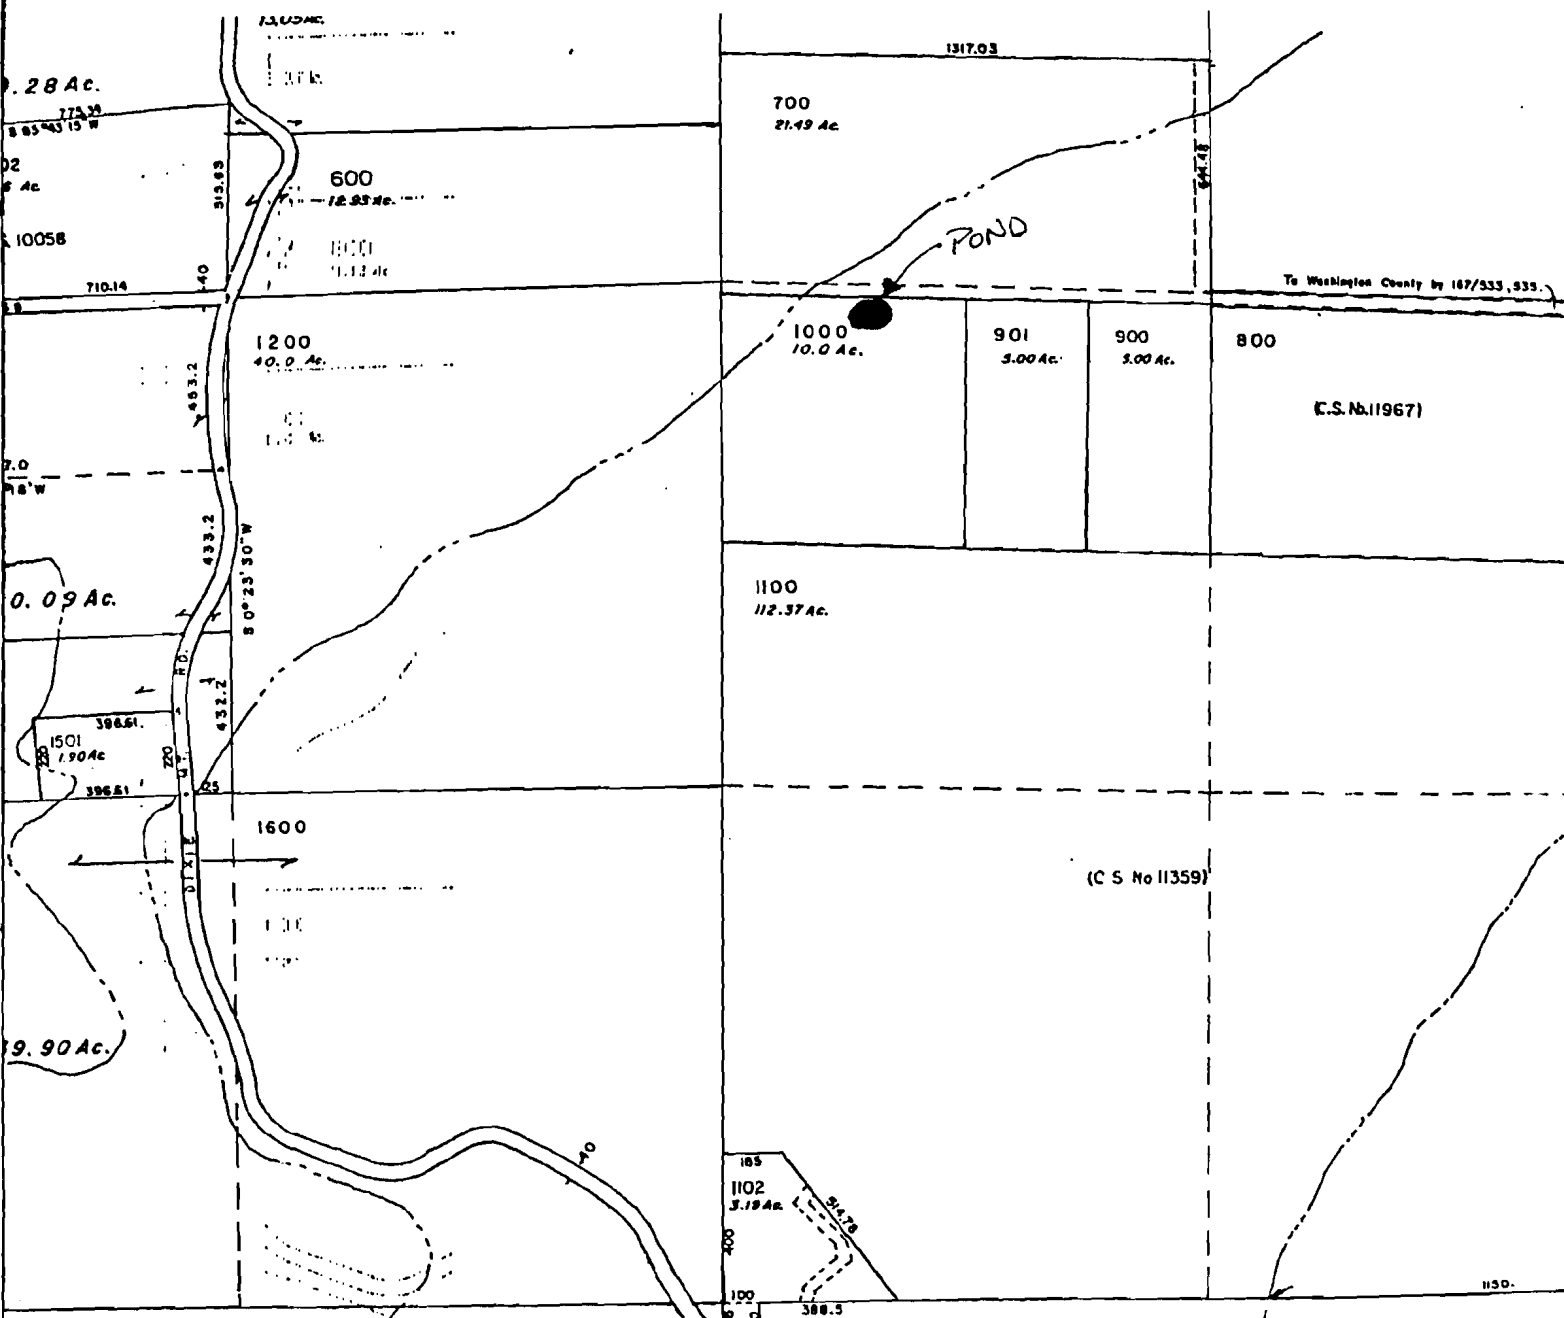

SEE MAP 2N230

FOR ASSESSMENT PURPOSES ONLY  
DO NOT RELY ON FOR ANY OTHER USE