

10-26-94
PROPER & LATEST DRAWING

R75239

H132153

R75239

SEE


MAR 35
69435

CERTIFICATE NO.

RECEIVED

DEC - 5 1994

WATER RESOURCES DEPT
SALEM, OREGON

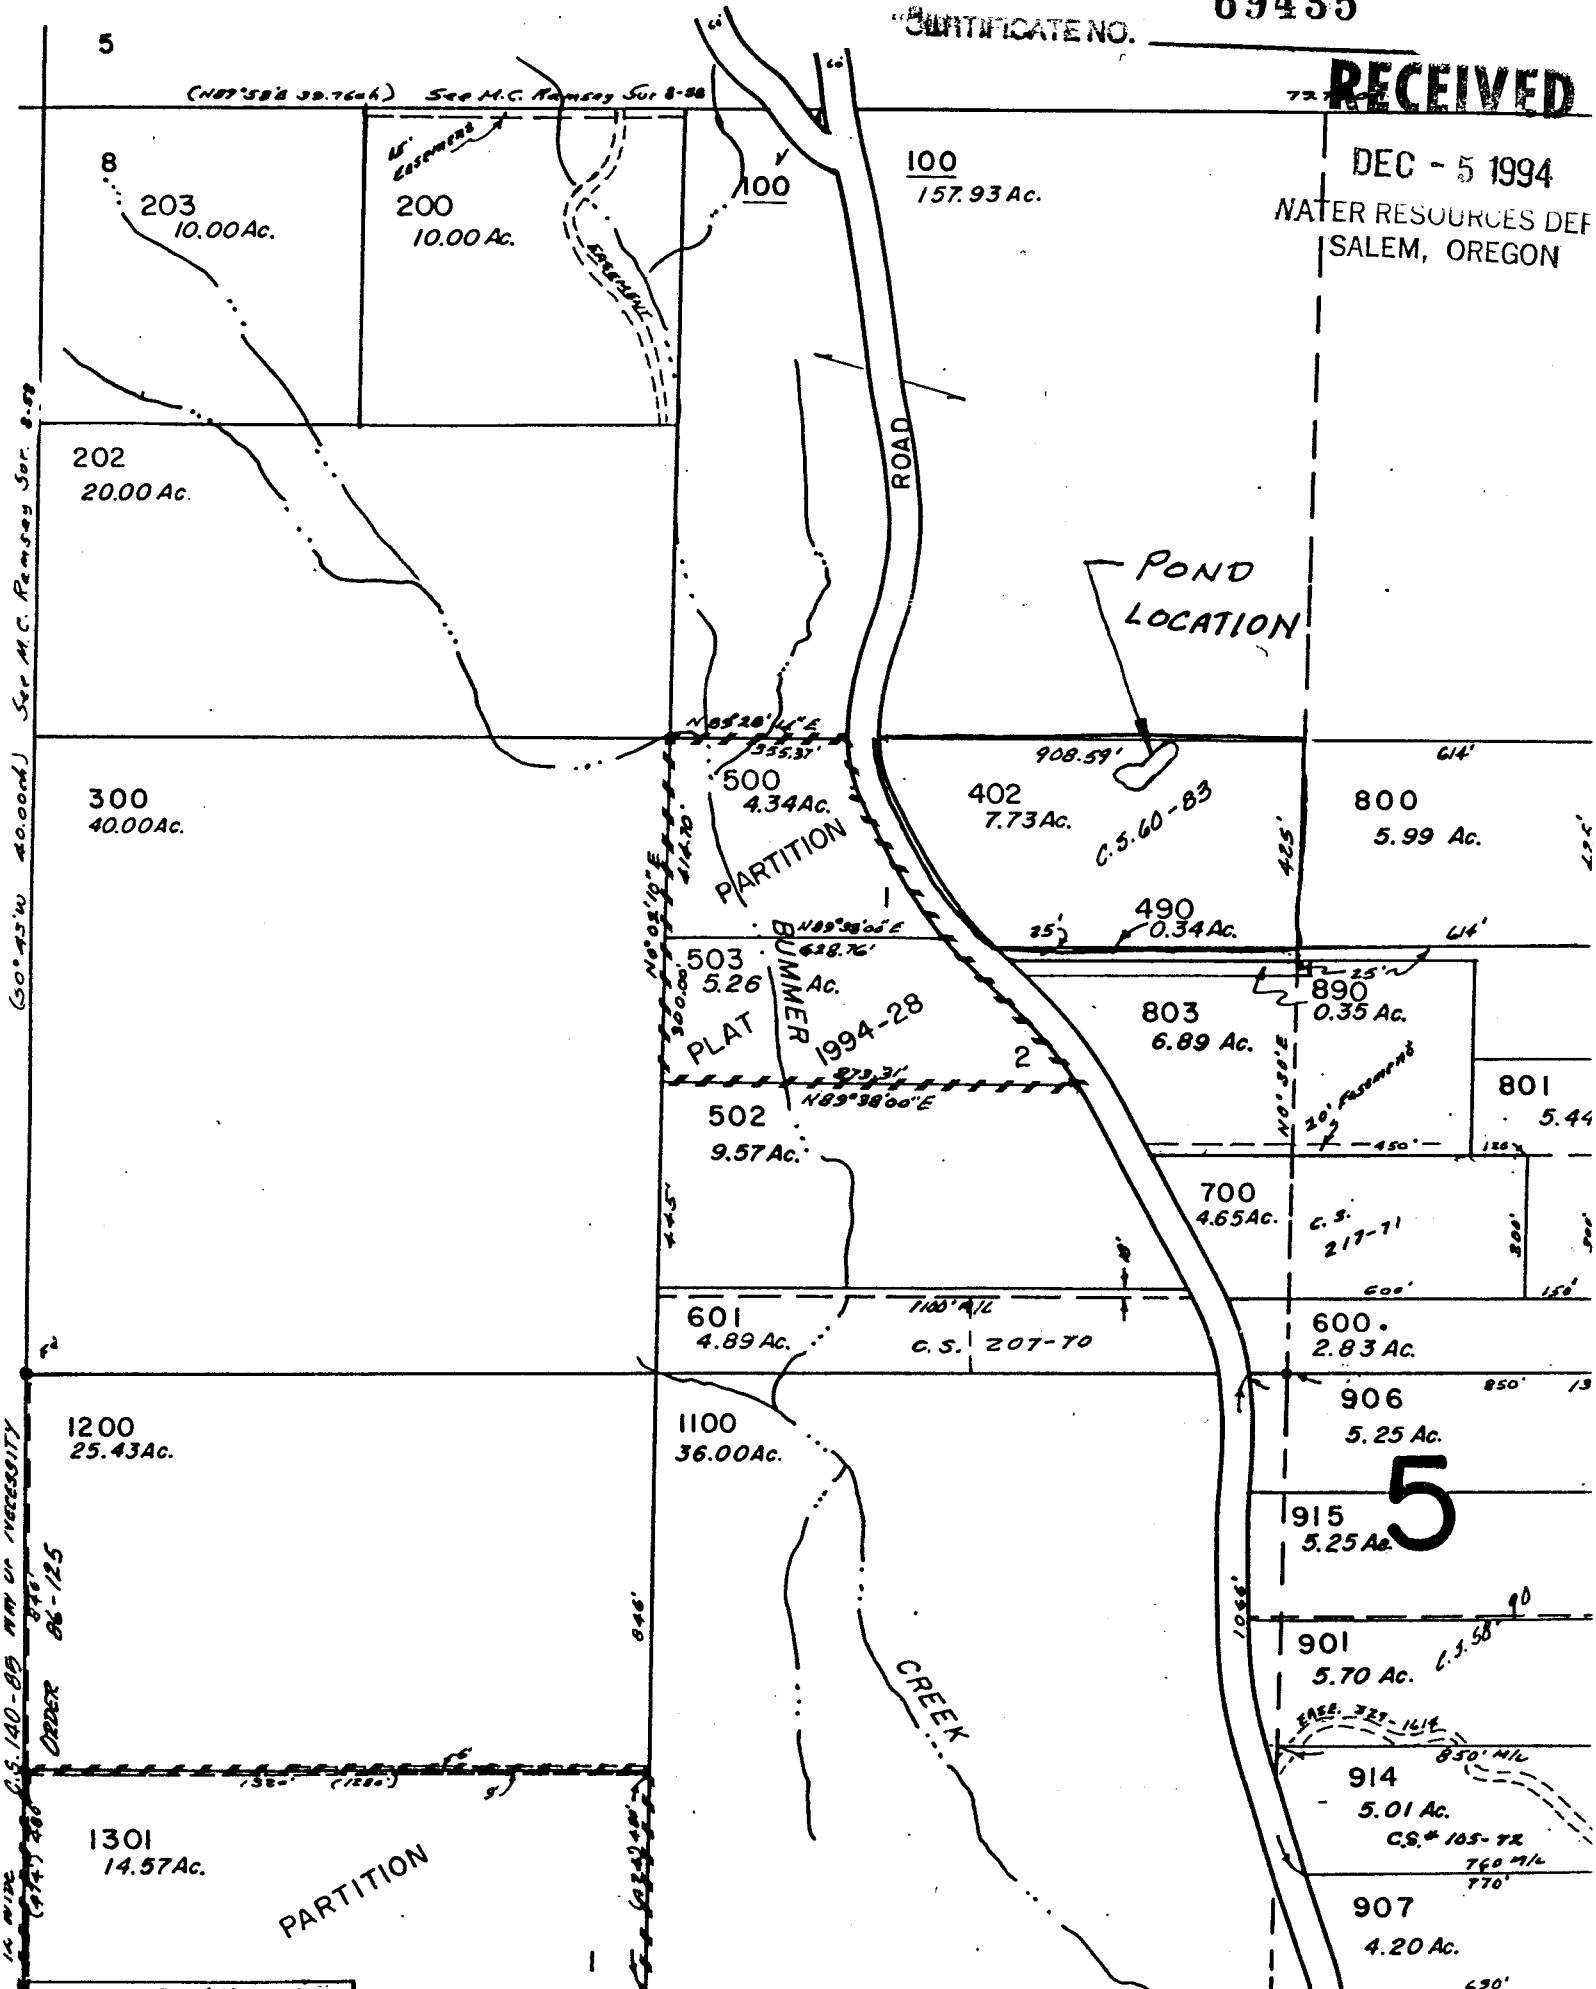

See M.C. Ramsey Sur. 8-89

1/4 MILE
C.S. 140-89
ORDER 86-125

5