


Range 2W Township 35 see 15

SCALE 1:24 000

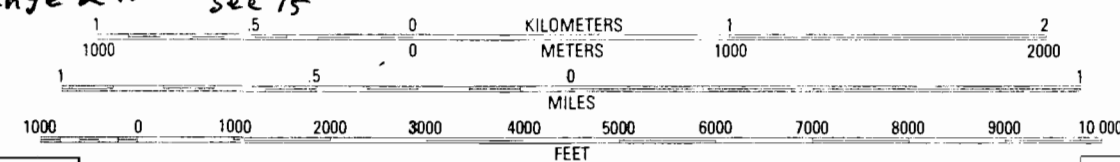

QUADRANGLE LOCATION

1	2	3	1 Skeleton Mtn.
			2 Cleveland Ridge
			3 Trail
4		5	4 McConville Peak
			5 Shady Cove
			6 Gold Hill
6	7	8	7 Sams Valley
			8 Eagle Point

ADJOINING 7.5' QUADRANGLE NAMES

ROAD LEGEND

- Improved Road.....
- Unimproved Road.....
- Trail.....
- Interstate Route ○ U.S. Route ○ State Route

PROVISIONAL MAP
 Produced from original
 manuscript drawings. Infor-
 mation shown as of date of
 check. 3

CERTIFICATE NO. **69440**
 To convert feet to meters multiply by 0.3048

THIS MAP COMPLIES WITH NATIONAL MAP ACCURACY STANDARDS
 FOR SALE BY U. S. GEOLOGICAL SURVEY, DENVER, COLORADO 80225, OR RESTON, VIRGINIA 22092

BOSWELL MTN., OREG.
 PROVISIONAL EDITION 1983

42122-E8-TF-024

Jackson Co. Oregon

R75244

RECEIVED
 DEC - 5 1994
 WATER RESOURCES DEPT.
 SALEM, OREGON