

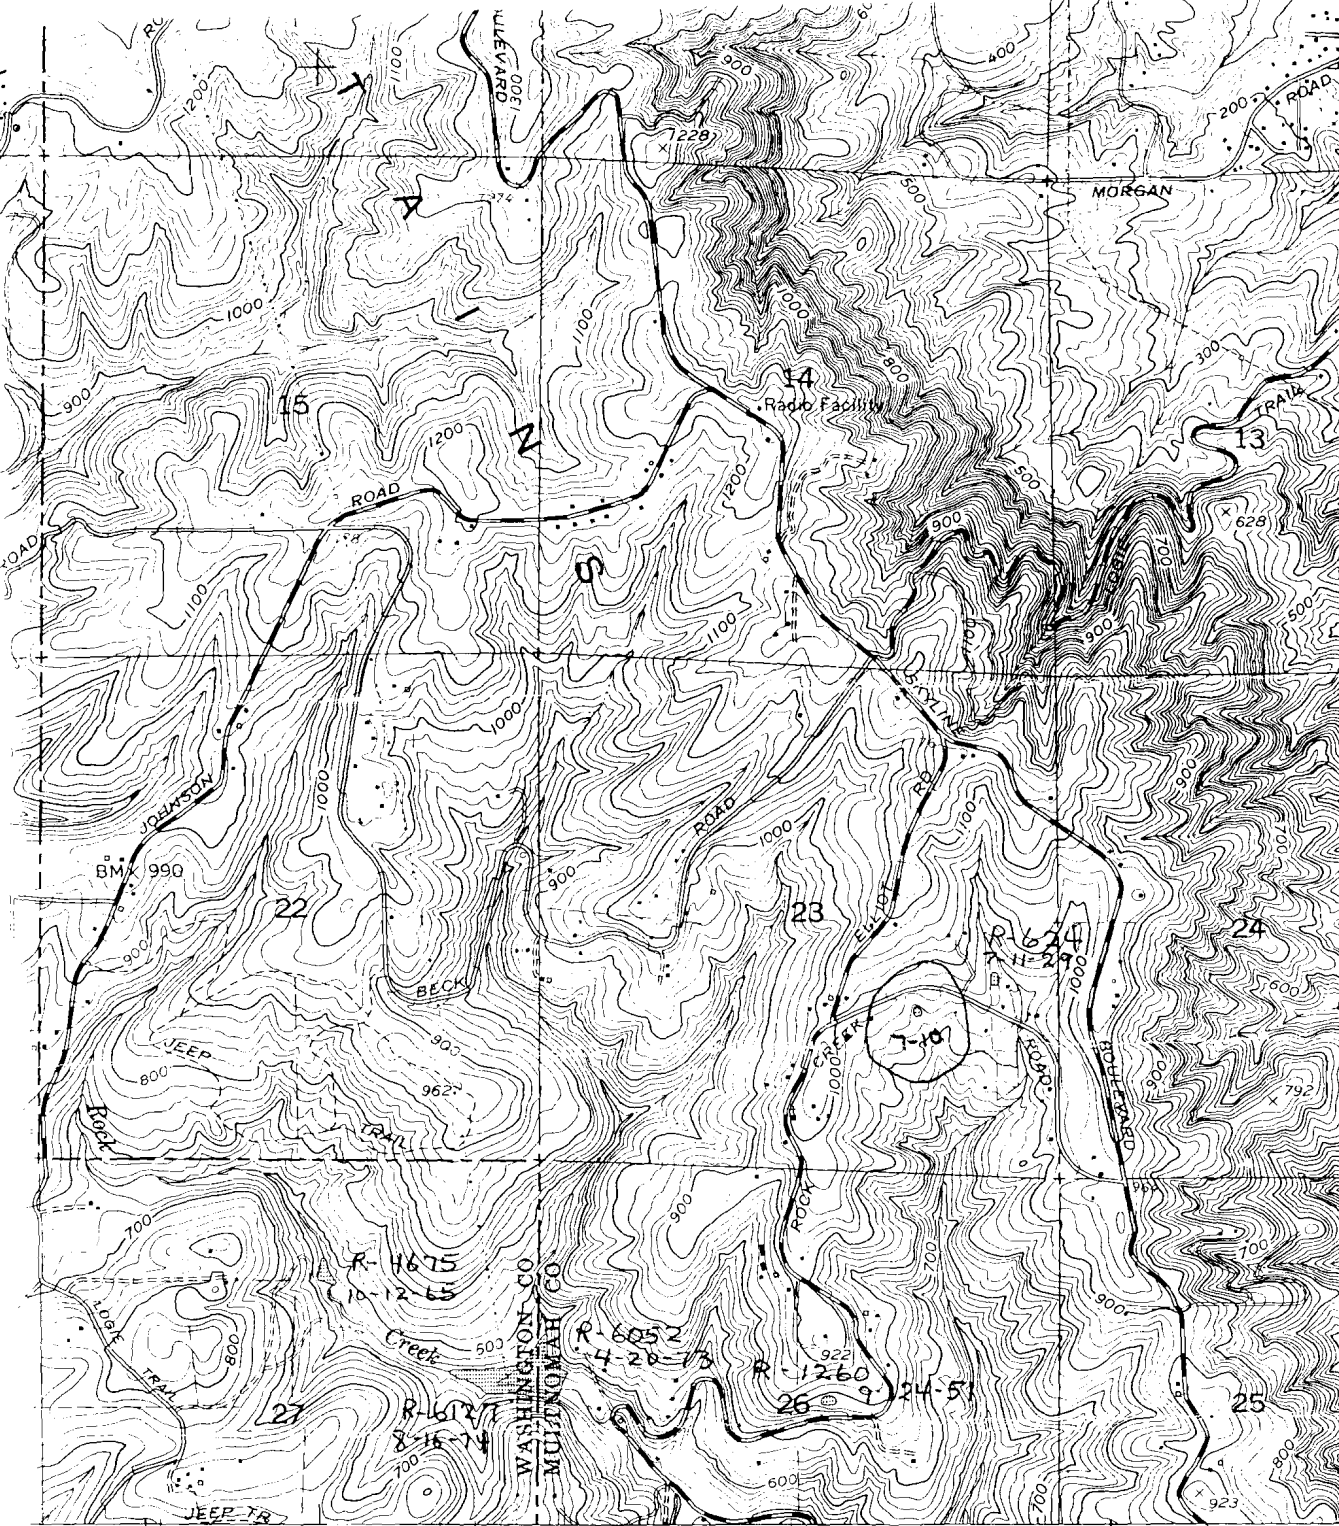


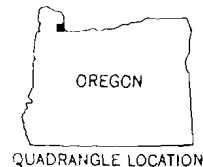

5057  
40'  
5055  
5054  
5053000m N.

45°37'30"  
122°52'30"  
**13**  
(LXNYTON)  
1475 III SE

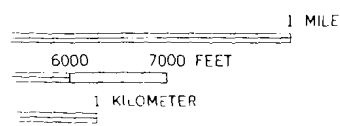

ROAD CLASSIFICATION

|             |       |                 |           |
|-------------|-------|-----------------|-----------|
| Heavy-duty  | ————— | light-duty      | - - - - - |
| Medium-duty | ————— | Unimproved dirt | - - - - - |
|             | ⬢     | U. S. Route     |           |

STANDARDS  
OR RESTON, VIRGINIA 22092  
TABLE ON REQUEST

**DIXIE MOUNTAIN, OREG.**  
NW/4 HILLSBORO 15' QUADRANGLE  
45122-F8-TF-024

1961  
PHOTOREVISED 1985  
DMA 1475 III NW-SERIES V892

00451

R75246